

under the


Shelter Deck Rules.

ory.

ARD REPORT on the Proposed 370 ft Motor Oil Tanker for the Rotterdam Dry Dock Co. submitted by the Millen System of Ship Construction Ltd.

It is submitted the Freeboards given on the accompanying form being those required by the Tables merit approval, subject to the particulars and dimensions now supplied being verified on completion.

The freeboards have been computed on a corrected tonnage coefficient of .78 and are subject to alteration if found necessary.

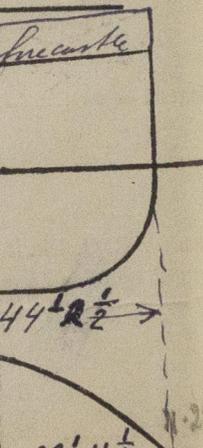

W.D. J.W.B.
23 5 23

Preliminary A. 255-23

© 2020 Lloyd's Register Foundation
W446-0261