
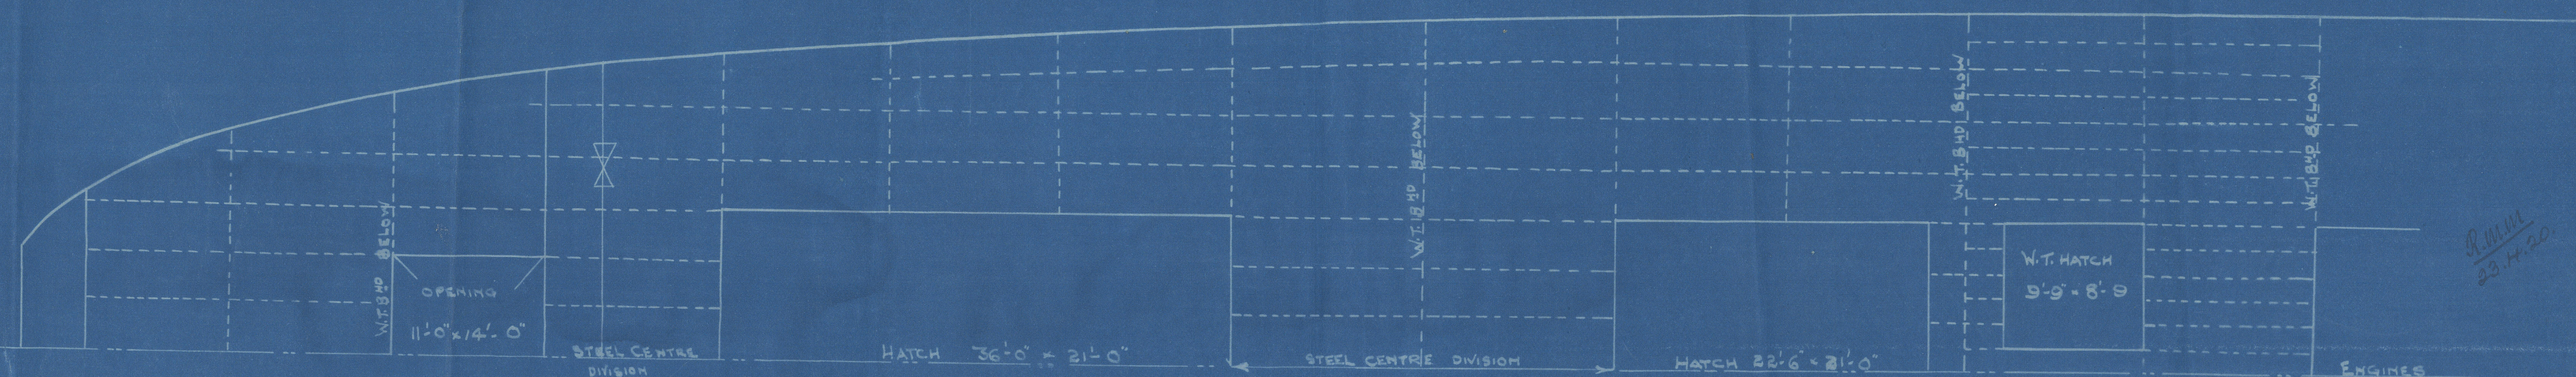
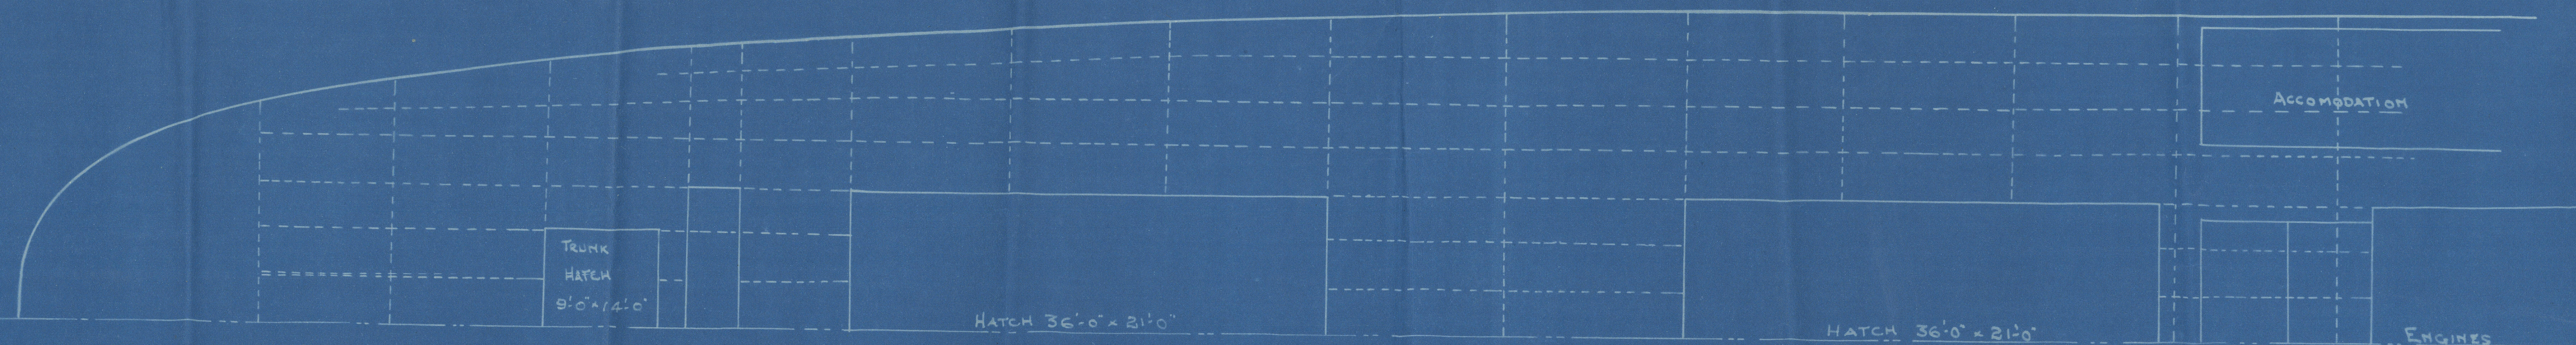


23-4-20

PROFILE & DECK PLAN (AFTER END)

S.S. 413-414.

SCALE $\frac{1}{8}$ " = 1 FOOT.

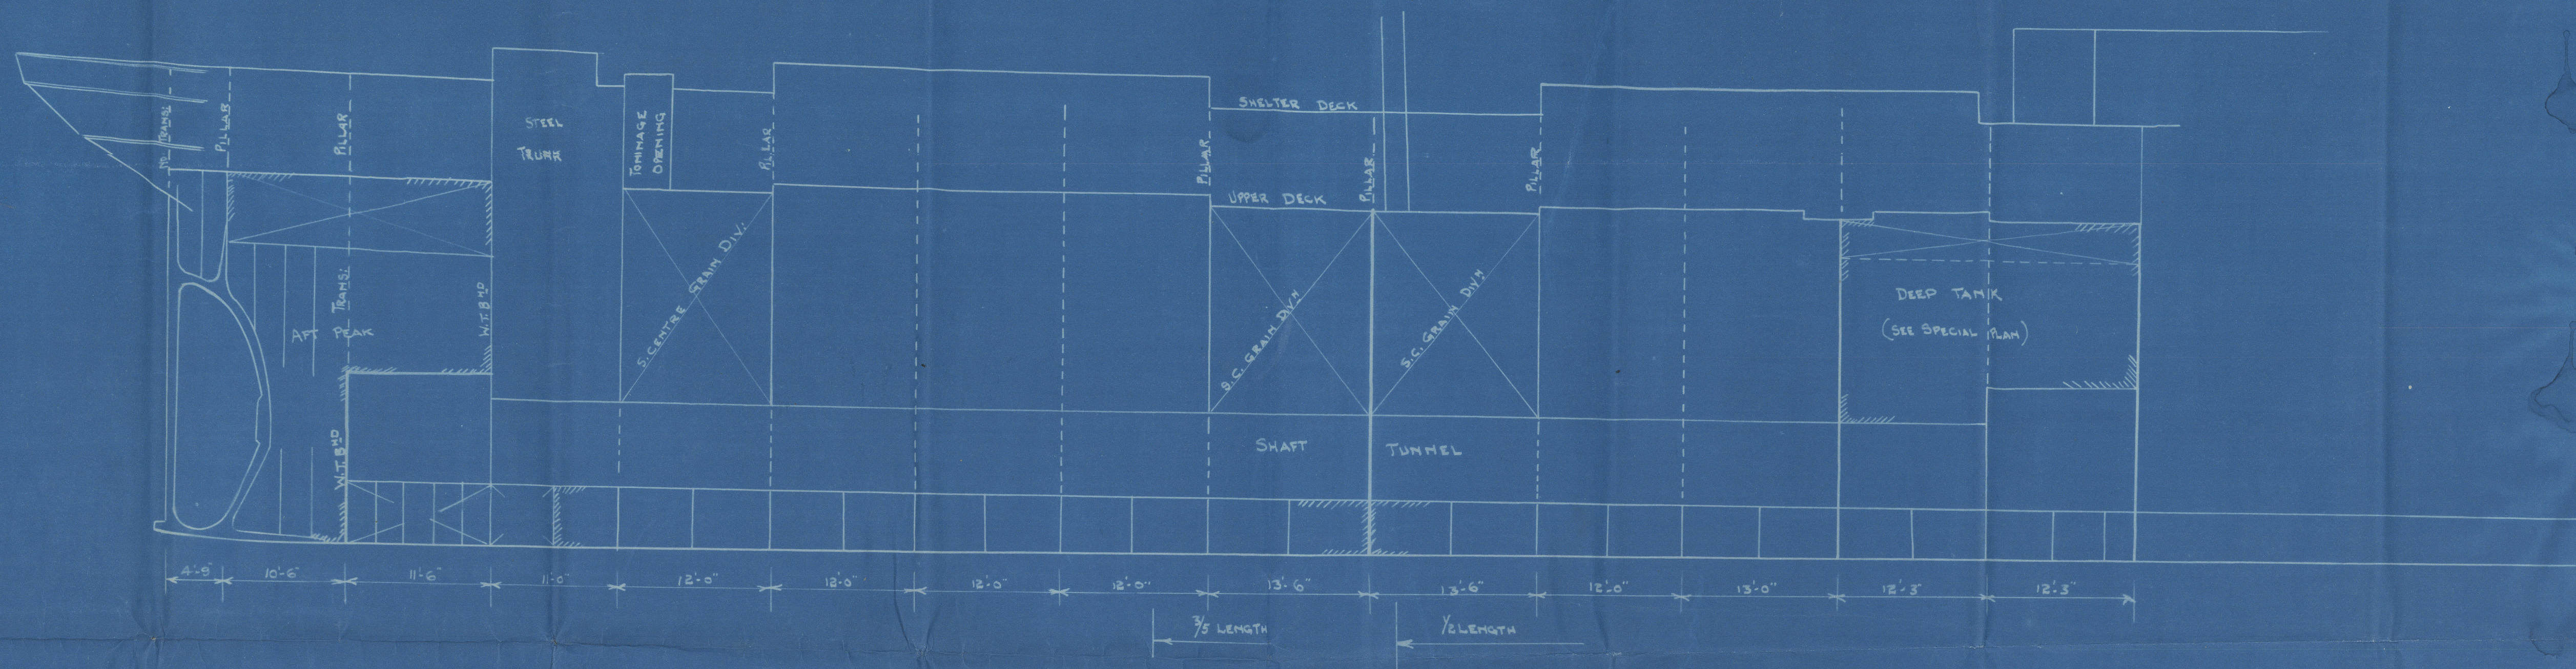

SHORT BROS. LTD.

SHIPBUILDERS

SUNDERLAND.

PLAN 39. 14/4/20.



© 2019
Lloyd's Register
WILLIS TOWERS WATSON

SUNDERLAND

Messrs SHARP Bros L^o

AMENDED PROFILE OF AFTER END

Nos. 4/28 & 4/4

WV

SUNDERLAND RPT. NO. 28234.

~~RETAIN~~

W447-0084



© 2019

Lloyd's Register
Foundation