


ENLARGED SKETCH OF RIVETING IN  
SIDE TRANSVERSE ATTACHMENT TO TANK TOP & TANK SIDE  
3/4" SCALE

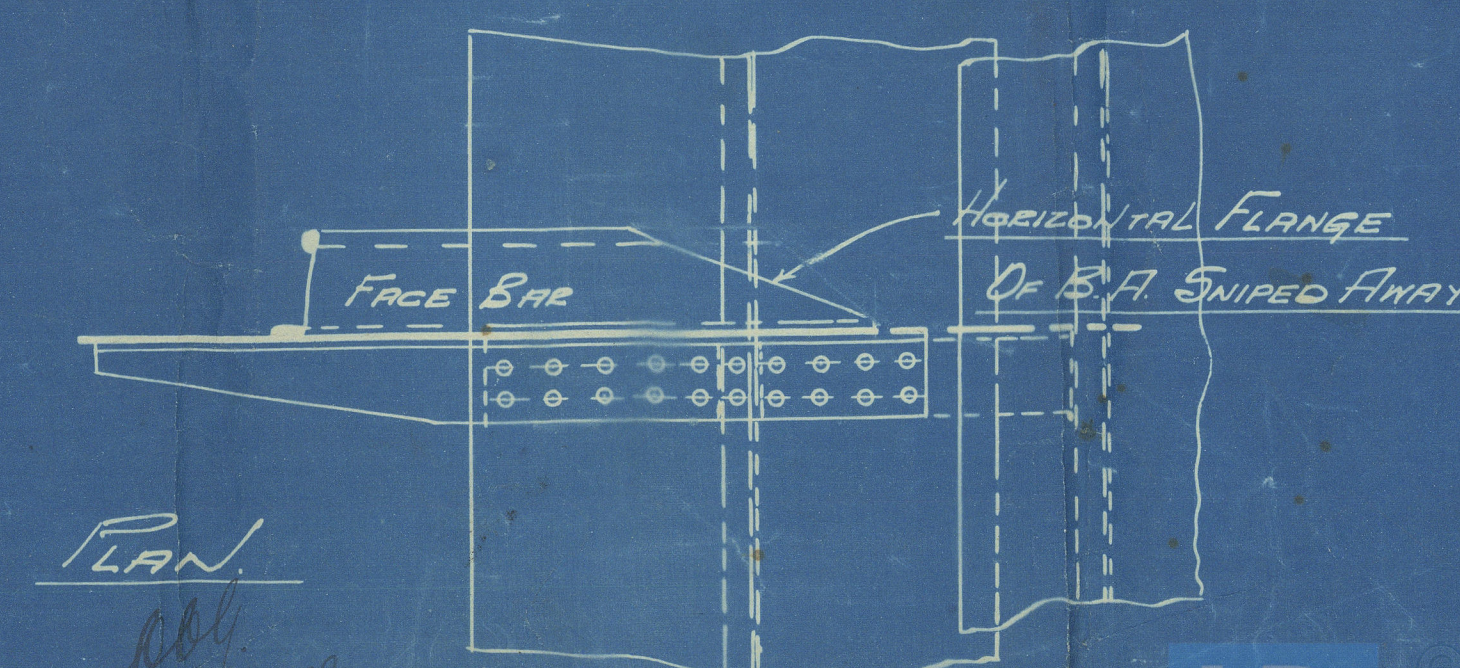

J. W. ISHERWOOD  
 Per S. P.  
 19/12/17  
 Messrs JAGOT Bros Ltd  
 SUNDLAND  
 No 391: 8392. 413.



SUNDERLAND

Mess<sup>rs</sup> SHORP Bros L<sup>d</sup>.

MIDSHIP SECTION

No 413

SEE AMENDED PLAN WITH  
CYLINDRICAL TANKS

SUNDERLAND RPT. NO. 28237

RETAIN

W447-0088



© 2019

Lloyd's Register  
Foundation