

23-6-15
29-9-15

LLOYD'S *100A1 OF STEEL.

- LONGITUDINAL SECTION -

— TOPSIDE PLATING. —

PRINCIPAL DIMENSIONS.

WERF GUSTO
FIRMA A. F. SMULDERS
SCHIEDAM.

RAISED QUARTER DECK.

MAINDECK.



Gunwale bar not cut for scuppers within $\frac{1}{2}$ L.
Steel
CAST IRON SCUPPERS. See 40 para 2

S/S Sirih-Annaland

Profile and
Deckplans.

Rotterdam Report
No 10156 ^e

Wreck 143.
Sec 2.

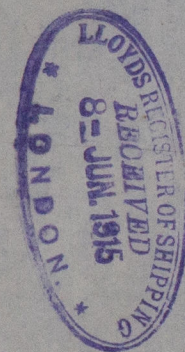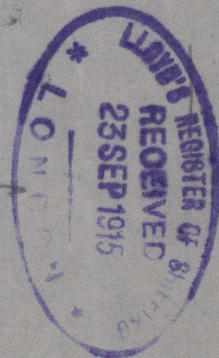

© 2020

Lloyd's Register
Foundation