

Nº 505.

FLY TRACING TO MIDSHIP TRANSVERSE

SHOWING


ALTERNATIVE BRACKET CONNECTION BETWEEN

2ND DECK & SIDE TRANSVERSE.

scale 1/2" = 1'-0"

*in way of
Hartmann apparatus only*

This arrangement to allow working passage round HARTMANN Apparatus.

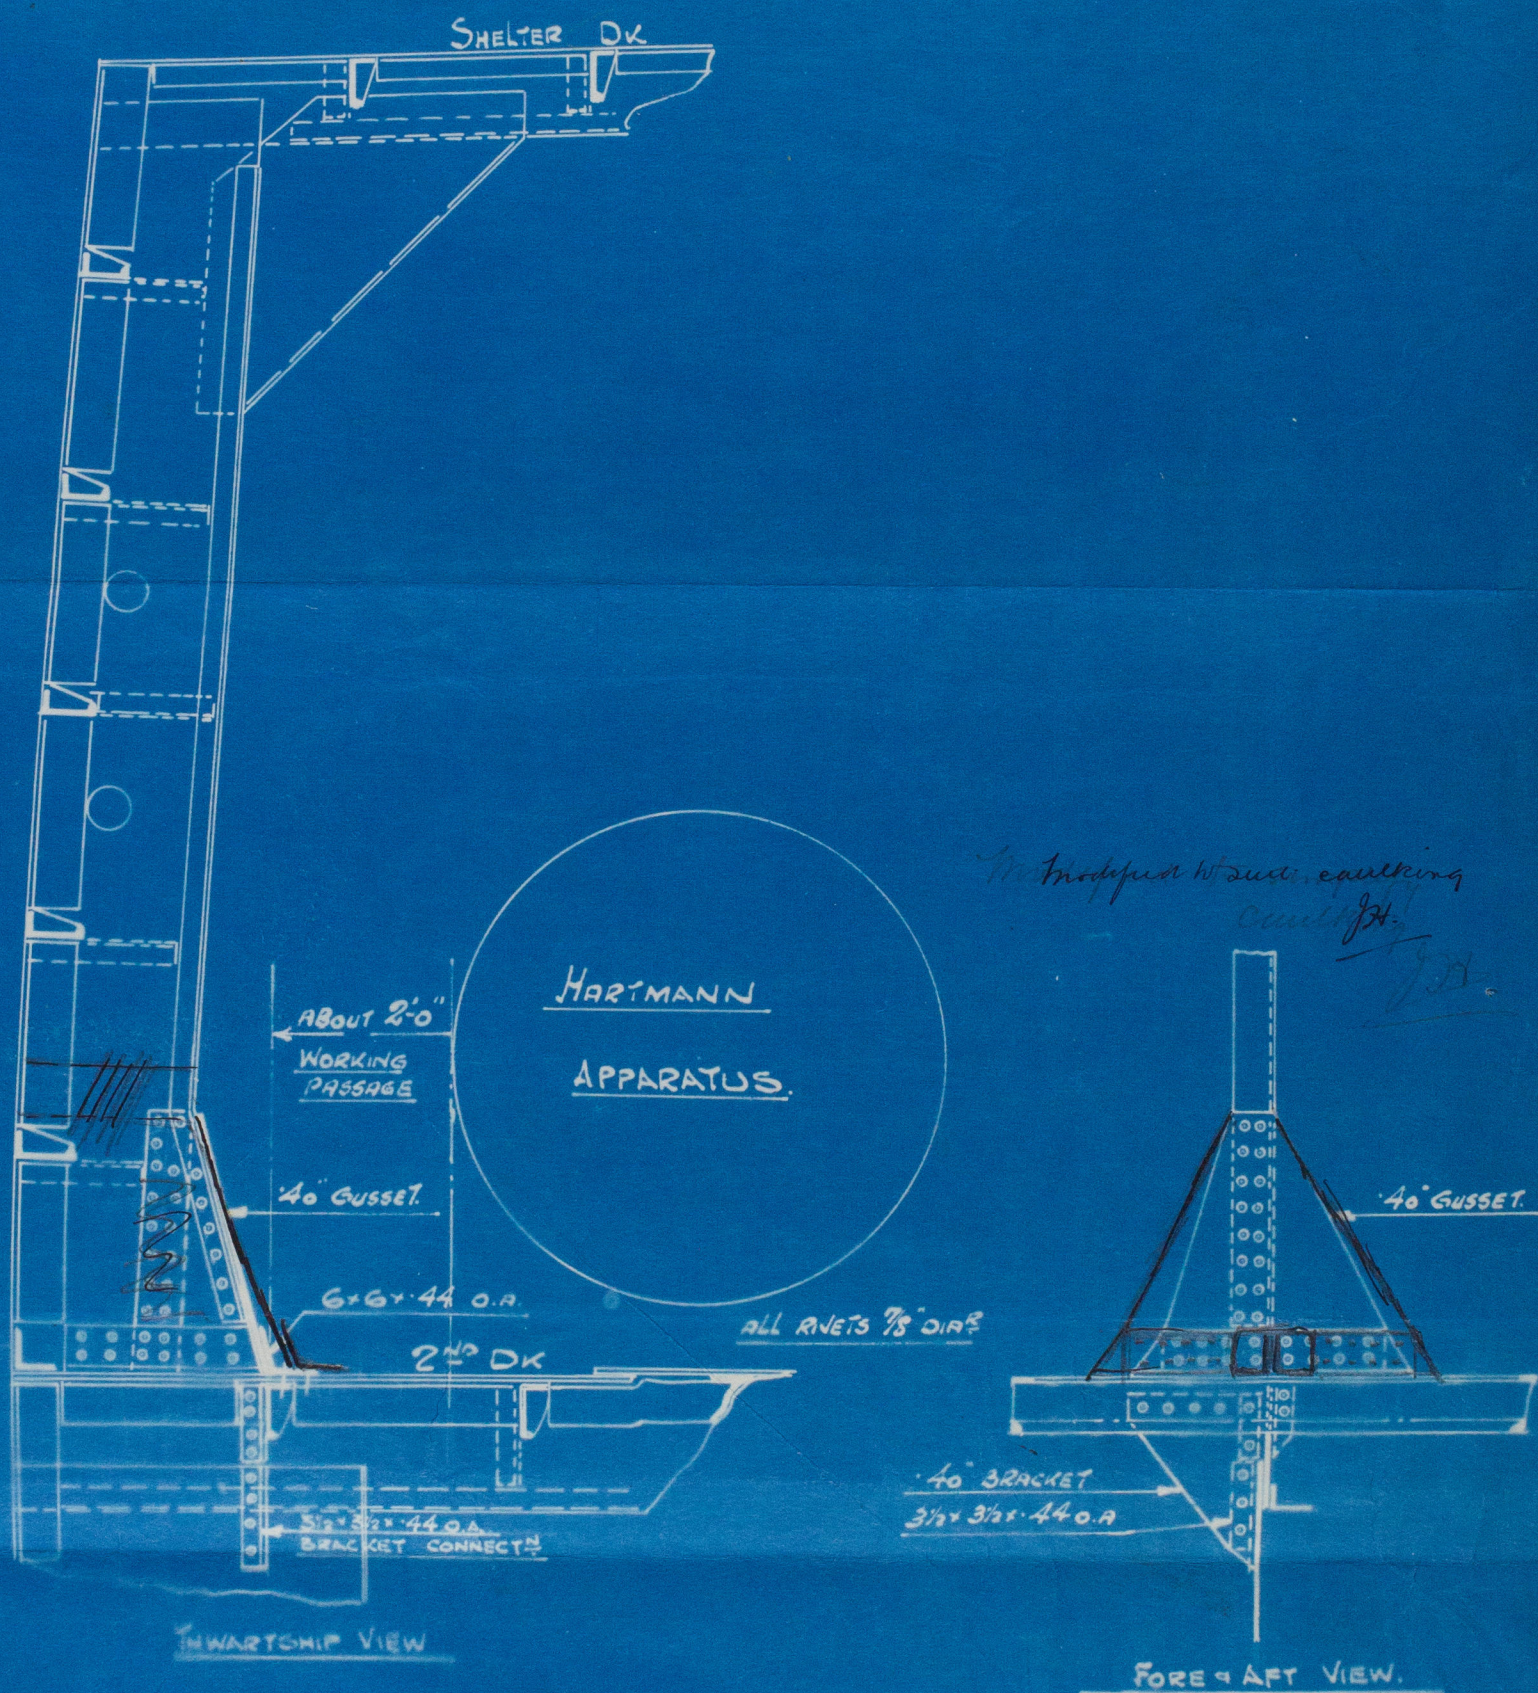

13.11.28

Lloyd's Register
Foundation
W 45-0188

"Kosmos"

Bel. 10213. 10.

N. Clk. 505

Fly to midships transverse

Alternative bracket attachment

of Side Transverses to 2" Dk

in way of Hartman Apparatus

appd 13/11/38.

W45-0188



© 2021

Lloyd's Register
Foundation