

No. 505. S.S.

ARRGT. OF KEELSON BTWN. UPPER & LOWER FLATS FORD


SCALE $\frac{1}{2}$ " = 1 FOOT.

29.11.28



PLANVIEW.

6' x 6" x 50
SHELL CHECKS.

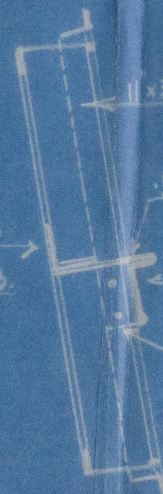


11' x 3/2" x 48. B.A. WITH 4 1/2" x 3 1/2" x 48. REV.

50 INTERCOSTAL PLATE.

8 1/2" x 3 1/2" x 54 B.A. FACE BAR.

LUG FITTED WHERE NO REVERSE.

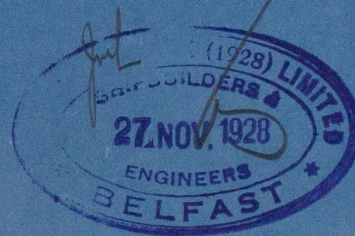

SECTION.

29.11.28
Lloyd's Register
Foundation
W 45-0189

W. elks. 505

12

Revised. Parling

Stringers forward above

O.T. Hat

appd 29/11/28

'Kosmos'

Bel. 10213.

W45-0189

© 2021

Lloyd's Register
Foundation