


22.12.16

 

No 509 - LONGITUDINAL ELEVATION.
482' x 58' x 35'-4"
1/8" INCH = 1 FOOT.

TO CLASS 100 A1 AT LLOYD'S


22.12.16.

Harland & Wolff.

Nº 509


Amended Profile

Y. B. Hine (Bel.)

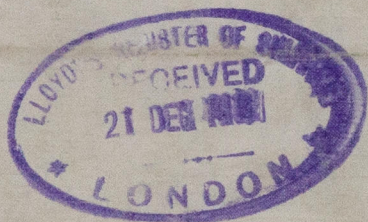

RETAIN

W450-0130

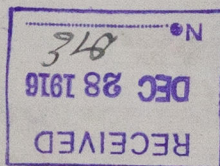

© 2020

Lloyd's Register
Foundation