





5. 5. № 83

Scale 1/8 inch = one foot

NOTE! - IF ANY SCANTLINGS, STRENGTHENINGS ETC.
WHICH WE HAVE HERON SUBMITTED ARE IN
EXCESS OF YOUR MINIMUM REQUIREMENTS,
KINDLY AMEND SAME.

20.2.07
9.4.07
25.7.07

12.07

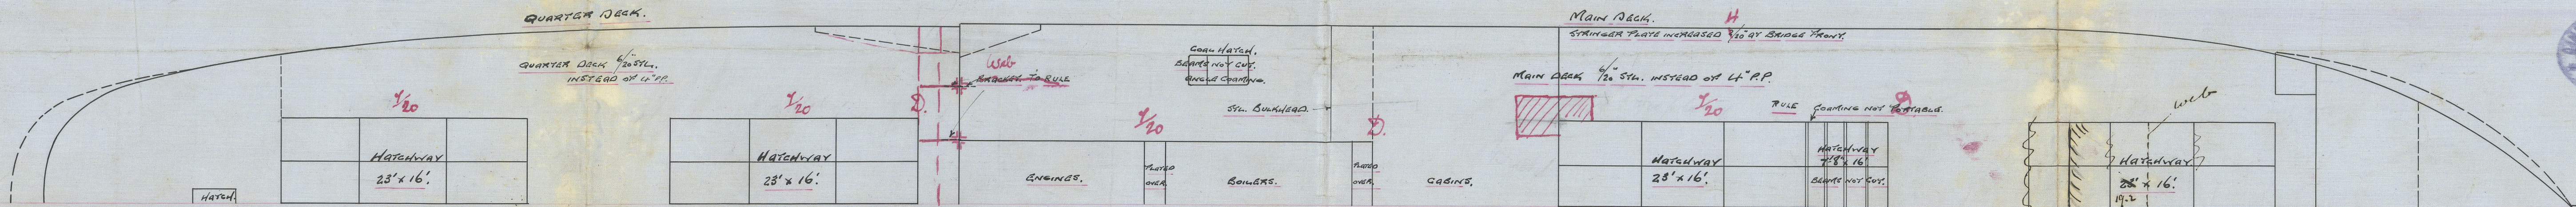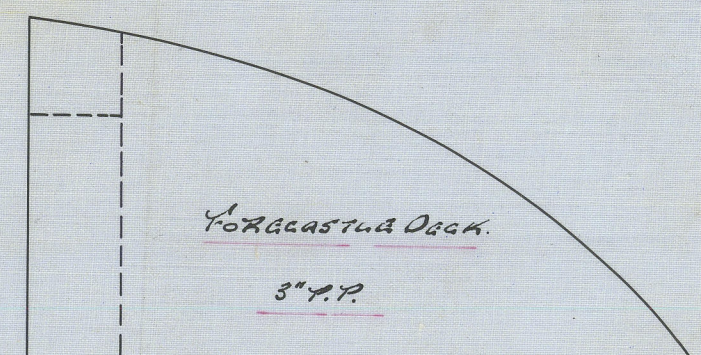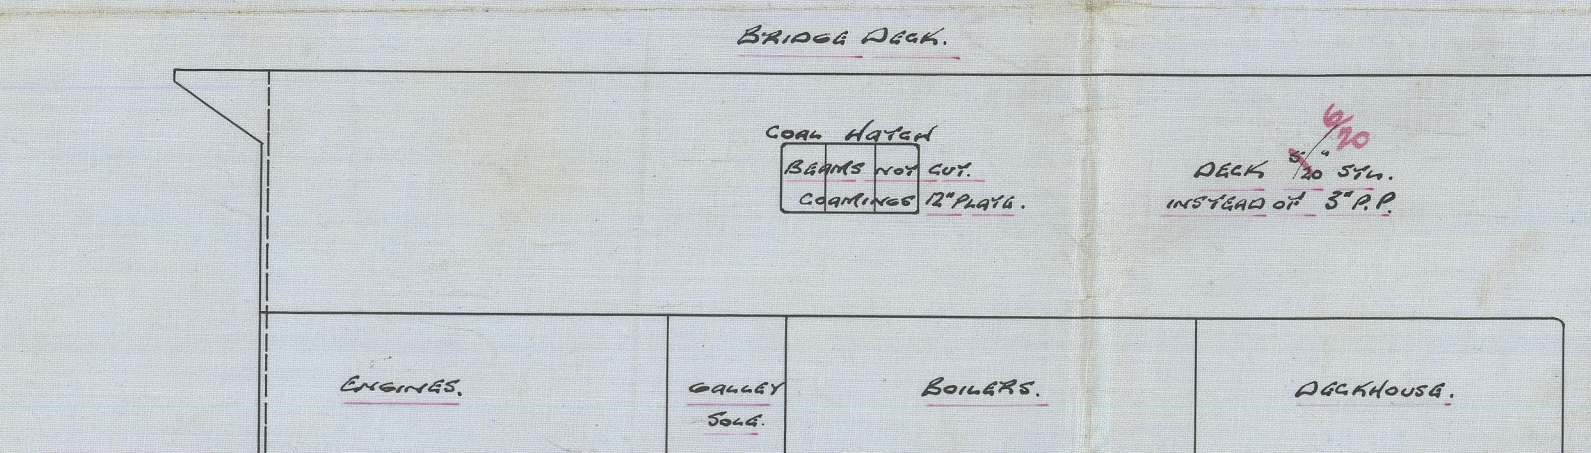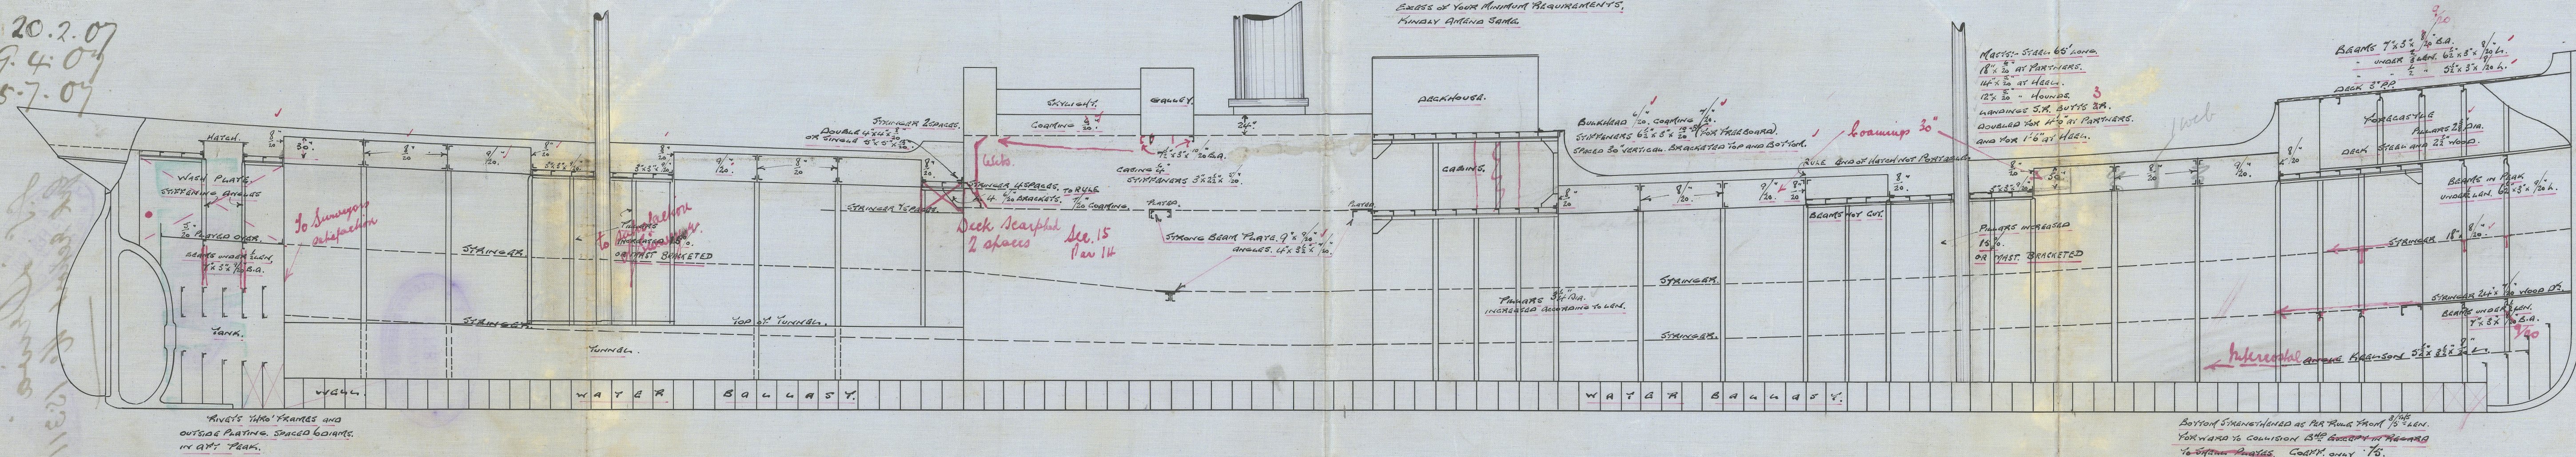

C.B.
19.2.07



Longitudinal Section
Campbelltown S.P. No. 11.83

S.S. Driva
Grk Report No. 15311

DETAIL



© 2019

Lloyd's Register
Foundation