


20.2.07
9.4.07
25.7.07

MIDSHIP SECTION.
S. S. No. 83.
Scale 1 inch one foot.

NOTE: IF ANY SCANTLINGS, STRENGTHENINGS ETC.
WHICH WE HAVE BEEN SUBMITTED ARE IN
EXCESS OF YOUR MINIMUM REQUIREMENTS
KINDLY MENTION SAME


J. C. T. 12.2.07

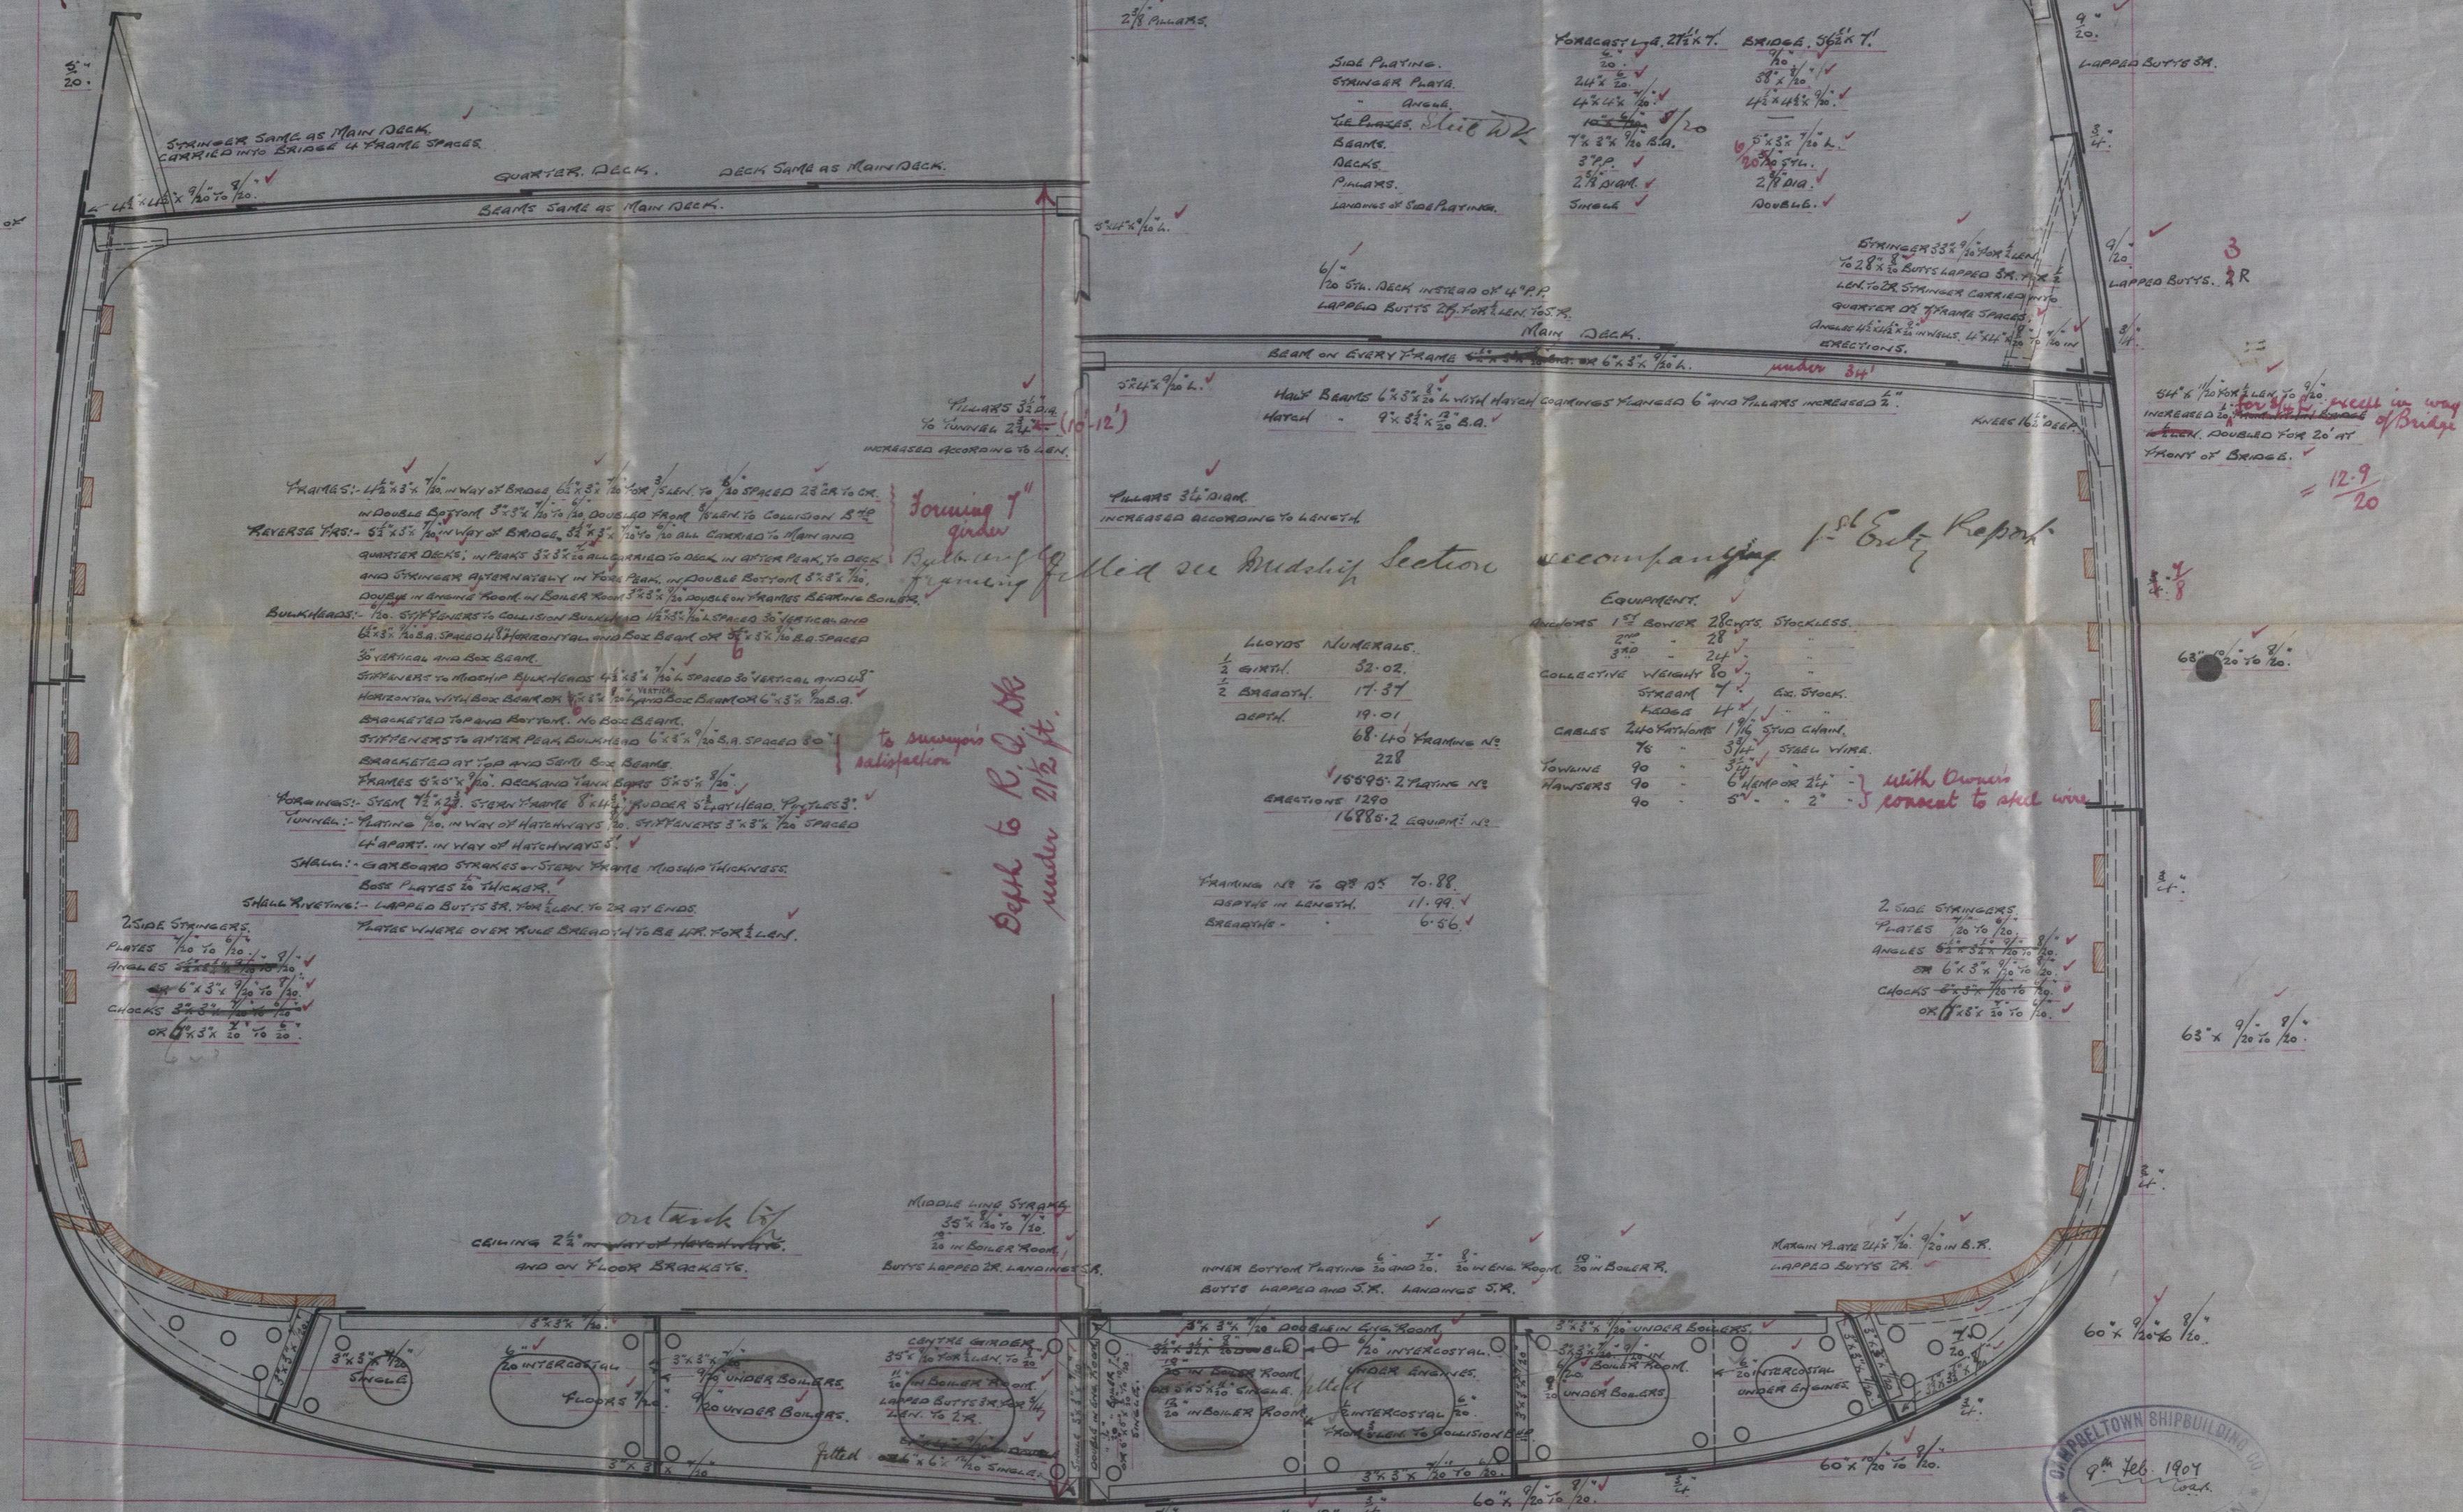

© 2019

Midship Section
Campbelltown Sts Ga N. 83

S.S. Driwa
GRK report N. 15311

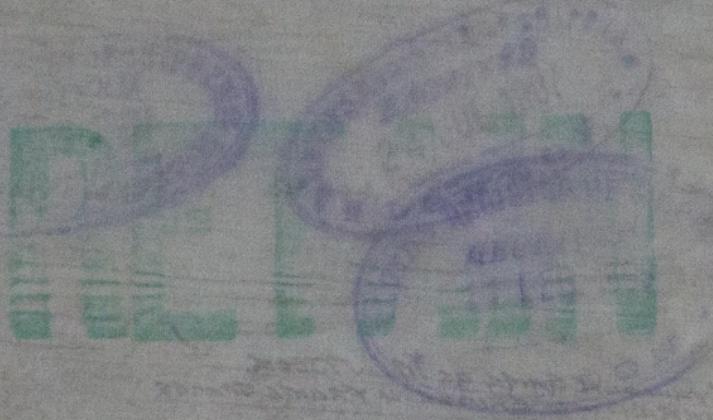

WLSI-0153



© 2019
Lloyd's Register
Foundation