
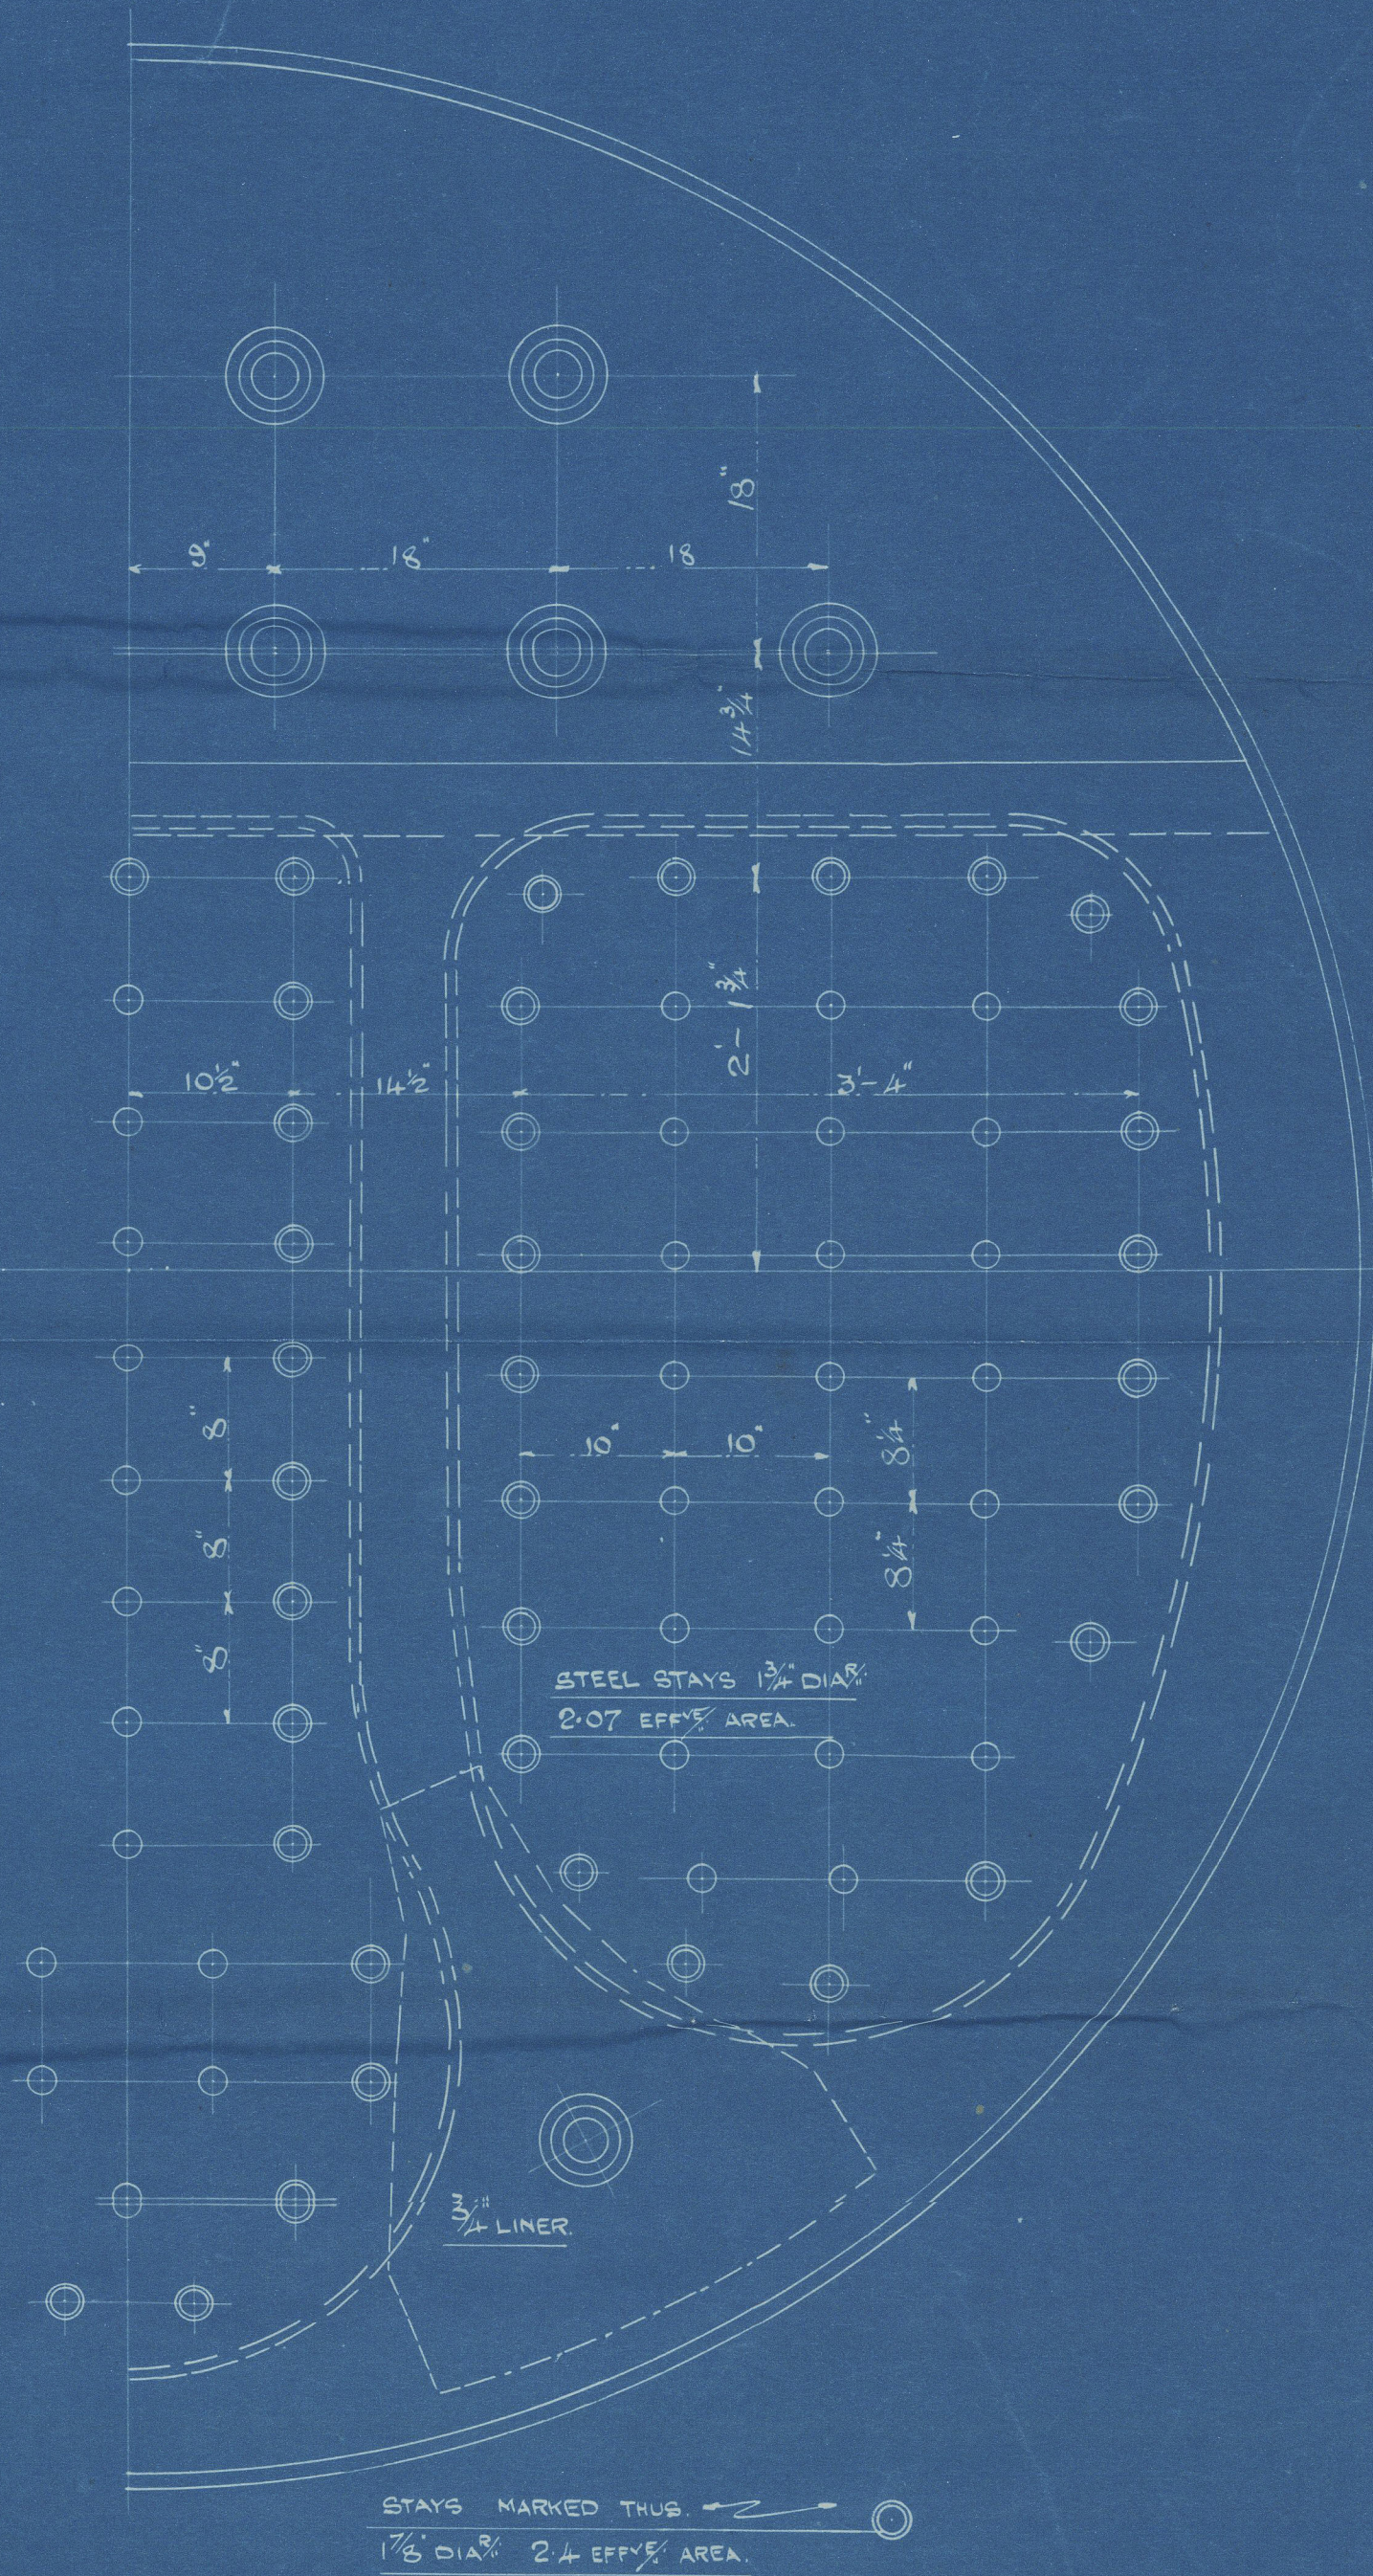
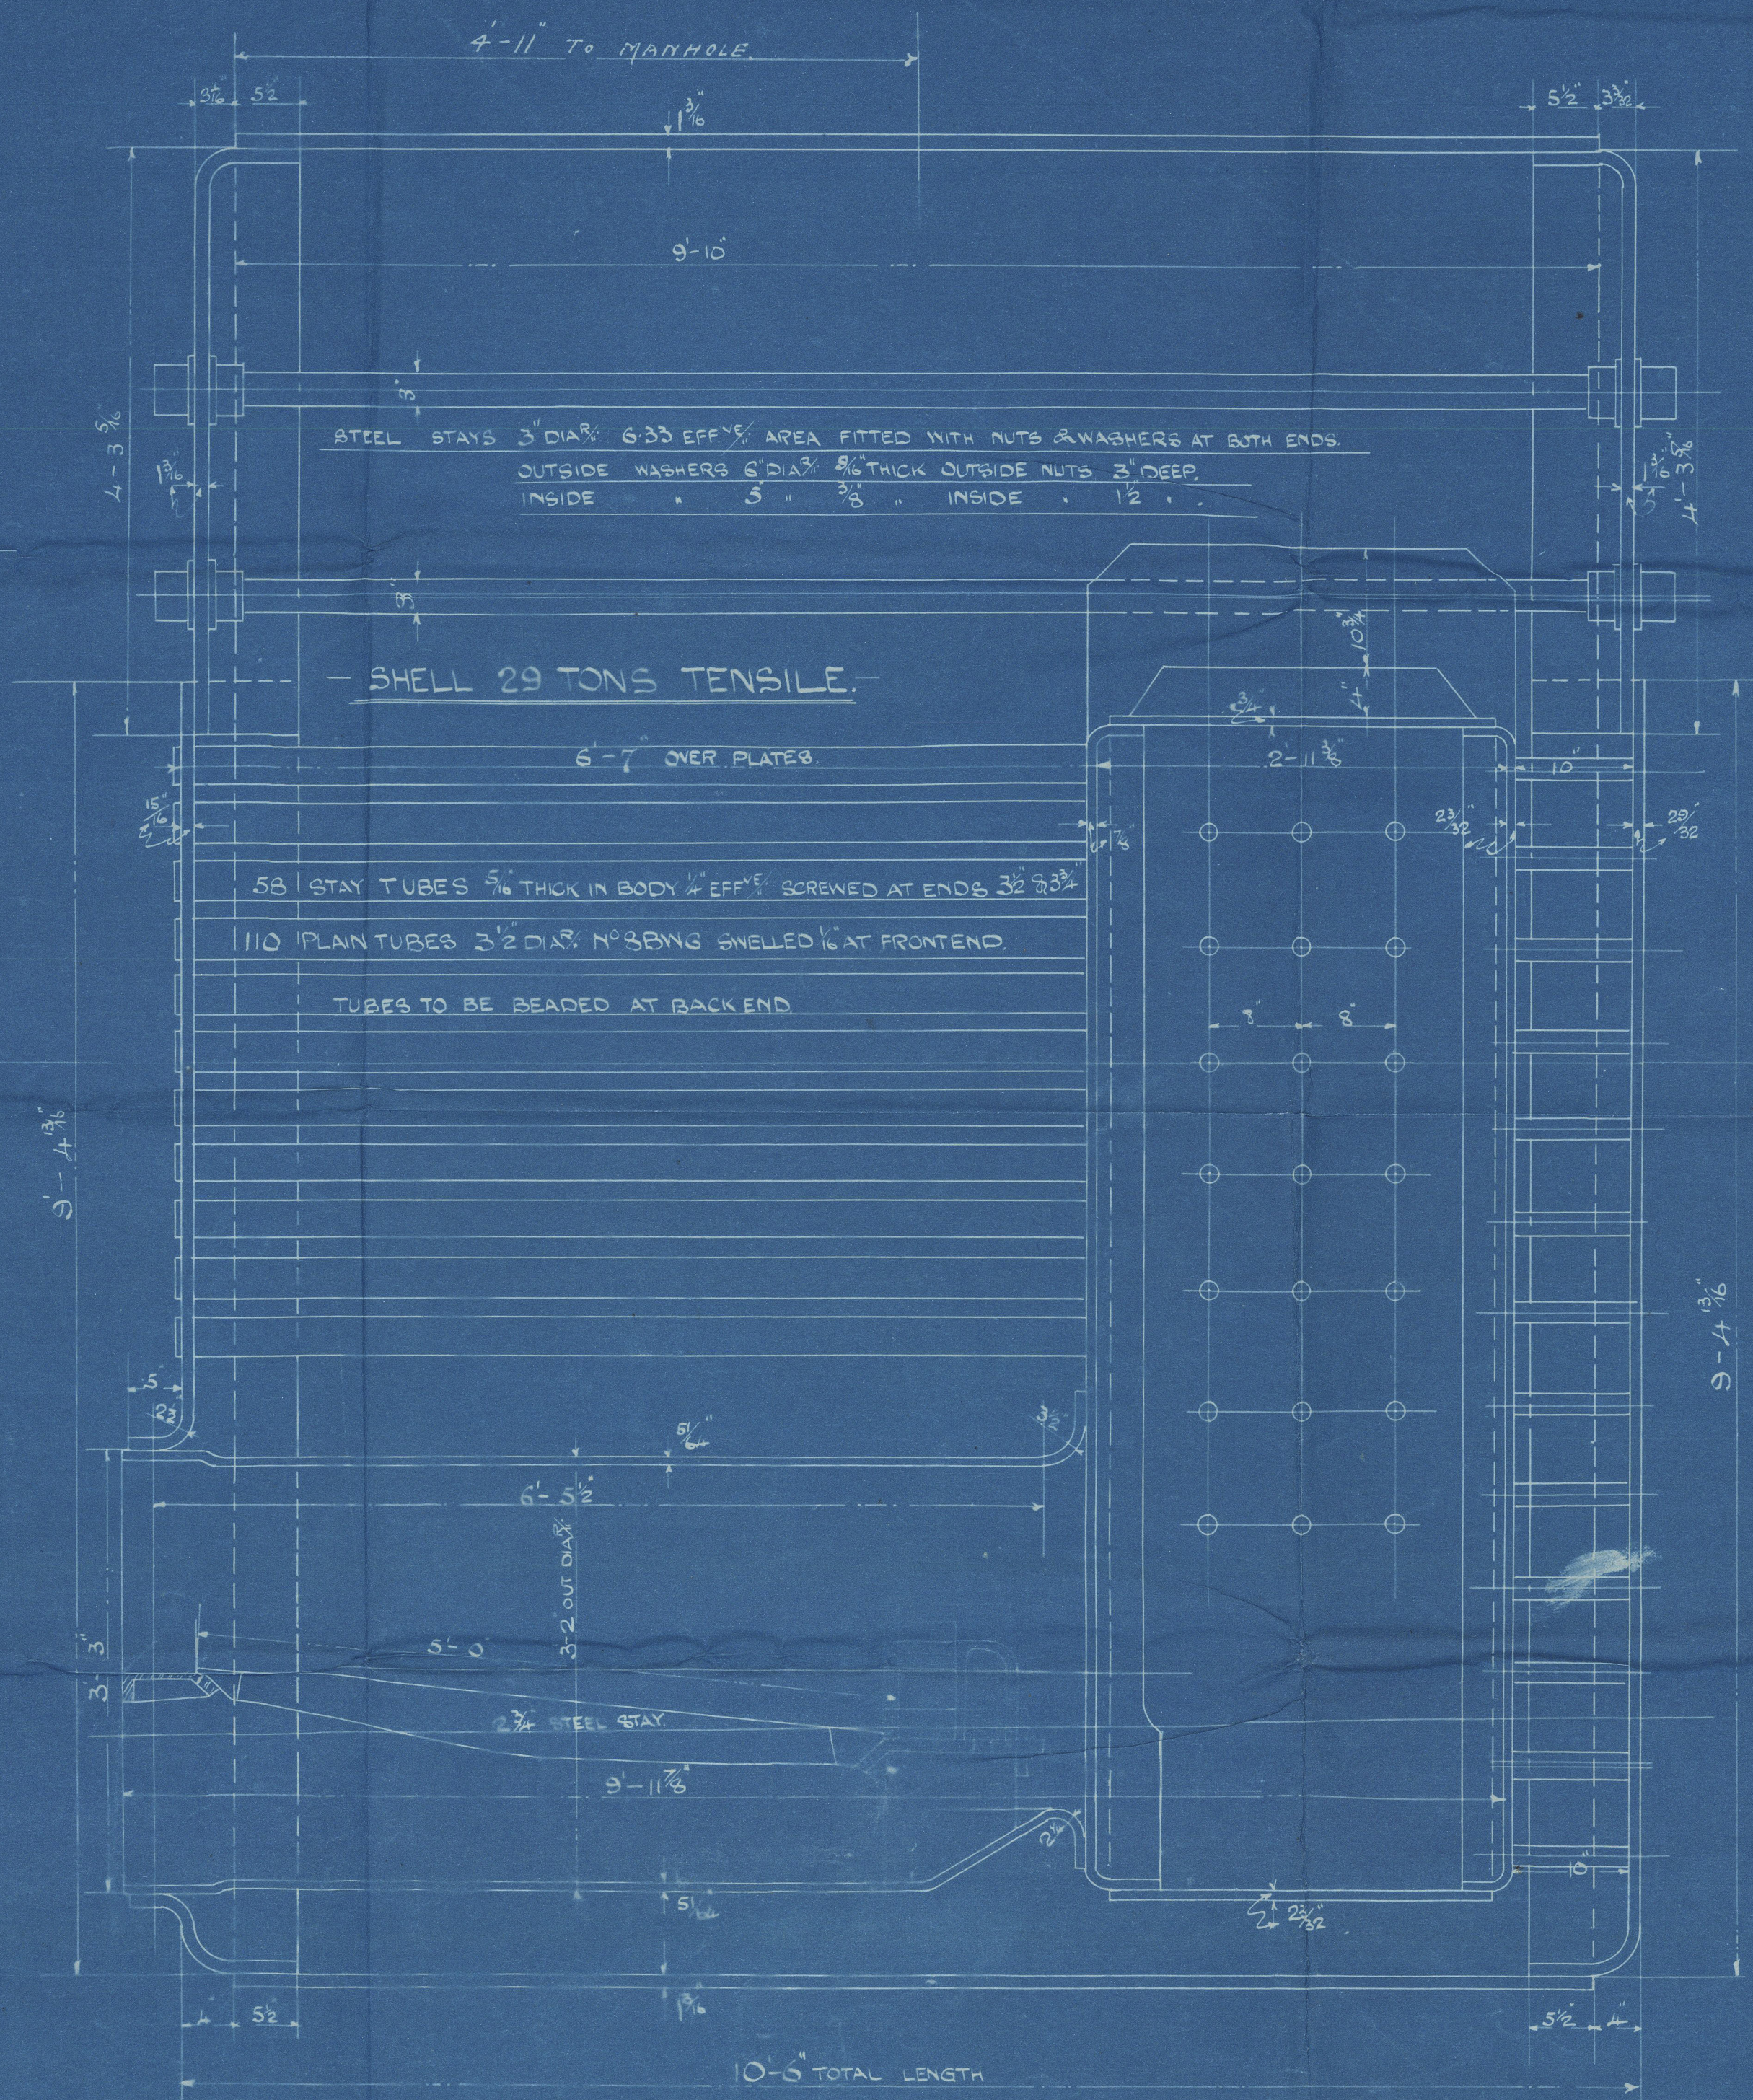
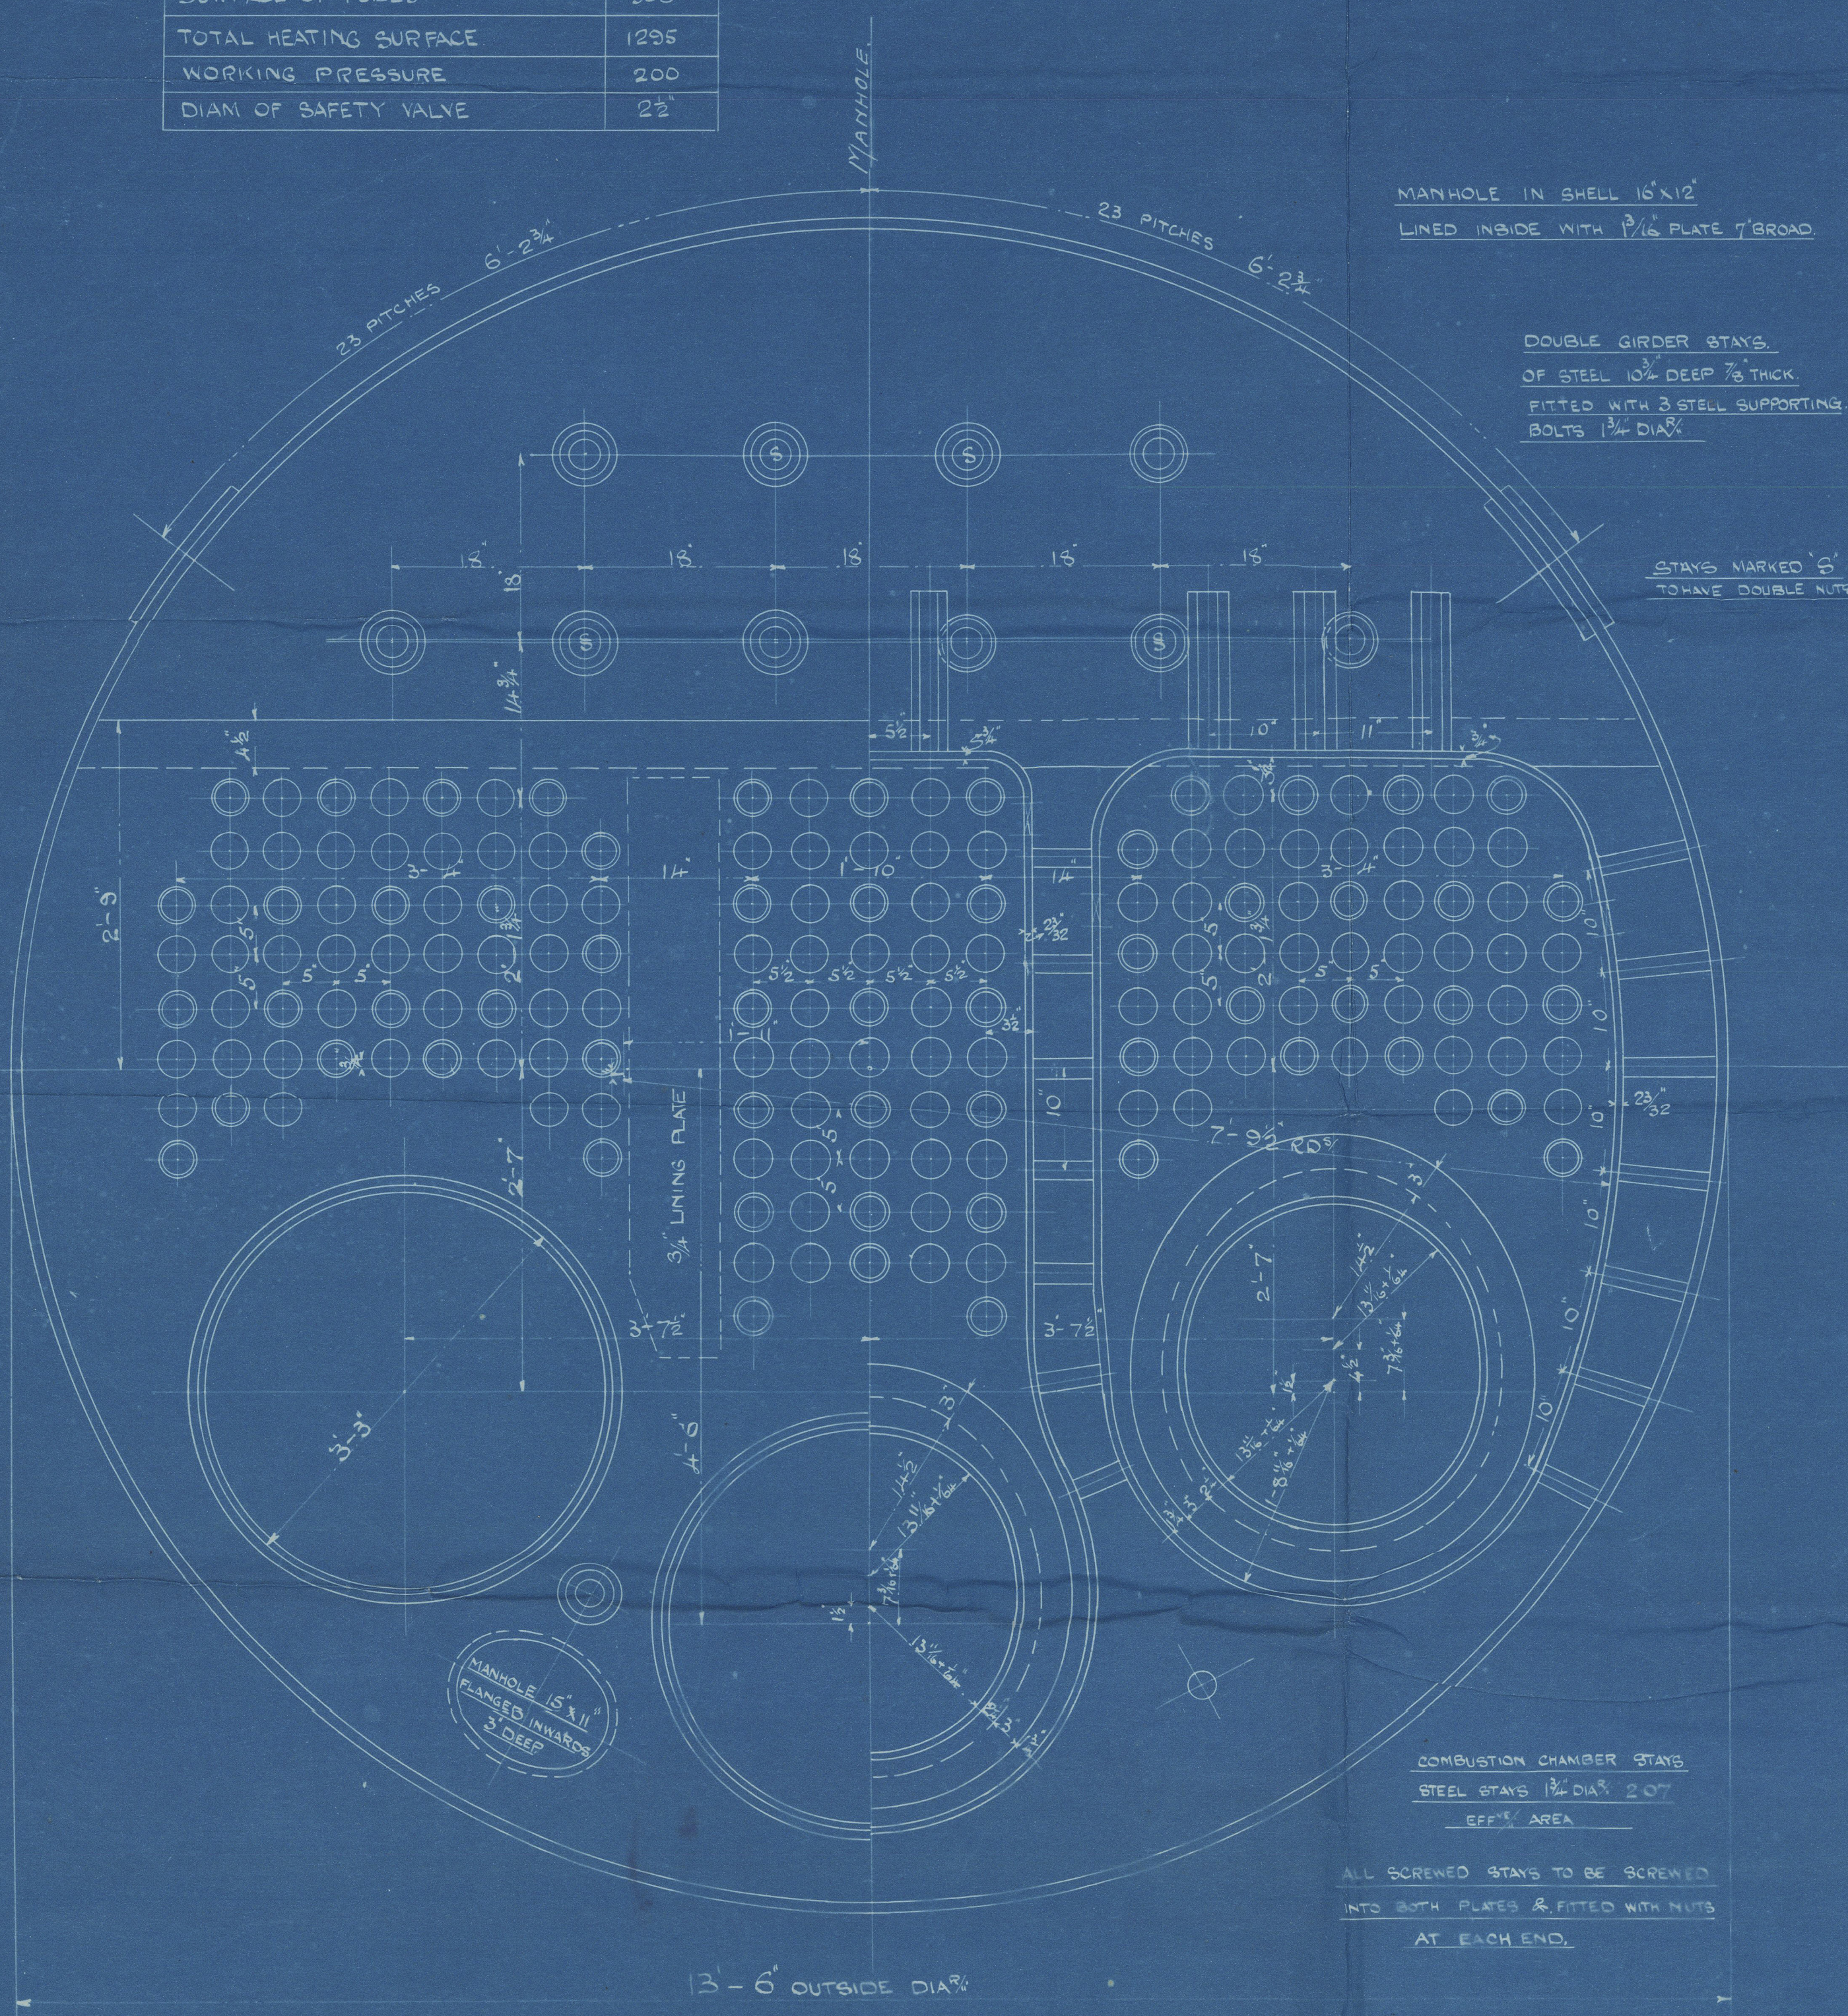


DIMENSIONS	
LENGTH OF FIRE BARS	5'-0"
AREA OF FIRE GRATE	46.4
DIAM OF TUBES OUTSIDE	3 1/2"
LENGTH OF TUBES OVER PLATES	6'-7"
Nº OF TUBES	163
SURFACE OF TUBES	995
TOTAL HEATING SURFACE	1235
WORKING PRESSURE	200
DIAM OF SAFETY VALVE	2 1/2"

PARTICULARS OF RIVETTING
 SHELL - LONGITUDINAL JOINT TO BE TREBLE RIVETTED DOUBLE BUTT JOINT. HOLES DRILLED 1 1/8" DIA. 3" PITCH.
 CIRCUMFERENTIAL JOINT TO BE DOUBLE RIVETTED LAP JOINT. HOLES DRILLED 1 1/8" DIA. 3 1/2" PITCH.
 FURNACES - SINGLE RIVETTED.
 COMB. CHAMBER - SINGLE RIVETTED EXCEPT BOTTOM DOUBLE RIVETTED TO TUBE PLATE.
 END PLATES - CROSS SEAMS DOUBLE RIVETTED LAP JOINTS.

2/7/12

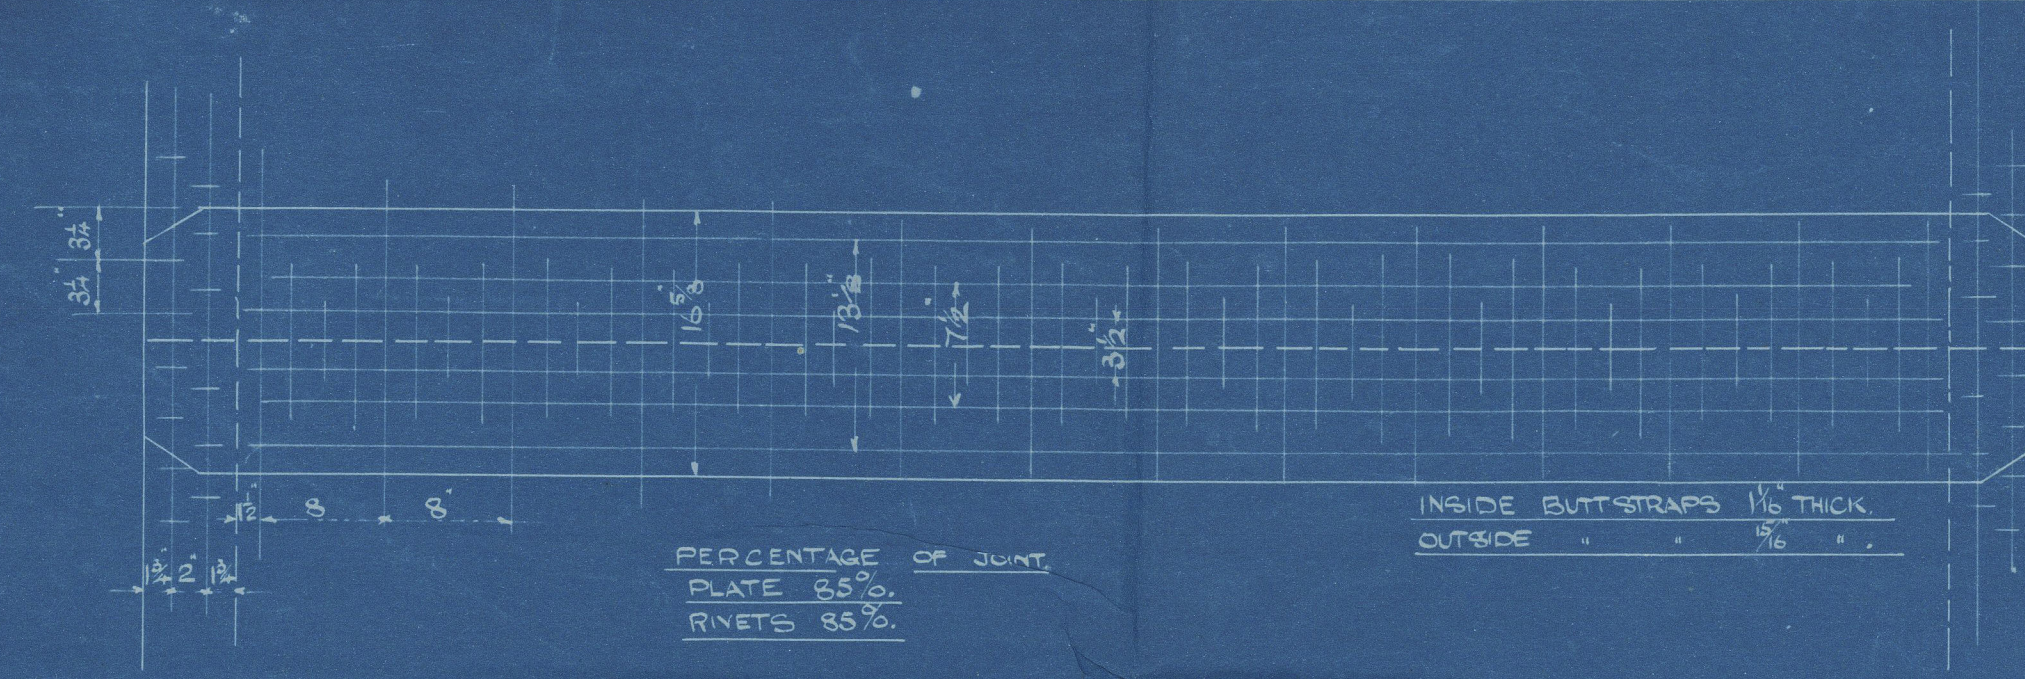

CHARLES D HOLMES & CO LTD
 ENGINEERS & BOILER MAKERS
 HULL
 2/7/12

APR 2/7/12


STEEL BOILER Nº958

PLAN Nº2409

MESSRS. CHARLES D. HOLMES & CO. LD.

N^o. 958.

WORKING PRESSURE 200 LBS.

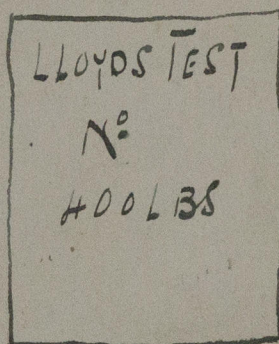

$\frac{1}{16}$ Lord Lister (Cochran ~~London~~ N^o. 530)

Hull Rpt No: 25373

N/N Santa Teresinha

RETAIN

WL53-0238



© 2020

Lloyd's Register
Foundation