


N° 551

# PROFILE & DECK PLANS

SCALE 1/8" = 1 FOOT

420'-0" x 53'-9" MLD x 29'-0" MLD

 

551  
22-5-50



RETAIN

SUNDERLAND

Messrs W. DIXFORD & SONS L<sup>o</sup>

PROFILE & DECK PLAN

(AS BUILT)


No 551

S.S. "BLYTHMOOR"

SUNDERLAND RPT. NO. 28299.

W. 176 Sect 4

© 2020

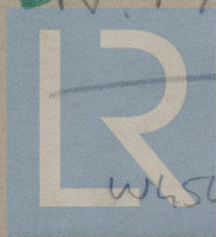

Lloyd's Register  
Foundation

WHS0067