

S S N° 500

LENGTH B.P. 388.5

BREADTH EXTREME 54.2

DEPTH MIN 28-6 1/2


SCALE $\frac{1}{8}'' = 1 \text{ FOOT}$

NOTE - POSITION OF BUTTS ARE APPROXIMATE

SHELTER DECK WHERE EXPOSED TO BE STEEL OF IRON THICKNESS


NOT EXPOSED " " " " RULE ✓

STRONG WELDED ANGLE AROUND COAMING

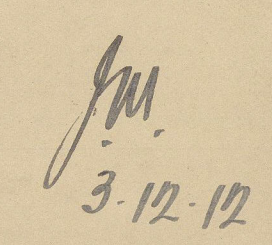

6140
500.
28-11-12

W454-0243

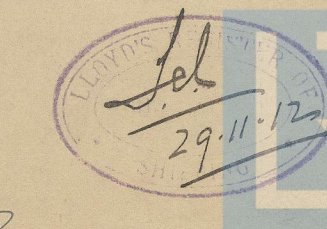

SUNDERLAND.

Messrs W. L. THOMPSON & Son. Ld.

DECK PLAN

No. 500.

S.S. DEN OF EWNIE

S40. Report No 25918



W454-0243



© 2020

Lloyd's Register
Foundation