


SHELTER DECK HATCH COAMING.

SECTION VIEW STARBD SIDE

MAIN DECK HATCH COAMING.

SECTION VIEW STARBD SIDE.

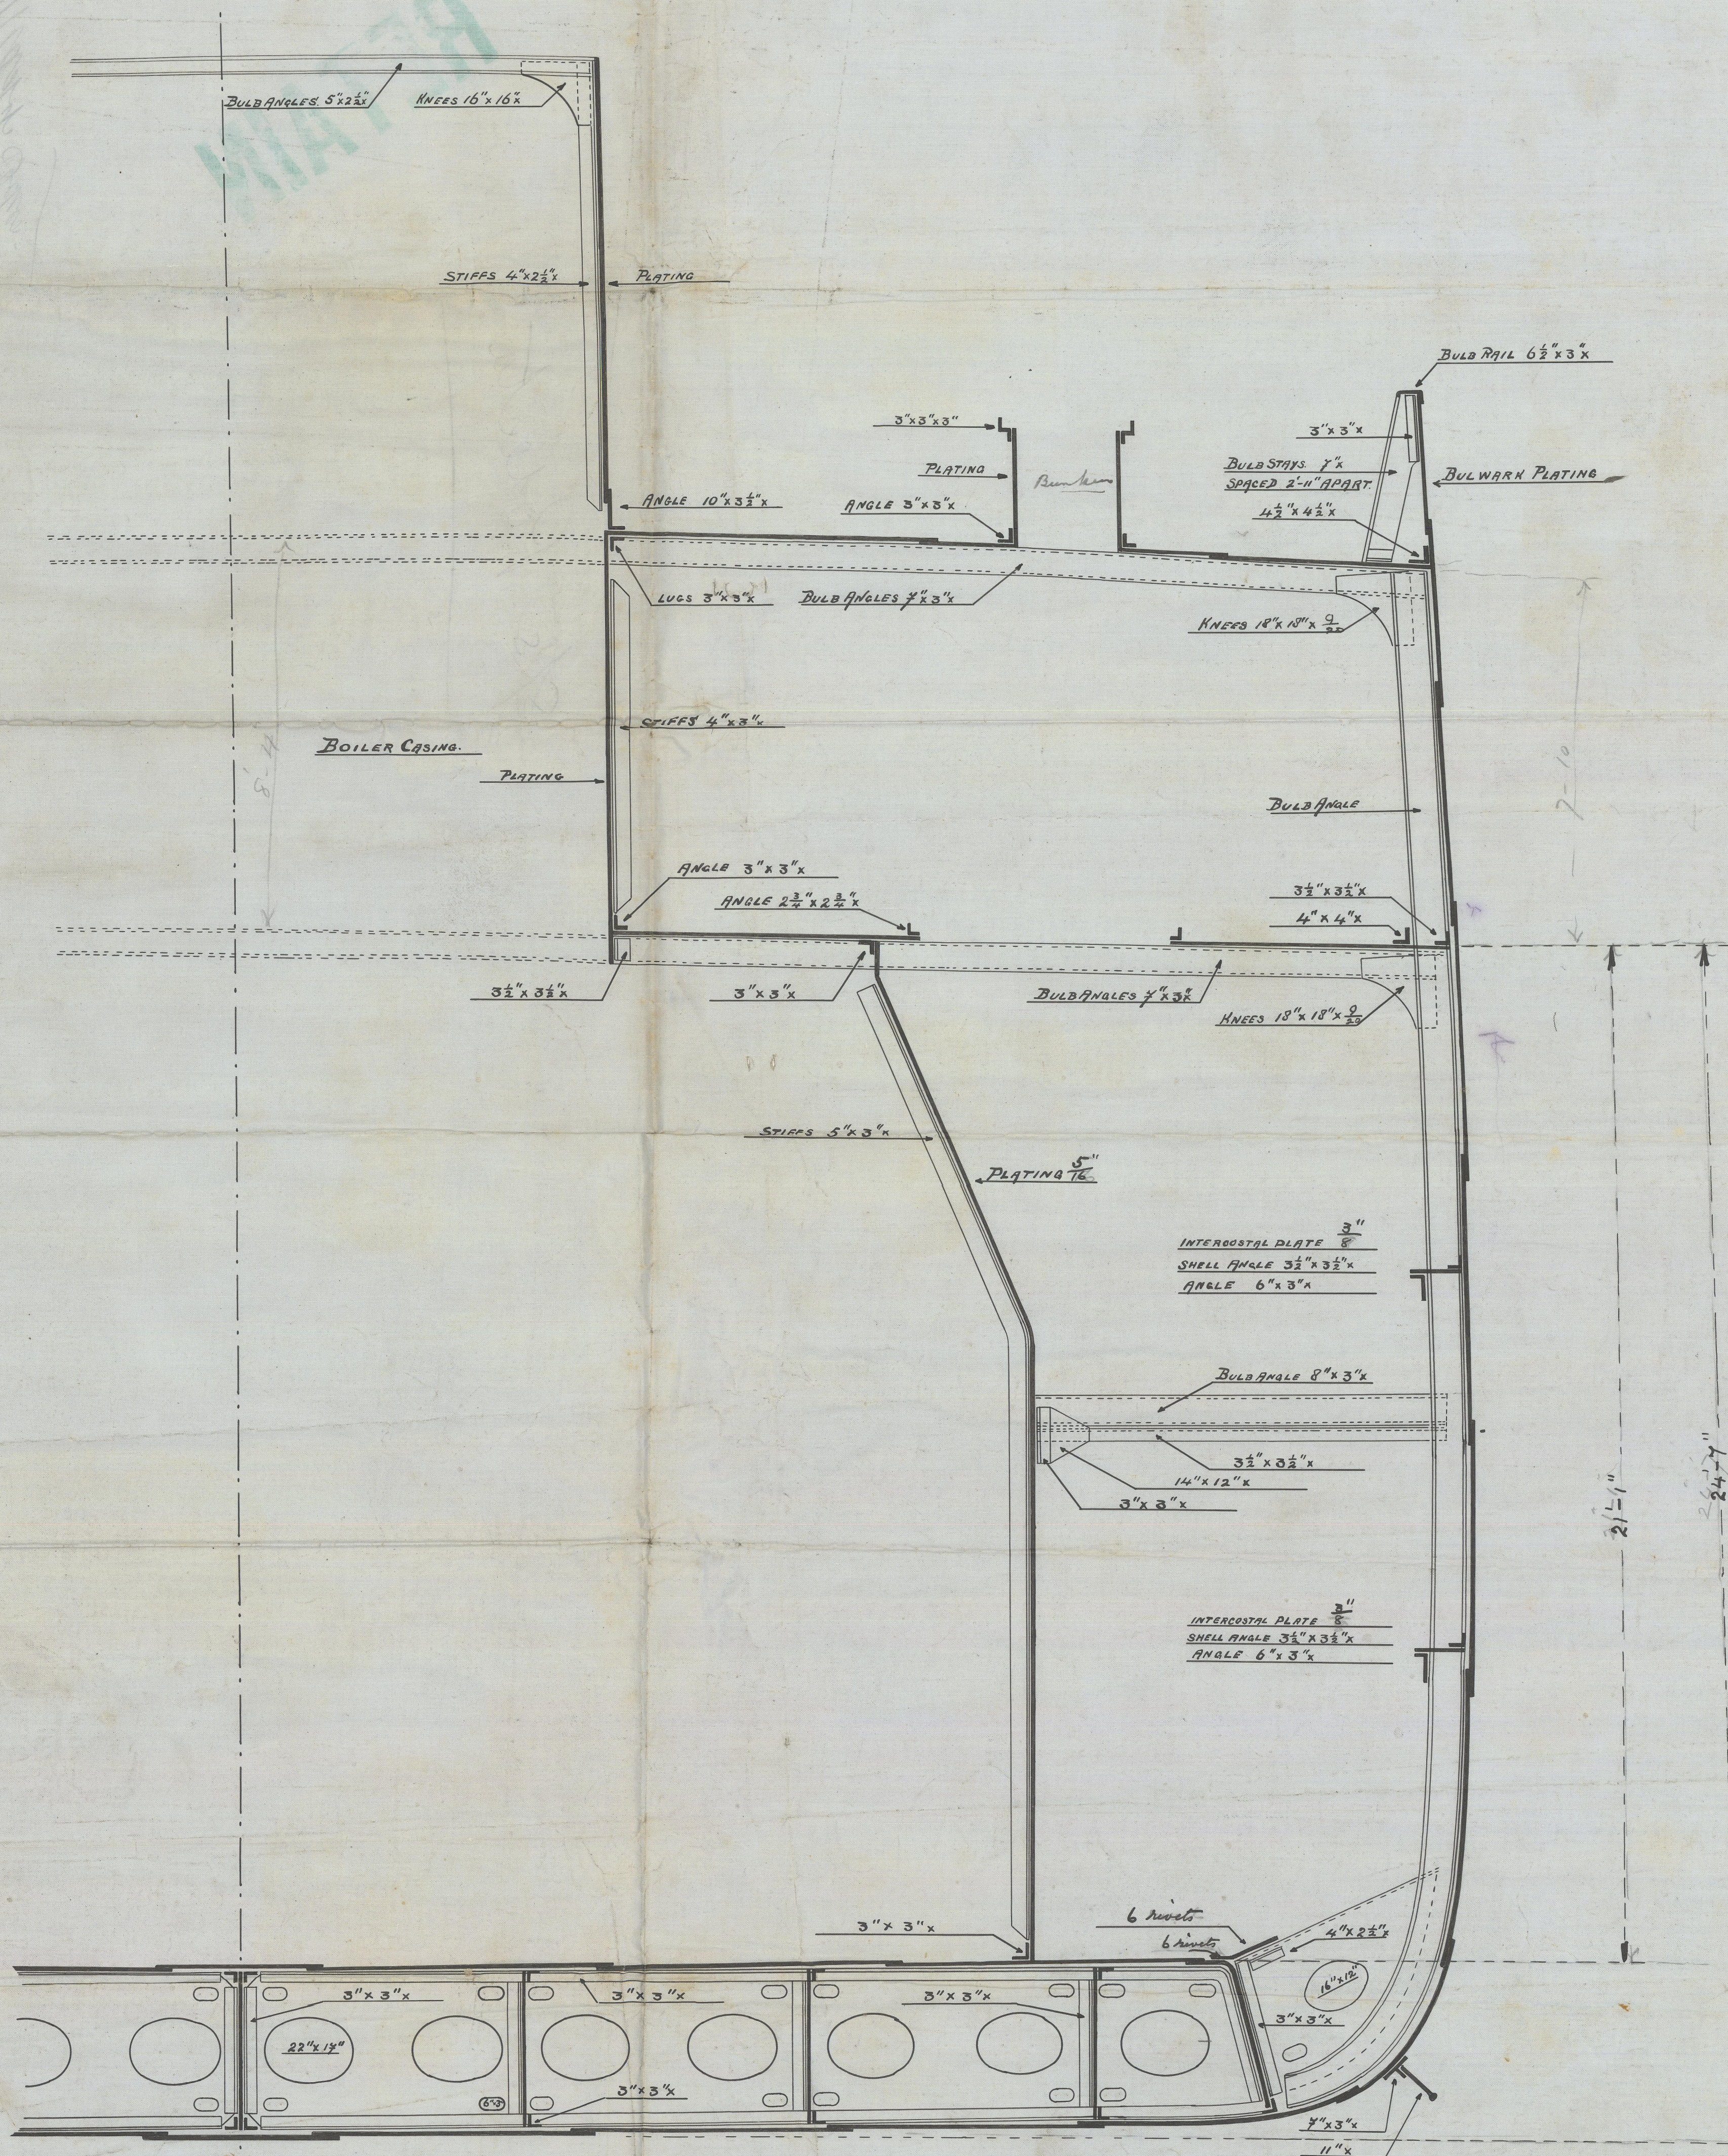

MIDSHIP SECTION

SCALE. $\frac{1}{2}$ " to the foot.

SCALE. $\frac{1}{2}$ " to the foot. Present free board
marked on side 10'-3 $\frac{1}{2}$ " from sheller draft

S. S. PoDESTA

RETAILED

Middle Section

W654-0340

RETAILED

Top Quarter 2x3 1/2

W654 19 x 1 1/2

W654 19 x 1 1/2



© 2020

Lloyd's Register
Foundation