


Section through Engine room
Messrs J Fullerton & Co
S.S. No 216.

GLASGOW REPORT No 29406

W455-0062

RETAIN

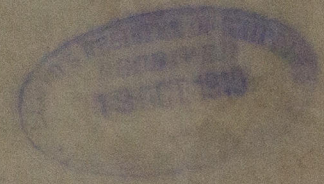

© 2020


Lloyd's Register
Foundation

21.2.10
2.3.10

GLASGOW REPORT NO. 20408

RETAIN

— S. S. N° 216 —
— SECTION THRO' ENGINE ROOM —
— SCALE $\frac{1}{2}" = 1'-0"$ —

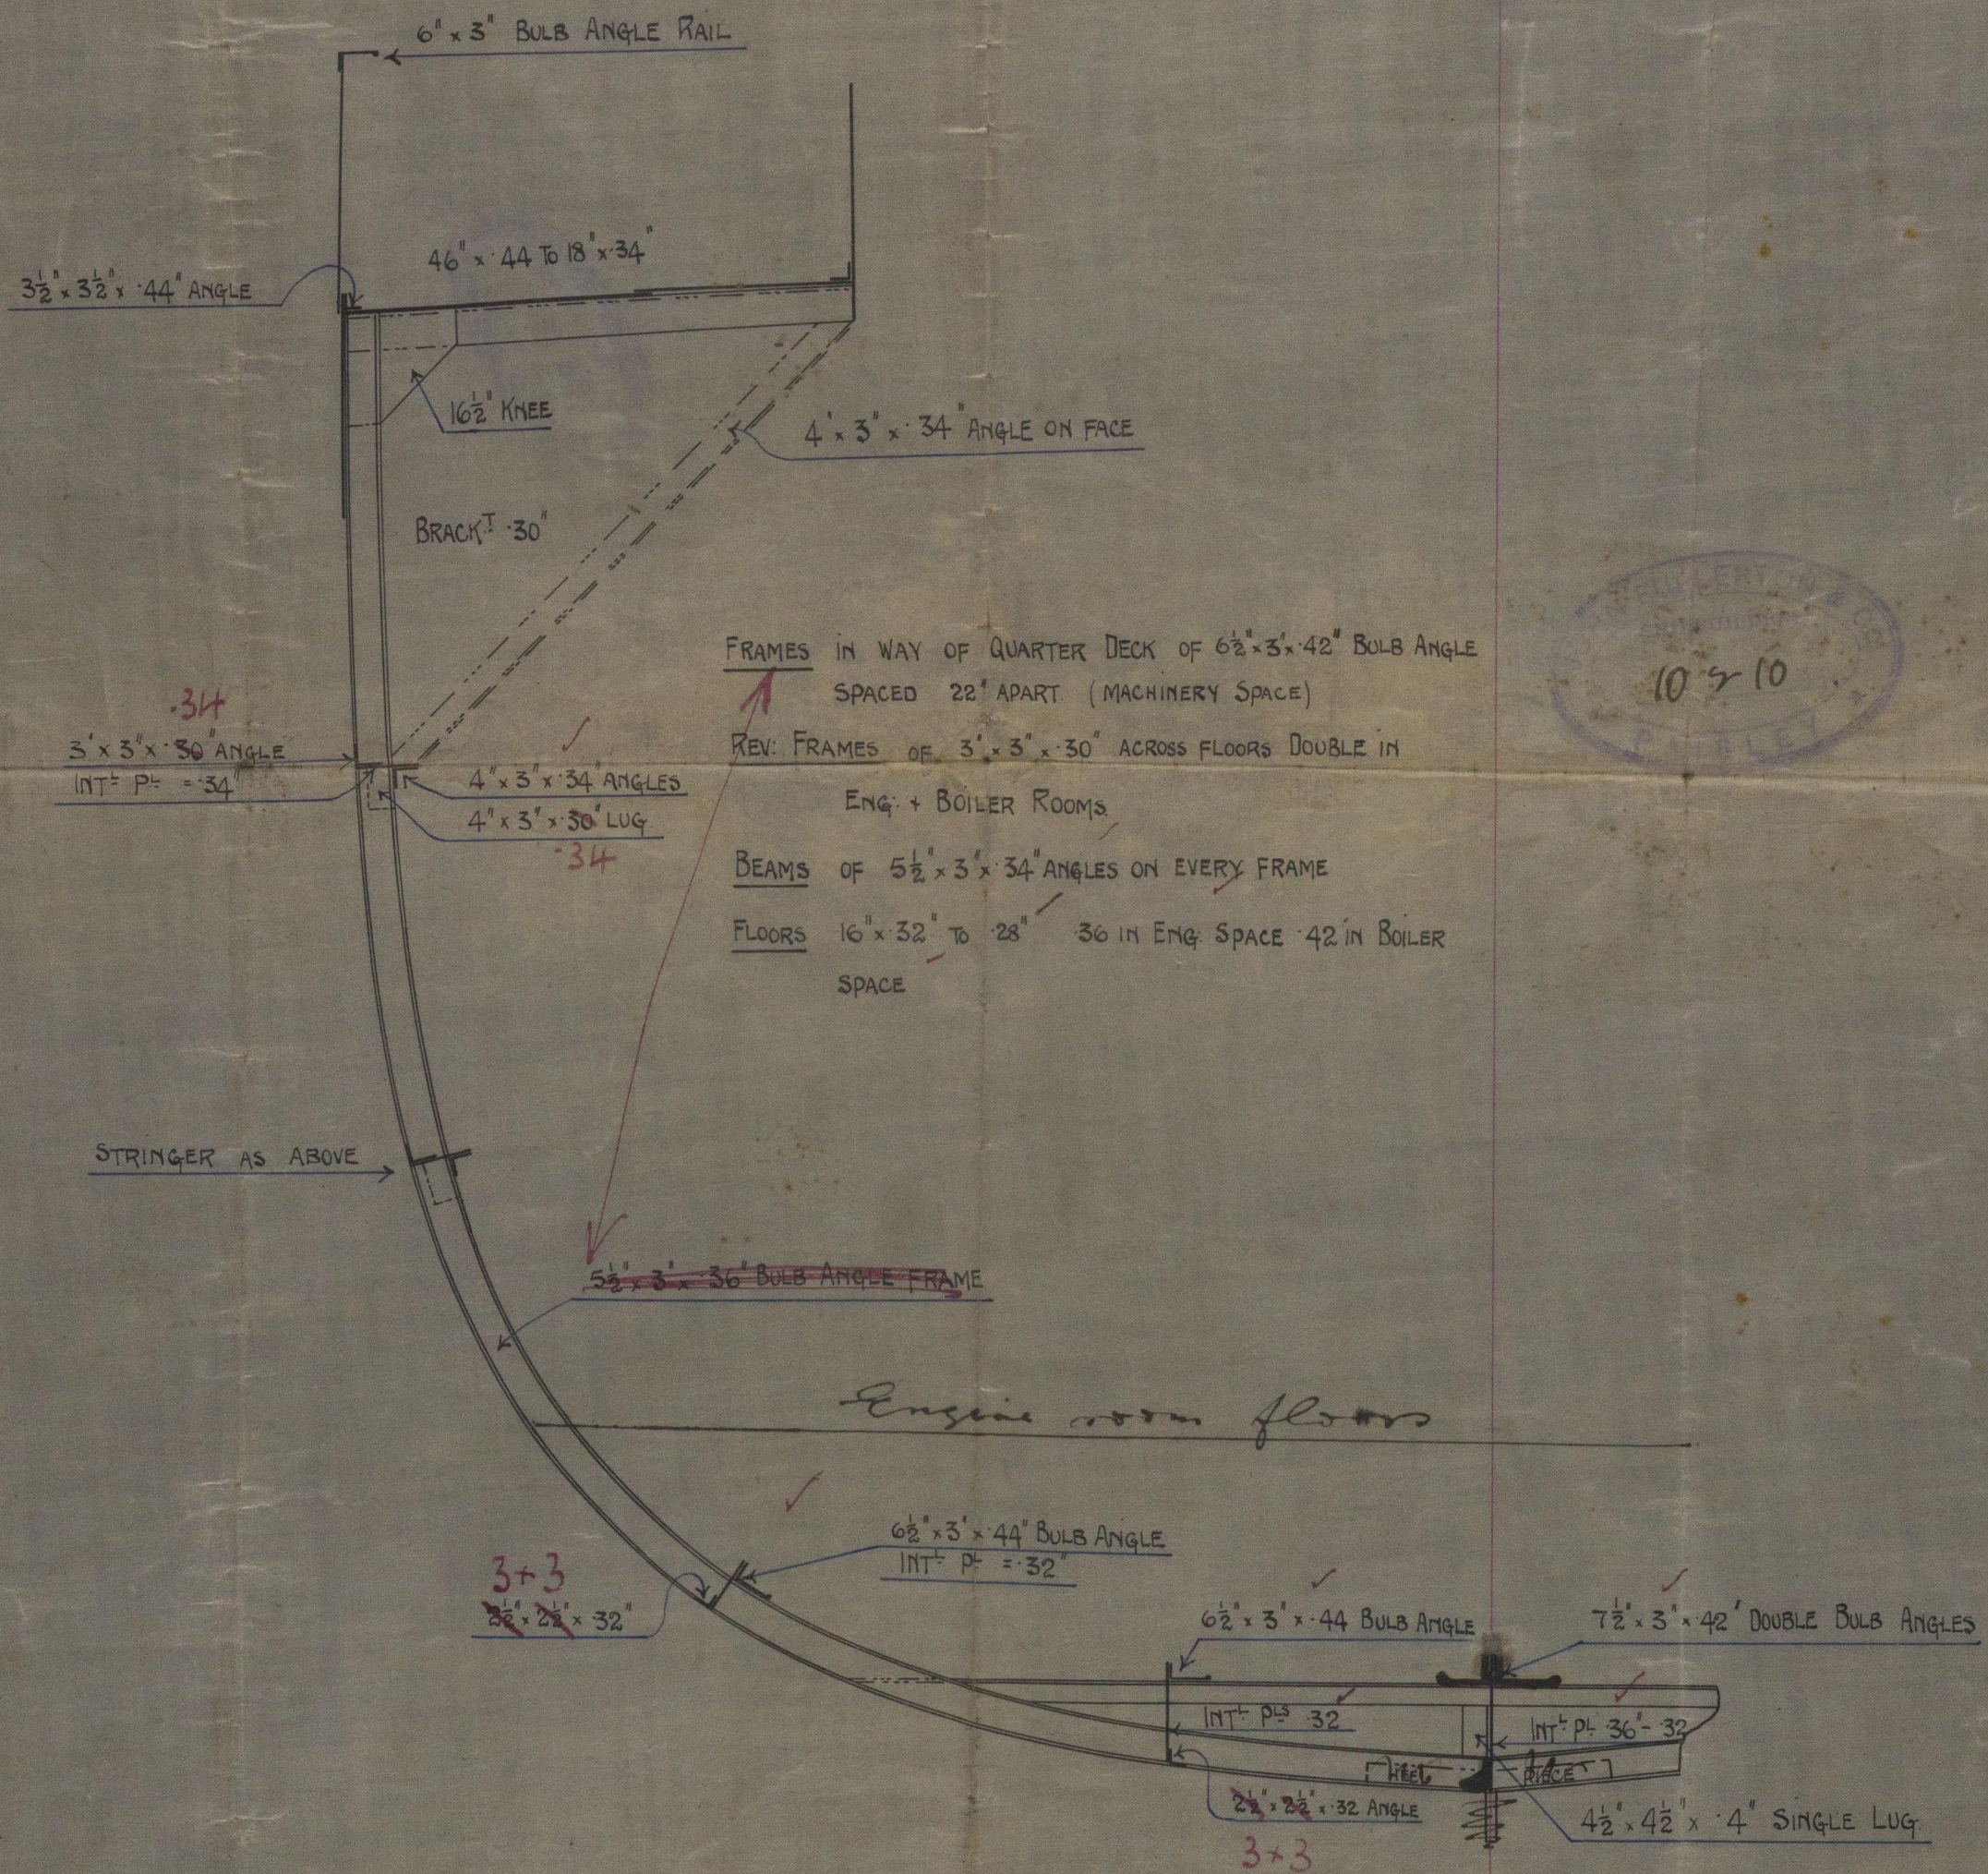

10-10

Double reverse frames fitted in bunkers space as well as E. & B. spaces

— FRAME N° 86 —

C.T.
21/2/10