


22.01.10
21.2.10
2.3.10
10.3.10
27.6.10

REMAIN

See Profile as Built



— PROFILE & DECK PLAN S. S. N^o 216 —

1/8" = 1 Foot.

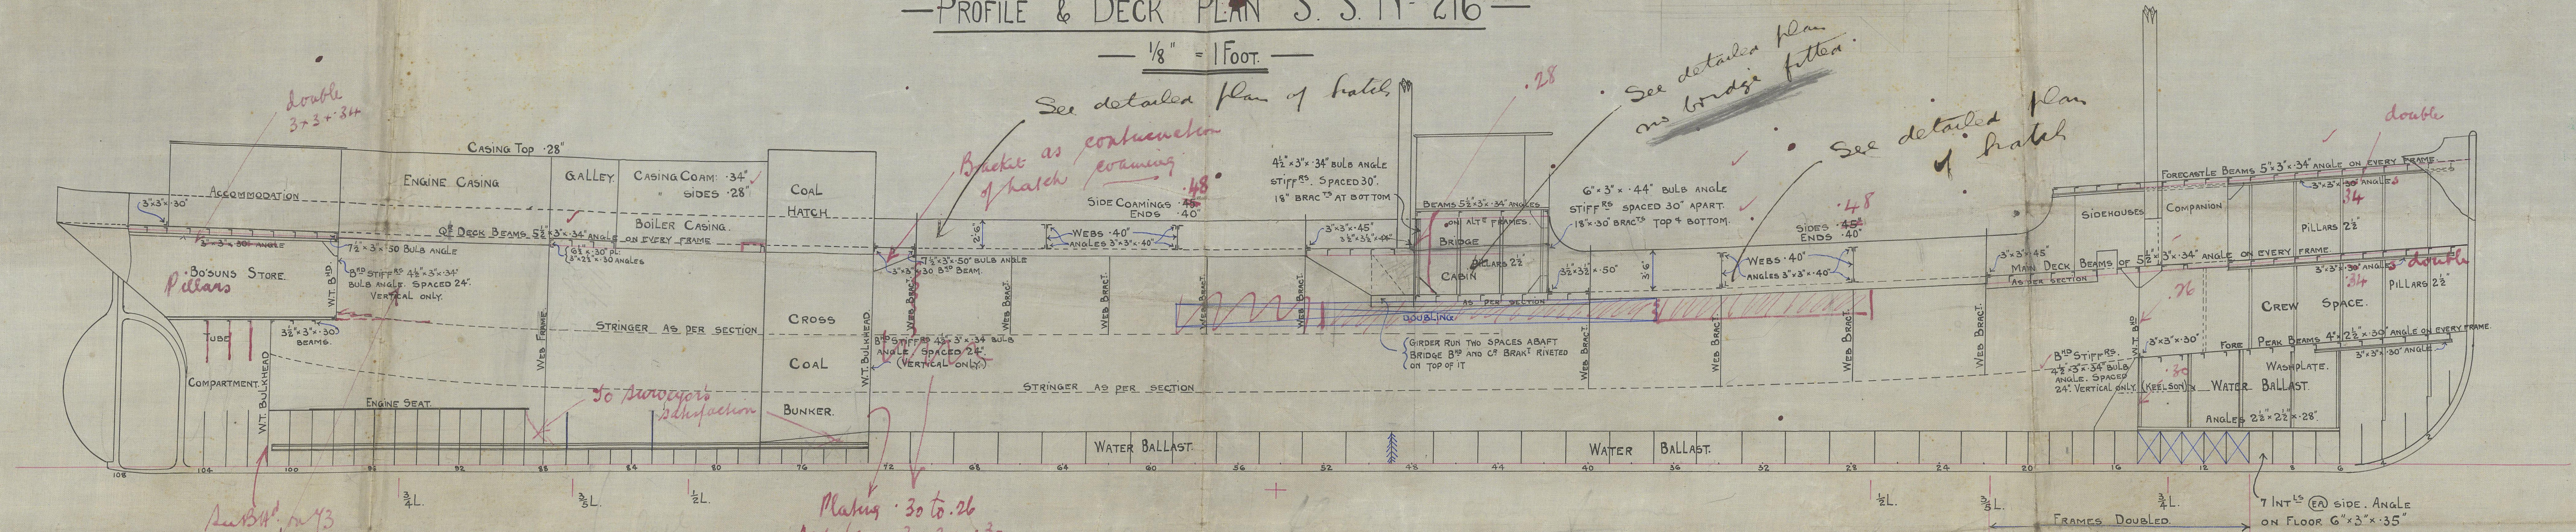

Sub B¹ 1/4 3
Stiffeners 1/2 3x3x30
hinges at 30"
if no waterballast

Plating 30 to 26
Deck bars 3x3x30
Stiffeners 1/2 4x4x42
+ Tank top
Stiffeners 1/2 3x40 B.A. spaced 30"
bracketed top and bottom.

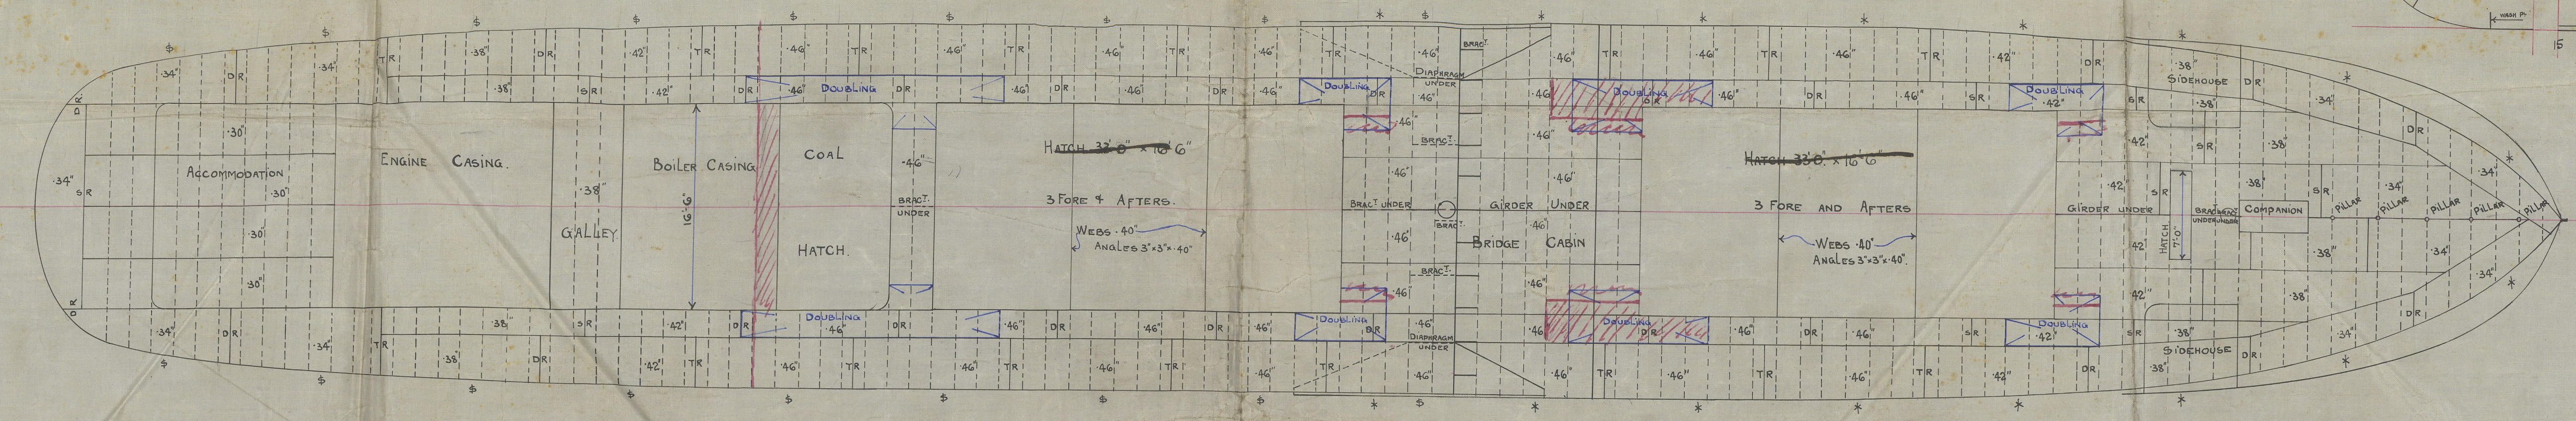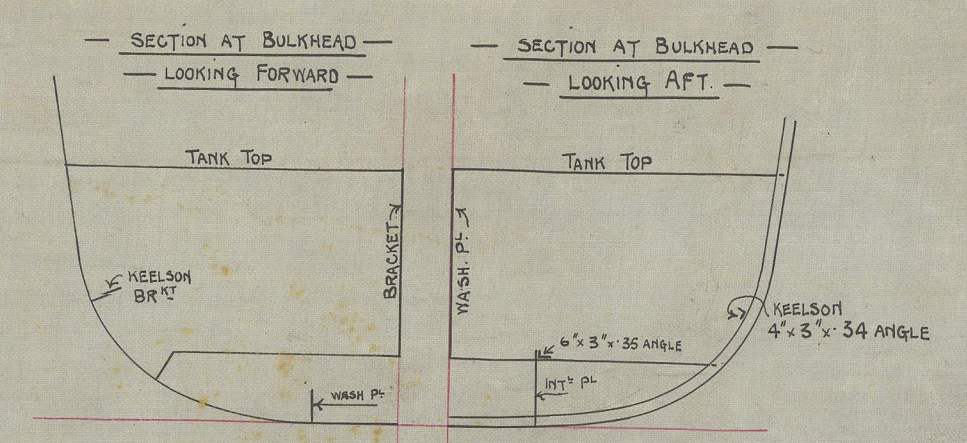

JOHN FULLERTON & CO.
SHIPBUILDERS
10.2.10
PAISLEY


C.T.
21/2/10

Profile & Deck Plan
Mess 9 Jullien 140
S.S. On 216

See Profile on
Built

GSGOW REPORT No.

29406

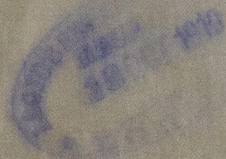

VI 455 - 0065.1

RETAIN



© 2020

Lloyd's Register
Foundation