



Profile in Board
 Cross Section 12
 22 No. 111

GLASGOW REPORT NO. 2240

RETAIN

— PROFILE AND DECK PLAN OF S.S. N°216 —

SCALE 1/4 INCH = ONE FOOT

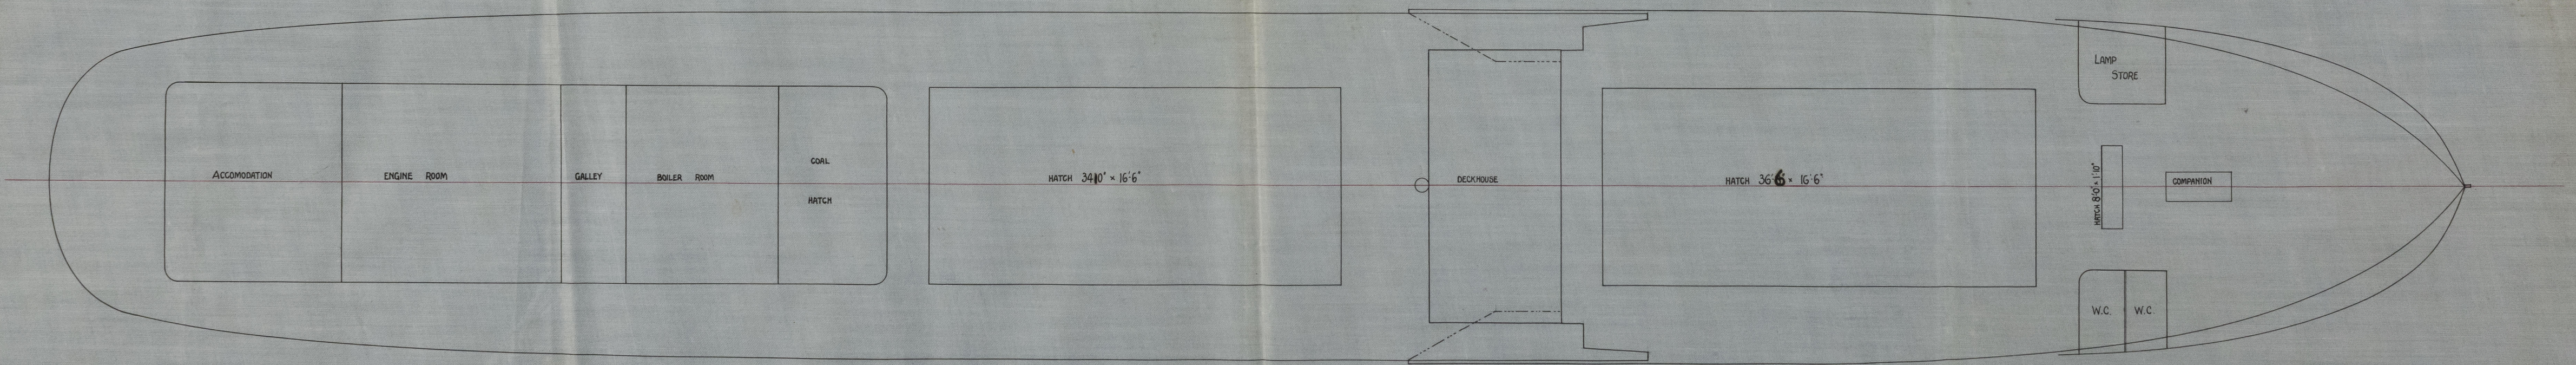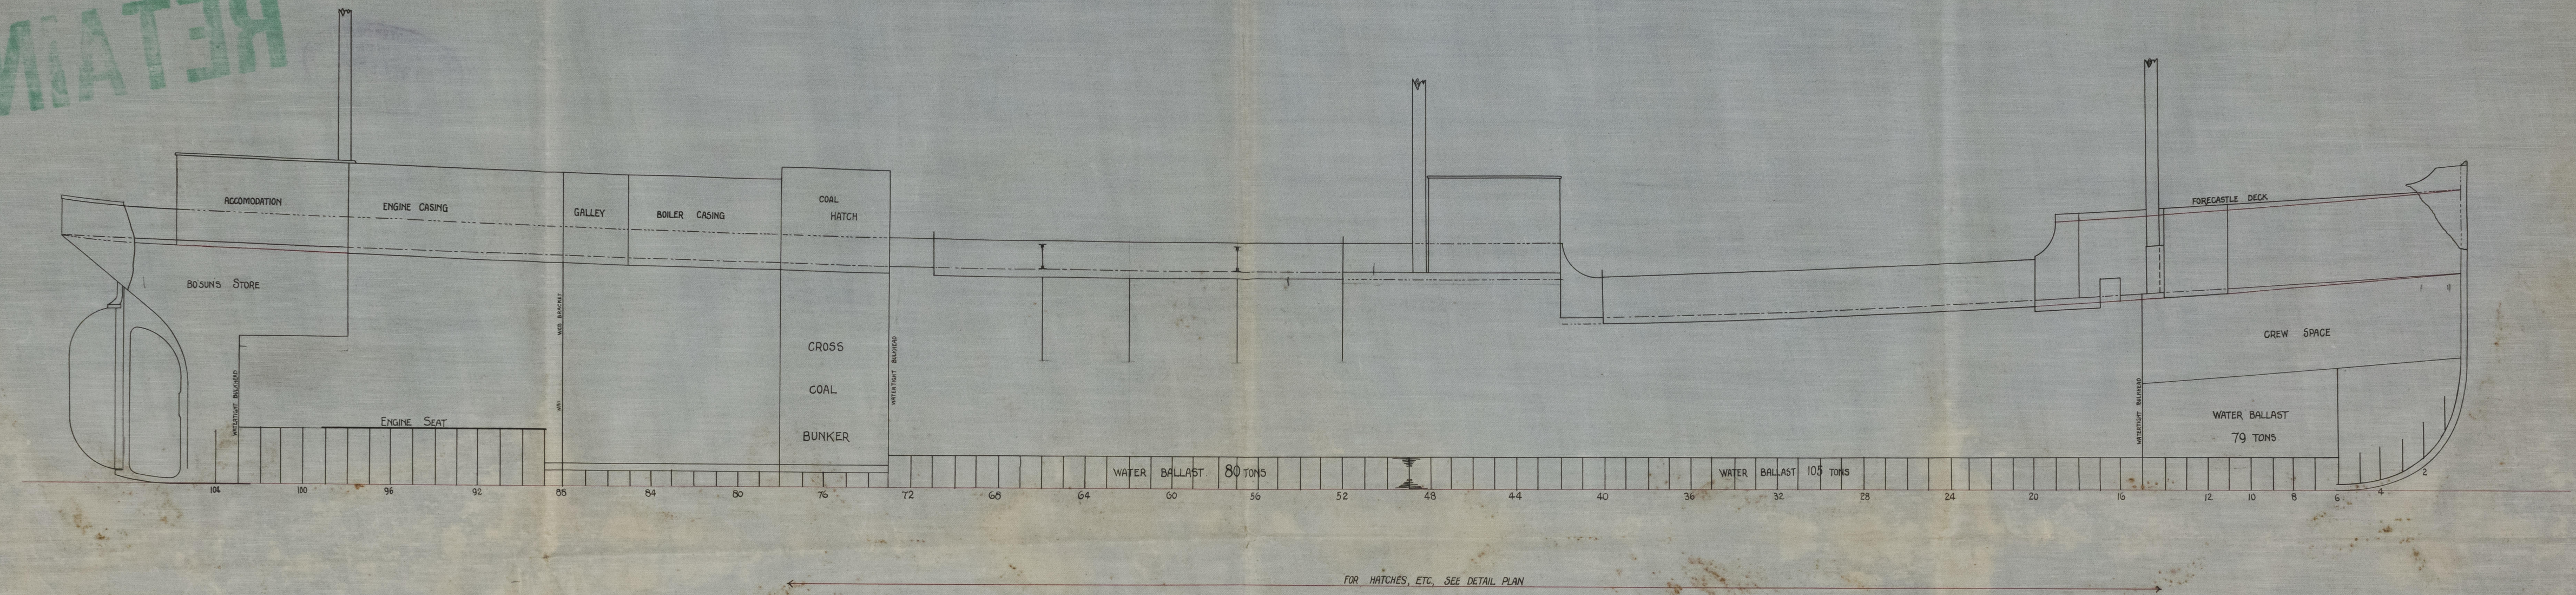


Profile as Built

Messrs J Pullerton & Co

S.S. No 216

GLASGOW REPORT No. 29406

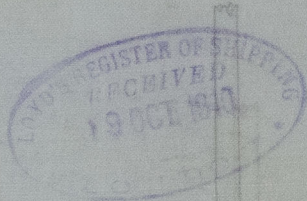

RETAIN

W455-0065



© 2020

Lloyd's Register
Foundation