

23.9.13  
4.10.13  
10.10.13  
20.10.13 (M507)

LENGTH B.P. 385'-0"  
BREADTH EXT. 53'-9"  
" MLD. 53'-5"  
DEPTH MLD. 26'-0 3/4"

S. S. N° 506. +507.

SCALE 1/2" = 1 FOOT.

NUMERALS:-  
BREADTH MLD. 53.41  
DEPTH " 26.06  
LENGTH = 385  
79.47 = FRAME N°  
50596 = LONGITUDE N°

EQUIPMENT NUMERALS:-  
B + D x L = 30596  
SHELTER DK ERECTION 385 x 8 x 75 2310  
CASING 66 x 7.25 x 5 239  
SALOON 25.5 x 7.5 x 5 96  
33241 = EQUIPMENT N°

FORGINGS:-  
RUDDER POST 9 x 7 1/2  
PROPELLER 10 x 7 1/2  
STEM 10 x 2 3/4

RUDDER:-  
A x D = UNDER 390,  
SPEED 10 KNOTS.  
RUDDER HEAD 9 DIA.  
PLAN WILL BE SUBMITTED.

HOLD PILLARS:- DOUBLE CHANNELS  
4-3 APART.  
14 TO 16 FT. 7 x 3 1/2 x 3 1/2 x 46  
16 " 18 " " " " 48  
22 TO 24 FT. 9 x 3 1/2 x 3 1/2 x 48  
24 " 26 " " " " 50  
26 " 28 " " " " 52  
28 " 30 " " " " 54  
RIVETTING OF PILLARS AS PER RULES.  
PILLARS AT DEEP HATCH END BEAMS  
TO BE INCREASED 'OH, & ALSO TO BE FITTED  
WITH FACE PLATES SAME THICKNESS AS  
CHANNELS, OR  
2 PILLARS 'OH LESS THAN THICKNESSES  
TABULATED ABOVE.



TANK TOP CENTRE STRAKE  
42 x 54 TO 44 IRON OR STEEL IN FORWARD HOLDS.  
66 x 52 " 42 " " " IN AFTER HOLDS.  
66 x 52 IRON OR STEEL, 56 IRON IN BOILER SPACE.  
BUTTS OVERLAPPED & TREBLE RIV. FOR 1/2 LTH.  
DOUBLE AT ENDS.


CENTRE KEELSON = 42 x 50 TO 40, 60 IN B.S.  
TREBLE RIV. OVERLAP BUTTS. 54 IRON IN E.S.

C.K. SINGLE TOP BAR 4 1/2 x 4 1/2 x 60 TO 56, 60 IN B.S.  
DOUBLE BARS 3 1/2 x 3 1/2 x 54 IRON IN E.S.

C.K. VERTICALS 6 x 6 x 46 SINGLE 1/2 LTH. 50 IN B.S.  
46 IN ENG. SPACE, 11 RIVETS IN EACH FLANGE.  
3 1/2 x 3 1/2 x 40 SINGLE AT ENDS.

C.K. BOTTOM BARS 4 1/2 x 4 1/2 x 60 TO 56.

FLAT PLATE KEEL 46 x 96 FOR 3/5 LTH.  
WITH 18 RIVETS IN BUTTS, 1 IN SEAMS. (1 1/2 beam rivets in 507)  
TO 68 AT ENDS, WITH 1 RIVETS IN BUTTS  
& 75 " " SEAMS.  
QUAD. RIV. OVERLAP BUTTS FOR 3/5 LENGTH  
TREBLE AT ENDS WHERE NOT EXCEEDING 76.

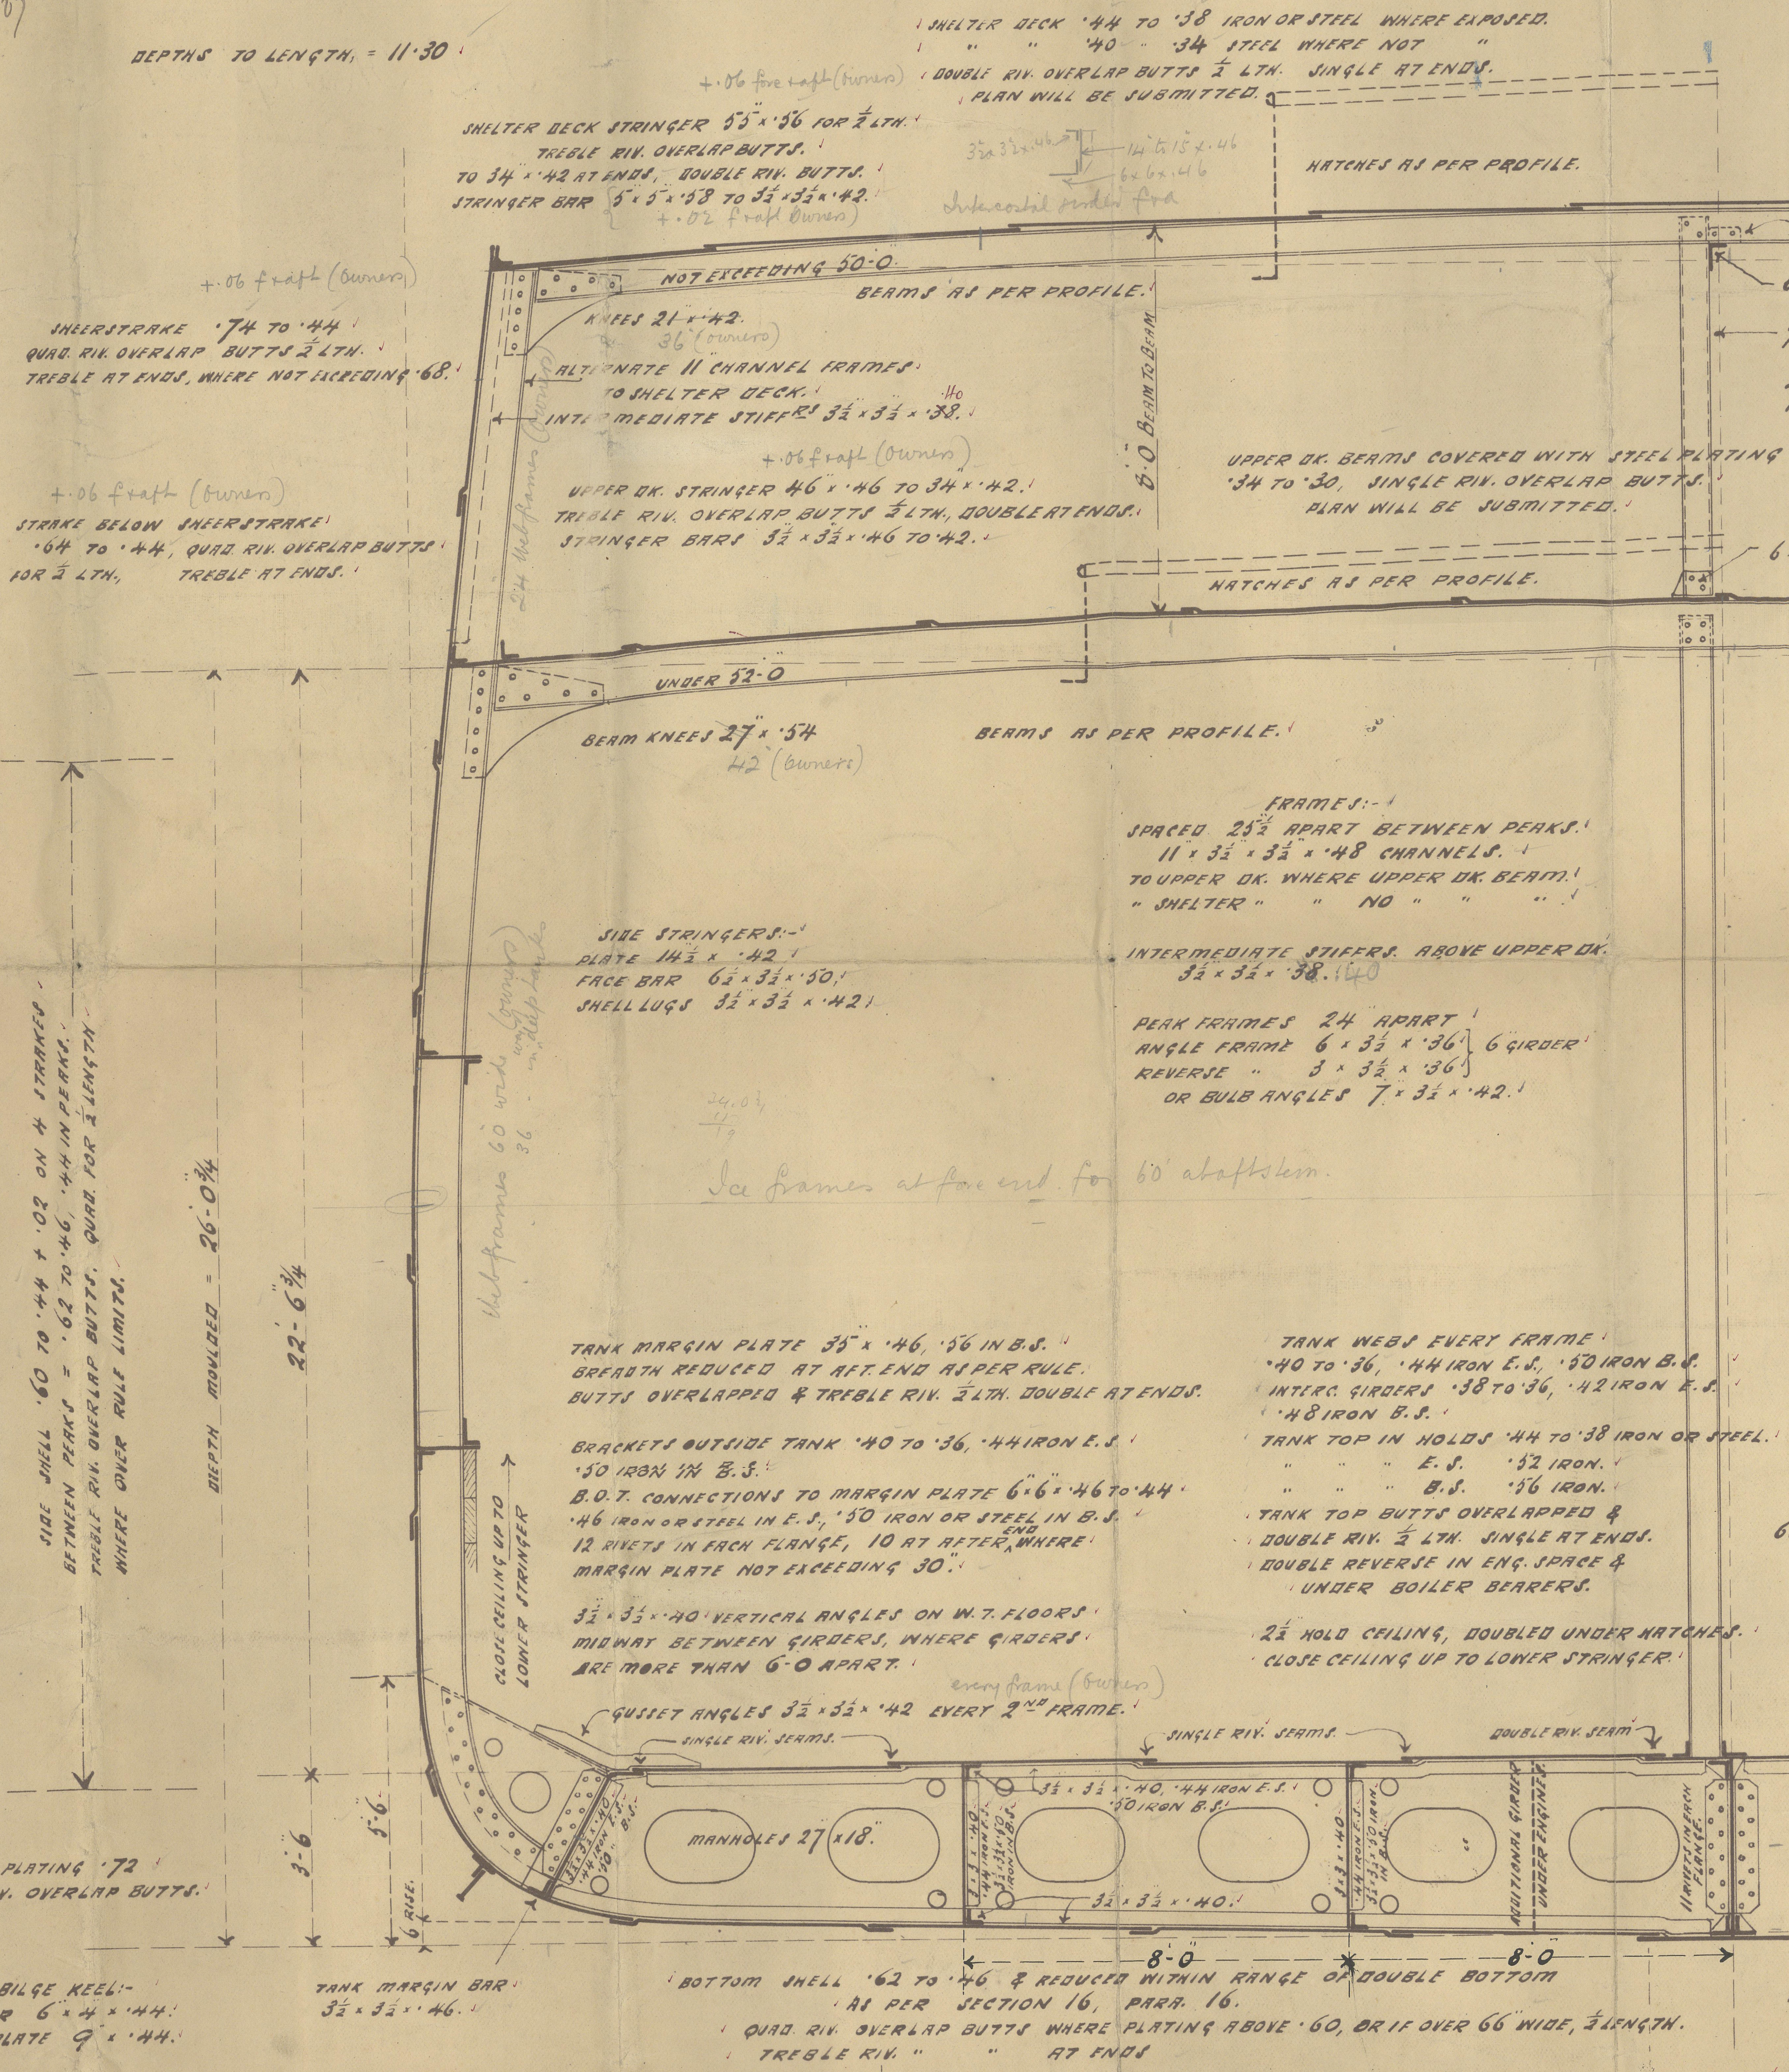




6429  
506  
16.9.13  
SUNDERLAND



Midship  
Section

No 506

J. L. Thompson

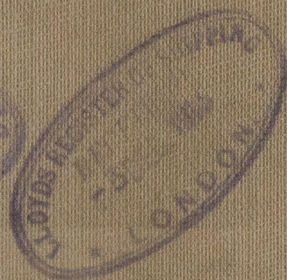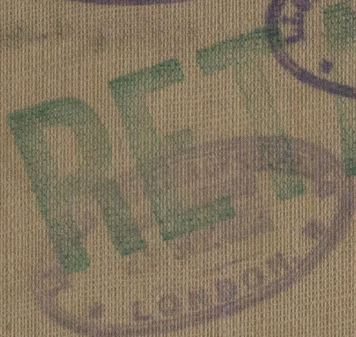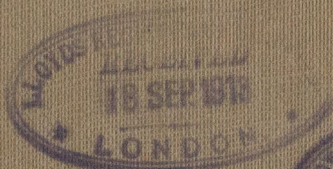

W455-0135

506

S. S. Bodern

Sld. Rpt. No. 26116

507

S. S. NARVIK

Sld. Rpt. No 26161