

35514

C 12(a).

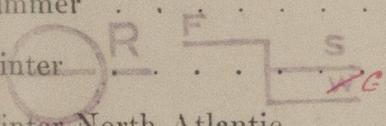
# FREEBOARD VERIFICATION FORM FOR ORDINARY CARGO <sup>AND</sup><sub>OR</sub> PASSENGER SHIPS.

When received in London Office MAR 14 1938

Port Belfast.  
 Name "Munster"  
 Official No. 166226. No. in Reg. Book 30386.  
 Port of Registry Galvin Gross Tonnage 4320 <sup>4302</sup> Signal Letters ✓  
 Material Steel. State whether Classed by Lloyd's Register Yes.  
 Name of Owners Coast Lines Ltd. Date of Verification March 12th 1938

and only whist engaged in Irish Channel Service  
 When more than 12 passengers are carried the freeboard  
 of the ship shall be governed by the terms of the  
 of Passengers and Safety Certificate.

I have to report that the Freeboards as given below, assigned by the Committee to this ship, have been correctly marked on the ship's sides, in accordance with the printed instructions:—

FREEBOARD AMIDSHIPS FROM TOP OF DECK LINE, WOOD/STEEL DECK.	FROM CENTRE OF DISC.
Tropical Fresh Water . . . . . - ft. - ins.	- ins. above
Fresh Water . . . . . 3 ft. 8 ins.	3 <sup>3</sup> / <sub>4</sub> ins. above
Tropical . . . . . - ft. - ins.	ins. above
Summer . . . . . 3 ft. 11 <sup>3</sup> / <sub>4</sub> ins.	
Winter  . . . . . 4 ft. 3 <sup>1</sup> / <sub>2</sub> ins.	3 <sup>3</sup> / <sub>4</sub> ins. below
Winter North Atlantic . . . . . ft. ins.	ins. below

Minimum Summer Draught corresponding to the freeboard assigned as shown on Builders' Displacement Scales:—

A. P. Scott. Surveyor.

(To be filled up in London Office.)

Commitment No. 35514 Date of Committee's Minute 14-1-38

Particulars for Record Register Book.	Moulded Depth . . . . .	19	ft.	0	ins.
	Freeboard . . . . .	3	ft.	11 <sup>3</sup> / <sub>4</sub>	ins.
	Corresponding Draught	15	ft.	1 <sup>1</sup> / <sub>4</sub>	ins.

Freeboards compared and found correct by L. W. B. Date 14/3/38

Fee paid? Form for Certificate Irish Free State - 4/3/38

Certificate written 14/3/38 Noted for posting (Spec. L. L. 3 enclosed)

W456-0112

© 2020 Lloyd's Register Foundation