

# Lloyd's Register of Shipping

## SURVEYS FOR FREEBOARD.—STEAM SHIPS.

PARTICULARS RELATING TO ALL STEAM SHIPS EITHER FLUSH DECKED, OR WITH TOP GALLANT FORECASTLES, SHORT POOPS AND BRIDGE HOUSES DISCONNECTED, OR WITH TOP GALLANT FORECASTLES HAVING LONG POOPS, OR RAISED QUARTER DECKS CONNECTED WITH BRIDGE HOUSES, OR OTHERWISE.

MESS<sup>RS</sup> THE WEAR SHIPYARD (W. GRAY & CO. LTD. SUNDERLAND) N° 931

Ship's Name.	Port of Registry and Nationality.	Official Number.	Gross Tonnage.	Date of Build.	Particulars of Classification.
"GOLCONDA" Ex "WAR OWL" 542	GLASGOW BRITISH	✓	141919	1919	+100 A.I. STEEL (CONTENDED)
Number in Register Book					
Registered dimensions from Ship's Register.	LENGTH.	BREADTH.	DEPTH.	UNDER DECK TONNAGE.	
	400.0	52.3	28.45	4849.52	
Length on LOADLINE.	399.5	Frame Depth 10 Rule 6	Ceiling +.20 Sheer +1.15 33x2 = .66 1/8 IRON SPARRING = +.23	Tank Level Peak } INCLUDED Tanks	
END NS.	399.5	51.87	29.80	4849.52	
ent of fineness.....	78				
ification necessary { a. 4 (a) to (e)]*	-02	CELLULAR DOUBLE BOTTOM			
ient as corrected .....	76				
Stem.....	120			50.62 ÷ 55 = 92.04	
Sternpost ...	60.5			180.5 ÷ 2 = 90.25	Mean
t 1/2 of the length from { Stem 67.25					Mean
midships Sternpost 34				101.25 ÷ 2 = 50.62	
l mean Sheer ..... 90.25 + 92.04				91.14	
rd mean Sheer [Table, Para. 18] ..... 49.95				Correction	
Difference..... 41.19				÷ 4 = 10.29	
nited as Para. 18 (f) .....				- 10 1/4	
in Sheer { At front of bridge house.....					
midships { At after end of forecastle .....					
18 (e)] NO DROP IN SHEER ✗					
in Sheer { 18 (d) {				÷ 2 =	
uncovered .....				Correction	
ALLOWANCE FOR DECK ERECTIONS :—					
ard, Table C.....				4.9 1/2	
ion for Length, if required (Para. 12, 13, and 14) .....				2 1/4	
ard by Table A. corrected for sheer, and for length, { if required (Para. 12, 13, and 14) .....				4.11 1/4	
nce .....				7.5 1/4	
age as below.....				2.5 1/2	
				32.20	
				= 9.50	
on for R. Q. Dk. if engine and boiler openings not covered by bridge house (Para. 11) .....				- 9 1/2 "	
nce for Deck Erections .....					
Length.....	Length.	Length allowed.	Height.		
House.....	28.33	38.33	7.95		
House.....	113.16	113.16	7.95		
nd Qr. Dk.....					
	49.25	49.25	7.95		
Total .....				200.74 = 50.25	
Length of Ship .....				399.5	
Corresponding percentage { 12 or 14) .....				32.20	
ded amidships from centre of Disc to top of Statutory Deck Line, Wood (Iron) Deck :—					
Fresh Water Line .....		above centre of Disc			
ian Summer Line .....		" " "			
ater Line .....		below "	"		
North Atlantic Line .....		" "	"		

usual thickness the breadth of vessel to inside of the top of the amidship beam. In the case of a vessel having a raised quarter deck, the sheer measured at the stem and stern posts is the sheer measured at points distant

State dimensions of freeing port area on back of this form.

The Surveyor should state whether the fall in sheer as reported is measured relatively to the straight line of keel or to the water line. If measured relatively to water line the vessel's draft at time of survey, and also the usual load draft forward and aft should be reported.

NOTE.—If the depth is measured when vessel is afloat, the details of measurement should be reported.

NOTE.—The round of beam should be reported on the full breadth of vessel at the gunwale.

6.6  
6.0 1/2  
5.7

6.7 1/2  
6.2 1/2  
5.8 1/2

6.2  
7  
5 1/2  
5 1/2

2020

Do all the Frames extend to the top height in the Poop?  ALTERNATE WITH Raised Quarter Deck?  INTERMEDIATE FRAMES

Bridge House?  ALTERNATE Forecastle?

To what height do the Reverse Frames extend?

Has the Poop or Raised Quarter Deck an efficient Iron Bulkhead at the fore end?

BULB ANGLE FRAMES

YES

Give particulars of the means for closing the openings in Bulkhead HINGED STEEL DOORS TO STEEL HOUSES

Is the Poop or Raised Quarter Deck connected with the Bridge House?

NO

Has the Bridge House an efficient Bulkhead at the fore end?

Give particulars of the means for closing the openings in Bulkhead  HINGED W.T. DOORS AT FORE END

What is the thickness of the Bridge Front plating? 40 and Coaming plate? 44

Give scantlings and spacing of the stiffeners 9 x 3 1/2 x 58 BULB ANGLE SPACED 30"

Are bracket plates fitted at each end of the stiffeners? YES

Are hor'l. brackets fitted connecting Bridge Bulk'd. with Bulwarks?

YES

Has the Bridge House an efficient Iron Bulkhead at the after end? YES

SHIFTING BOARDS FULL HEIGHT IN RIVETED CHANNELS

Is the Forecastle at least as high as the main or top-gallant rail? YES

Has the Forecastle an efficient Iron Wood Bulk'd. at after end?

Are the Engine and Boiler openings covered by a Bridge, Poop, Raised Quarter Deck, or enclosed by a Flying Iron or Steel Deckhouse?

YES

If the openings are not so protected are the exposed parts of the Casings efficiently constructed?

Give thickness of plating; scantlings and spacing of stiffeners

What is the height of the exposed Casings? 7'6"

Are suitable means provided for closing all openings in them in bad weather? YES

Are the Weather Deck Hatchways efficiently constructed and at least equal to the

requirements of Section 28 of the Rules for 1904-5? Give particulars below:—

Position and Size.	N°1 FOR 32'-6" x 20'-0"	N°2 34'-8" x 20'-0"	N°3 34'-8 x 20-0	N°4 28'-2" x 20'-0"				
Item.	Ship.	Rule.	Ship.	Rule.	Ship.	Rule.	Ship.	Rule.
COAMING								
Height above top of DECK	30	24	30	24	30	24	30	24
Sides.....	.44	.44	.44	.44	.44	.44	.44	.44
Thickness { Ends.....	.44	.44	.44	.44	.44	.44	.44	.44
SHIFTING BEAMS OR WEB PLATES.	Number .....	6	6	6	6	5	5	
Section and Scantlings .....			Top Bar, 4 x 3 x .44 Plate 18 x 11 x .36 Bottom Bar 7 x 3 1/2 x .58 STEEL		All webs as per sketch			
Material .....	STEEL		STEEL		STEEL			
* FORE AND AFTERS.	Number .....		No FORE AND	AFTERS				
Section and Scantlings .....								
Material .....								
HATCHES Thickness .....	2 1/2	2 1/2	2 1/2	2 1/2	2 1/2	2 1/2	2 1/2	2 1/2
Remarks.....	SATISFACTORY							

\* The depth of Fore and Afters should be stated from the underside of the hatches in all cases.

(If the sill of the lowest side scuttle will be less than 6 inches above the Indian Summer Load Line if assigned under the tables, state vertical distance from top of deck at side amidships to lower edge of lowest side scuttle.)

The following information is to be given in all Cases of vessels dealt with under Paras. 11, 12 (under 15 feet Moulded depth) and under Shelter Deck Rules.

What is the thickness of the Bridge Sheerstrake? ✓ Strake between Main and Bridge Sheerstrakes?

Delete the words {The Crew are, are not, berthed in the bridge house.

that do not apply {The arrangements to enable them to get backwards and forwards from their quarters are, are not satisfactory.



Length of Bulwarks in well

Area of Freeing Ports required by Paras. 11 (e) each side of vessel = Sq. ft.

Ft. Tenth. Ft. Tenth. No.

x x x x Freeing Ports (each side of vessel) = Sq. ft.

Total deficiency or excess = Sq. ft.

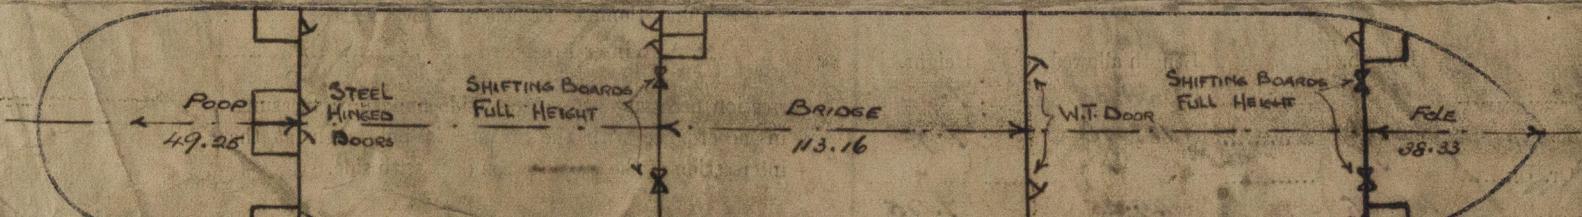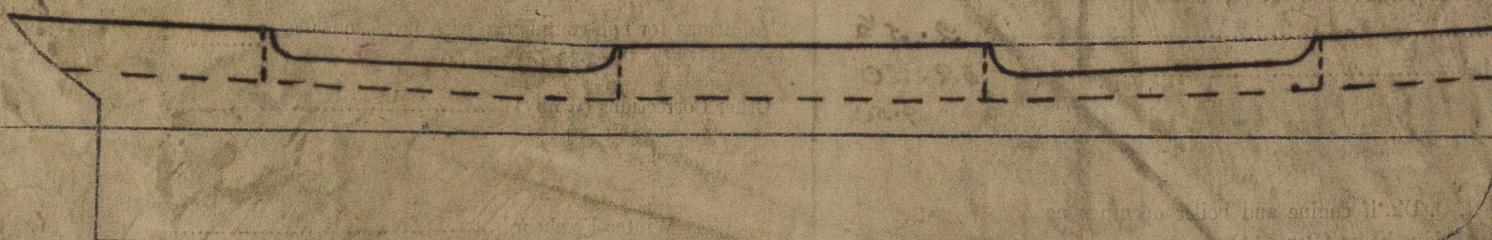

Show hereon line of Floors or Tank Top with position of any Breaks in same; also height of Peak Tank tops, &c., &c.

State any special features in the construction of the Vessel

THIS VESSEL IS OF THE STANDARD B TYPE AND H

BUILT IN ACCORDANCE WITH THE APPROVED PLANS.

Owners

Address

Fee D

7 : 1 - 0

Received by me 14.10.19 P.B.N.

