


2.4.14

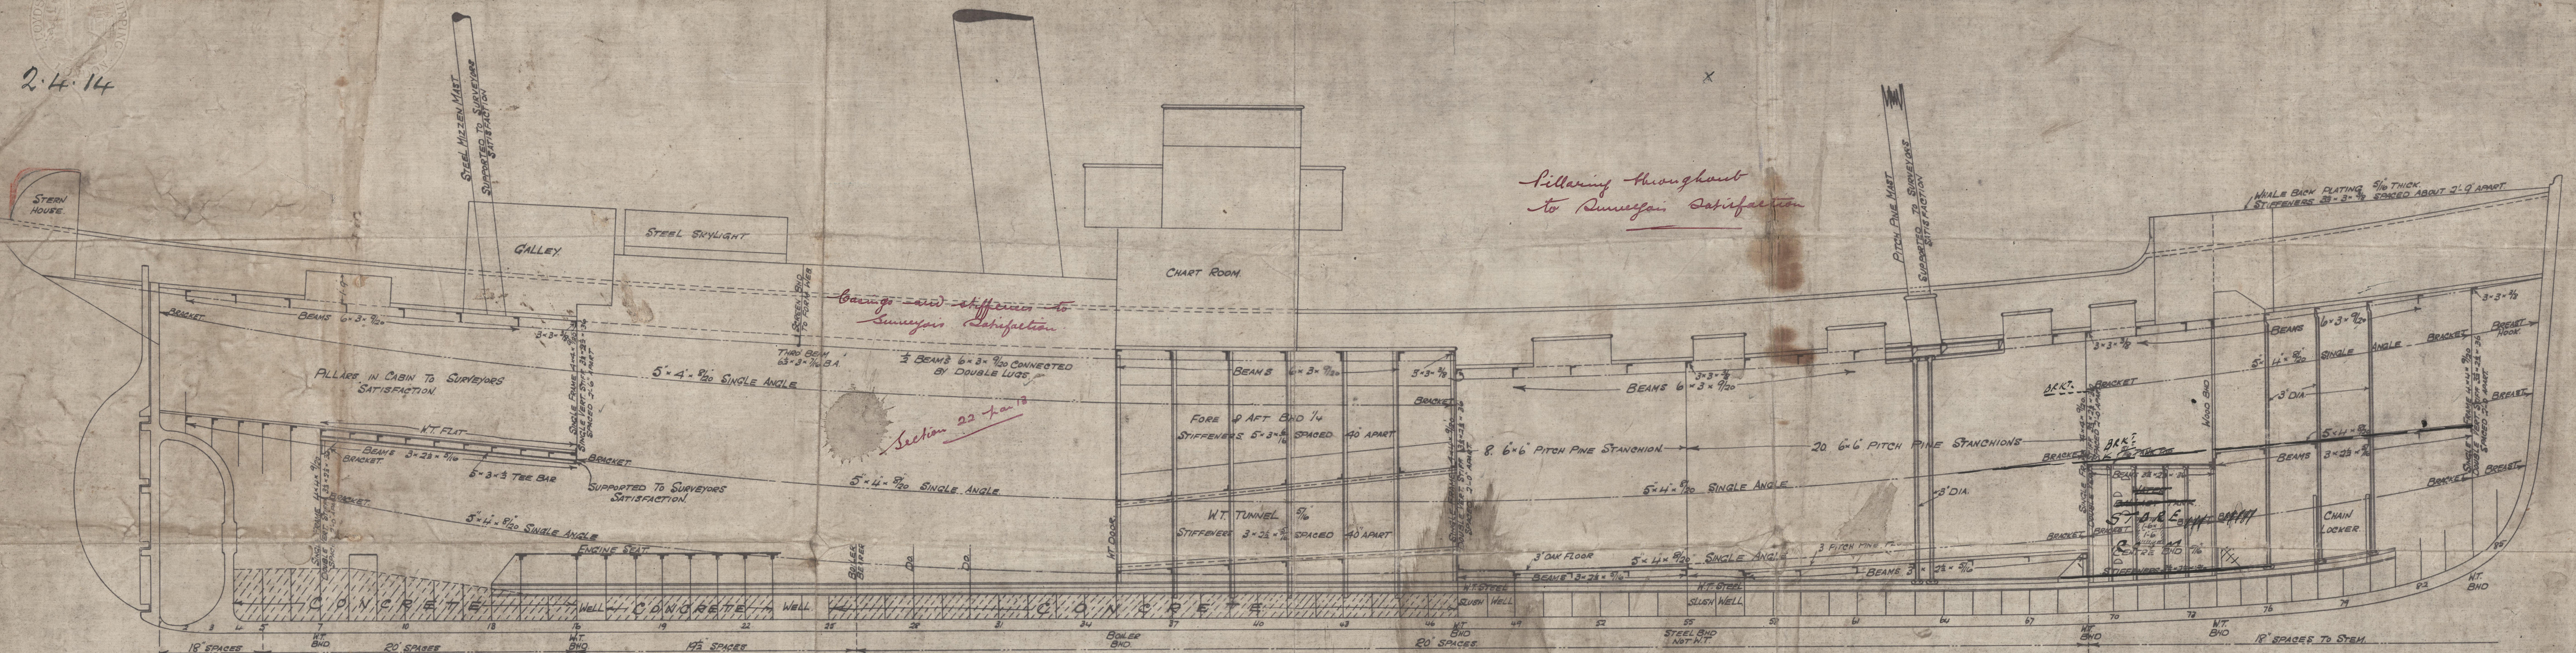


# BEAM ARRANGEMENT.

DIMENSIONS: 140'-0" BP x 24'-0" MLD x 13'-10" MLD  
SCALE 1/4" = 1 FOOT  
PILLARING THROUGHOUT TO SURVEYOR'S SATISFACTION.

N<sup>os</sup> 309-10-11 & 15.

SUBMITTED TO LLOYDS 1914  
APPROVED BY LLOYDS 1914

COOK, WELTON & GEMMELL LTD  
SHIPBUILDERS  
BEVERLEY

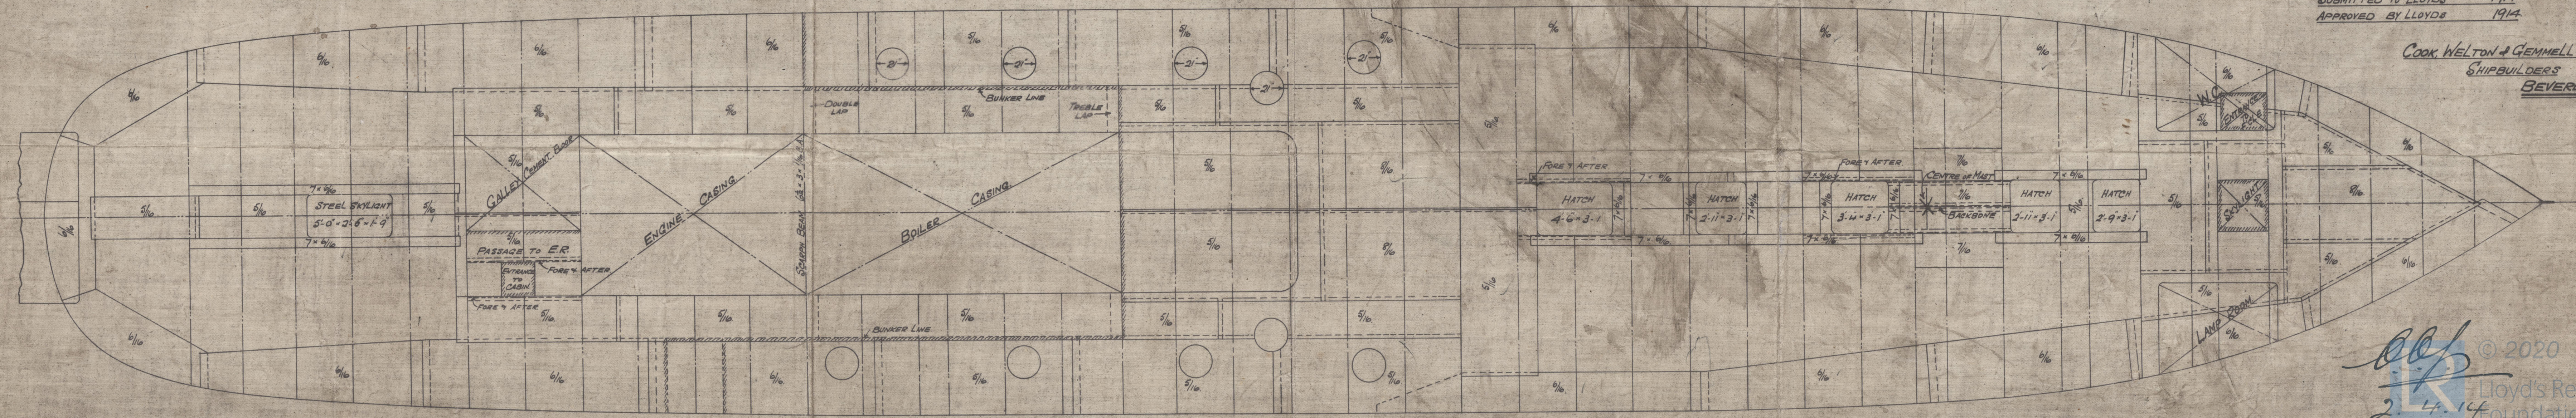



Cork welln. St. Emmells' Cork welln. St. Emmells' No. 309.10.11415.  
~~Cork welln. St. Emmells' No. 309.10.11415.~~

Profits & Dech

1/2 "Sir John French" No. 310

Hull Rpt. No. 28387


1/2 "Lord Fisher" Hull Rpt. No. 28422

*Kopans*

No. 311.

1/2 "Sir John Jellicoe" Hull Rpt. 28510  
1/2 "Lord Haldane" 28510

No. 3

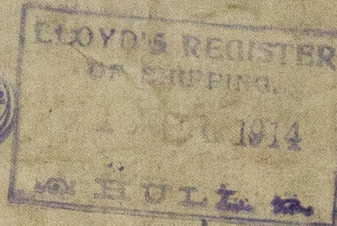

W46-0180

