

5.9.03
10.9.03


WATER

Nº 36
DIMENSIONS 142' x 26' x 12'-3" M.L.D.


SCALE 1/4" = 1 FT

PROFILE

JOHN SHEARER & SONS
SHIPBUILDERS LTD
DATE 1.7.03
10-10-19
KELVINHAUGH SLIP DOCK
GLASGOW

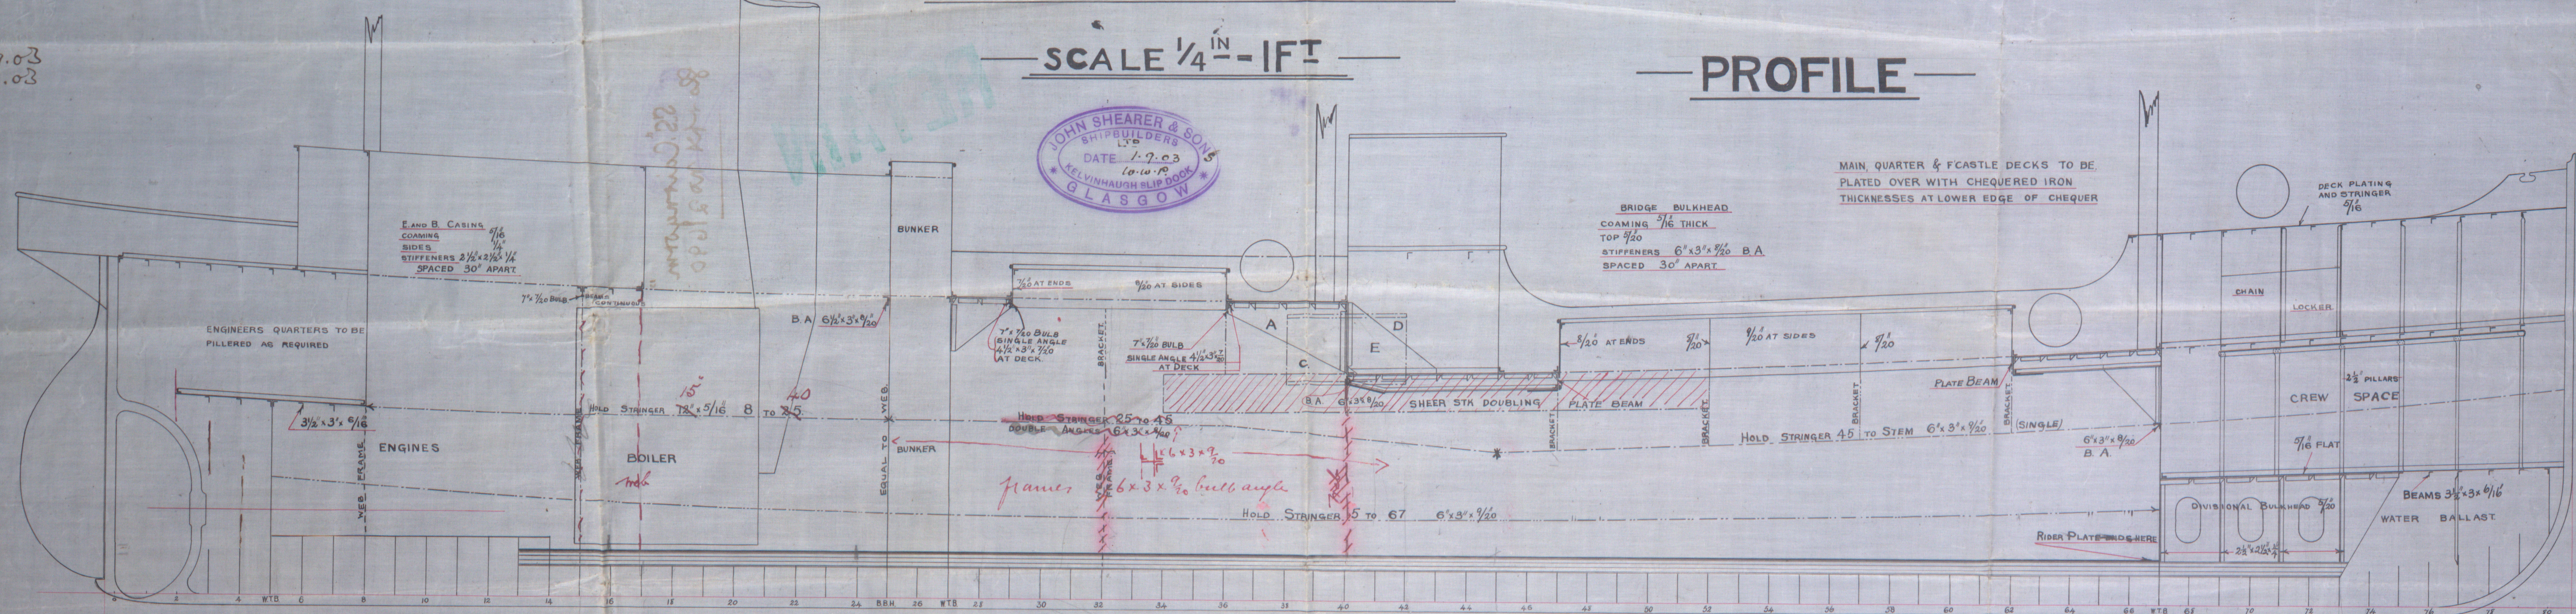

PLAN OF MAIN AND QUARTER DECKS

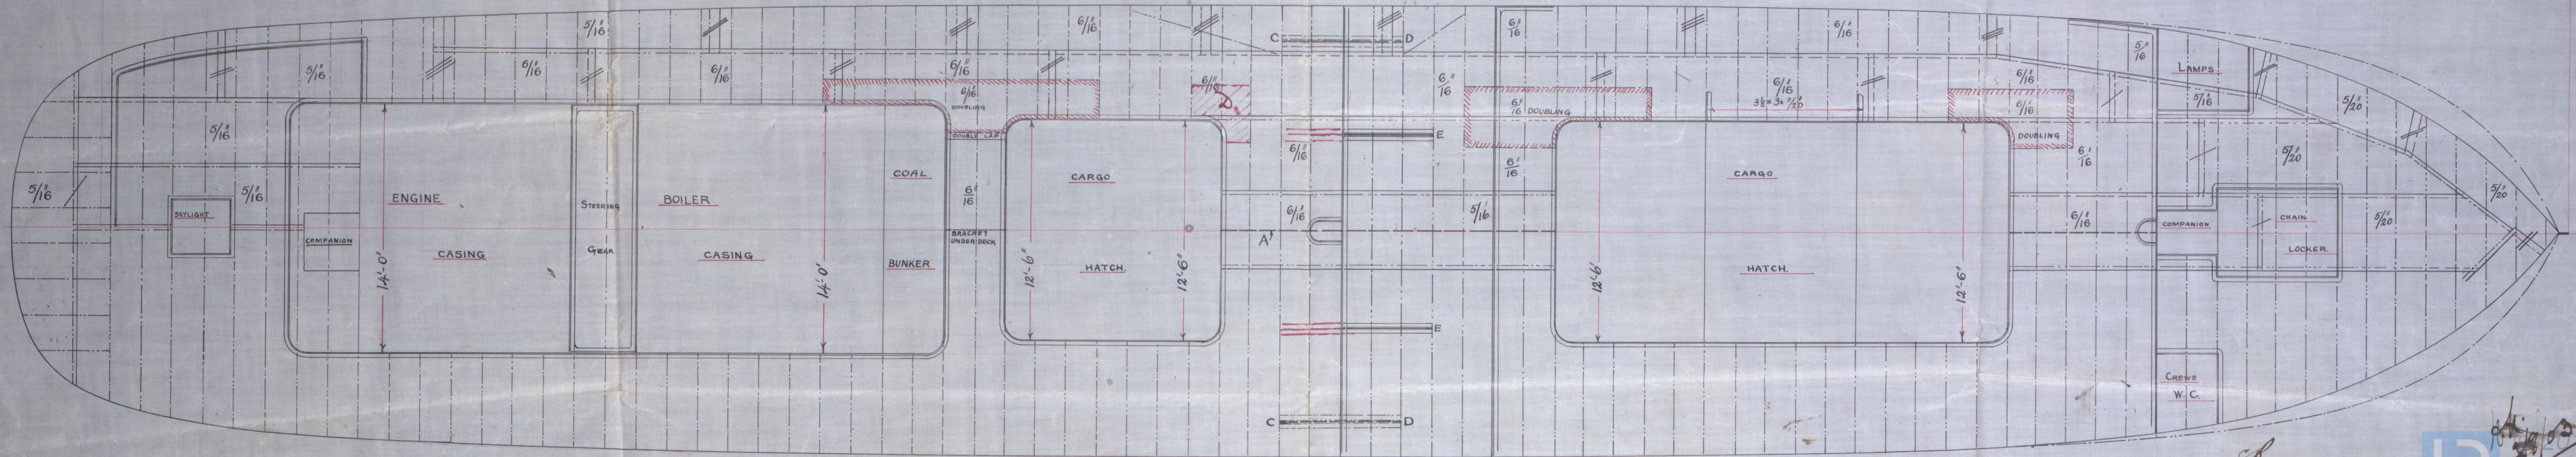

C.B.
4.9.03.

RETAIN

No 30


DIMENSIONS 145 x 100

SCALE 1/4 IN

RETAIN

S.S. Cairngorm
No 21690

W465-0112

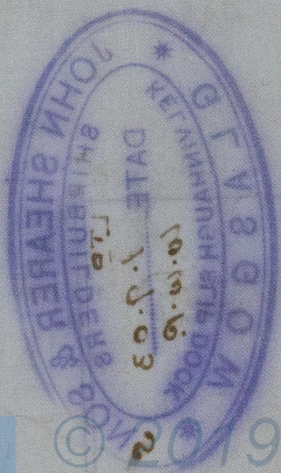

© 2019

Lloyd's Register
Foundation