


— SCALE $\frac{1}{2}$ IN. = 1 FOOT —

5.9.03
10.9.03

— SECTION IN WAY OF —
— WEB FRAME —

— SECTION IN WAY OF —
— QUARTER DECK —

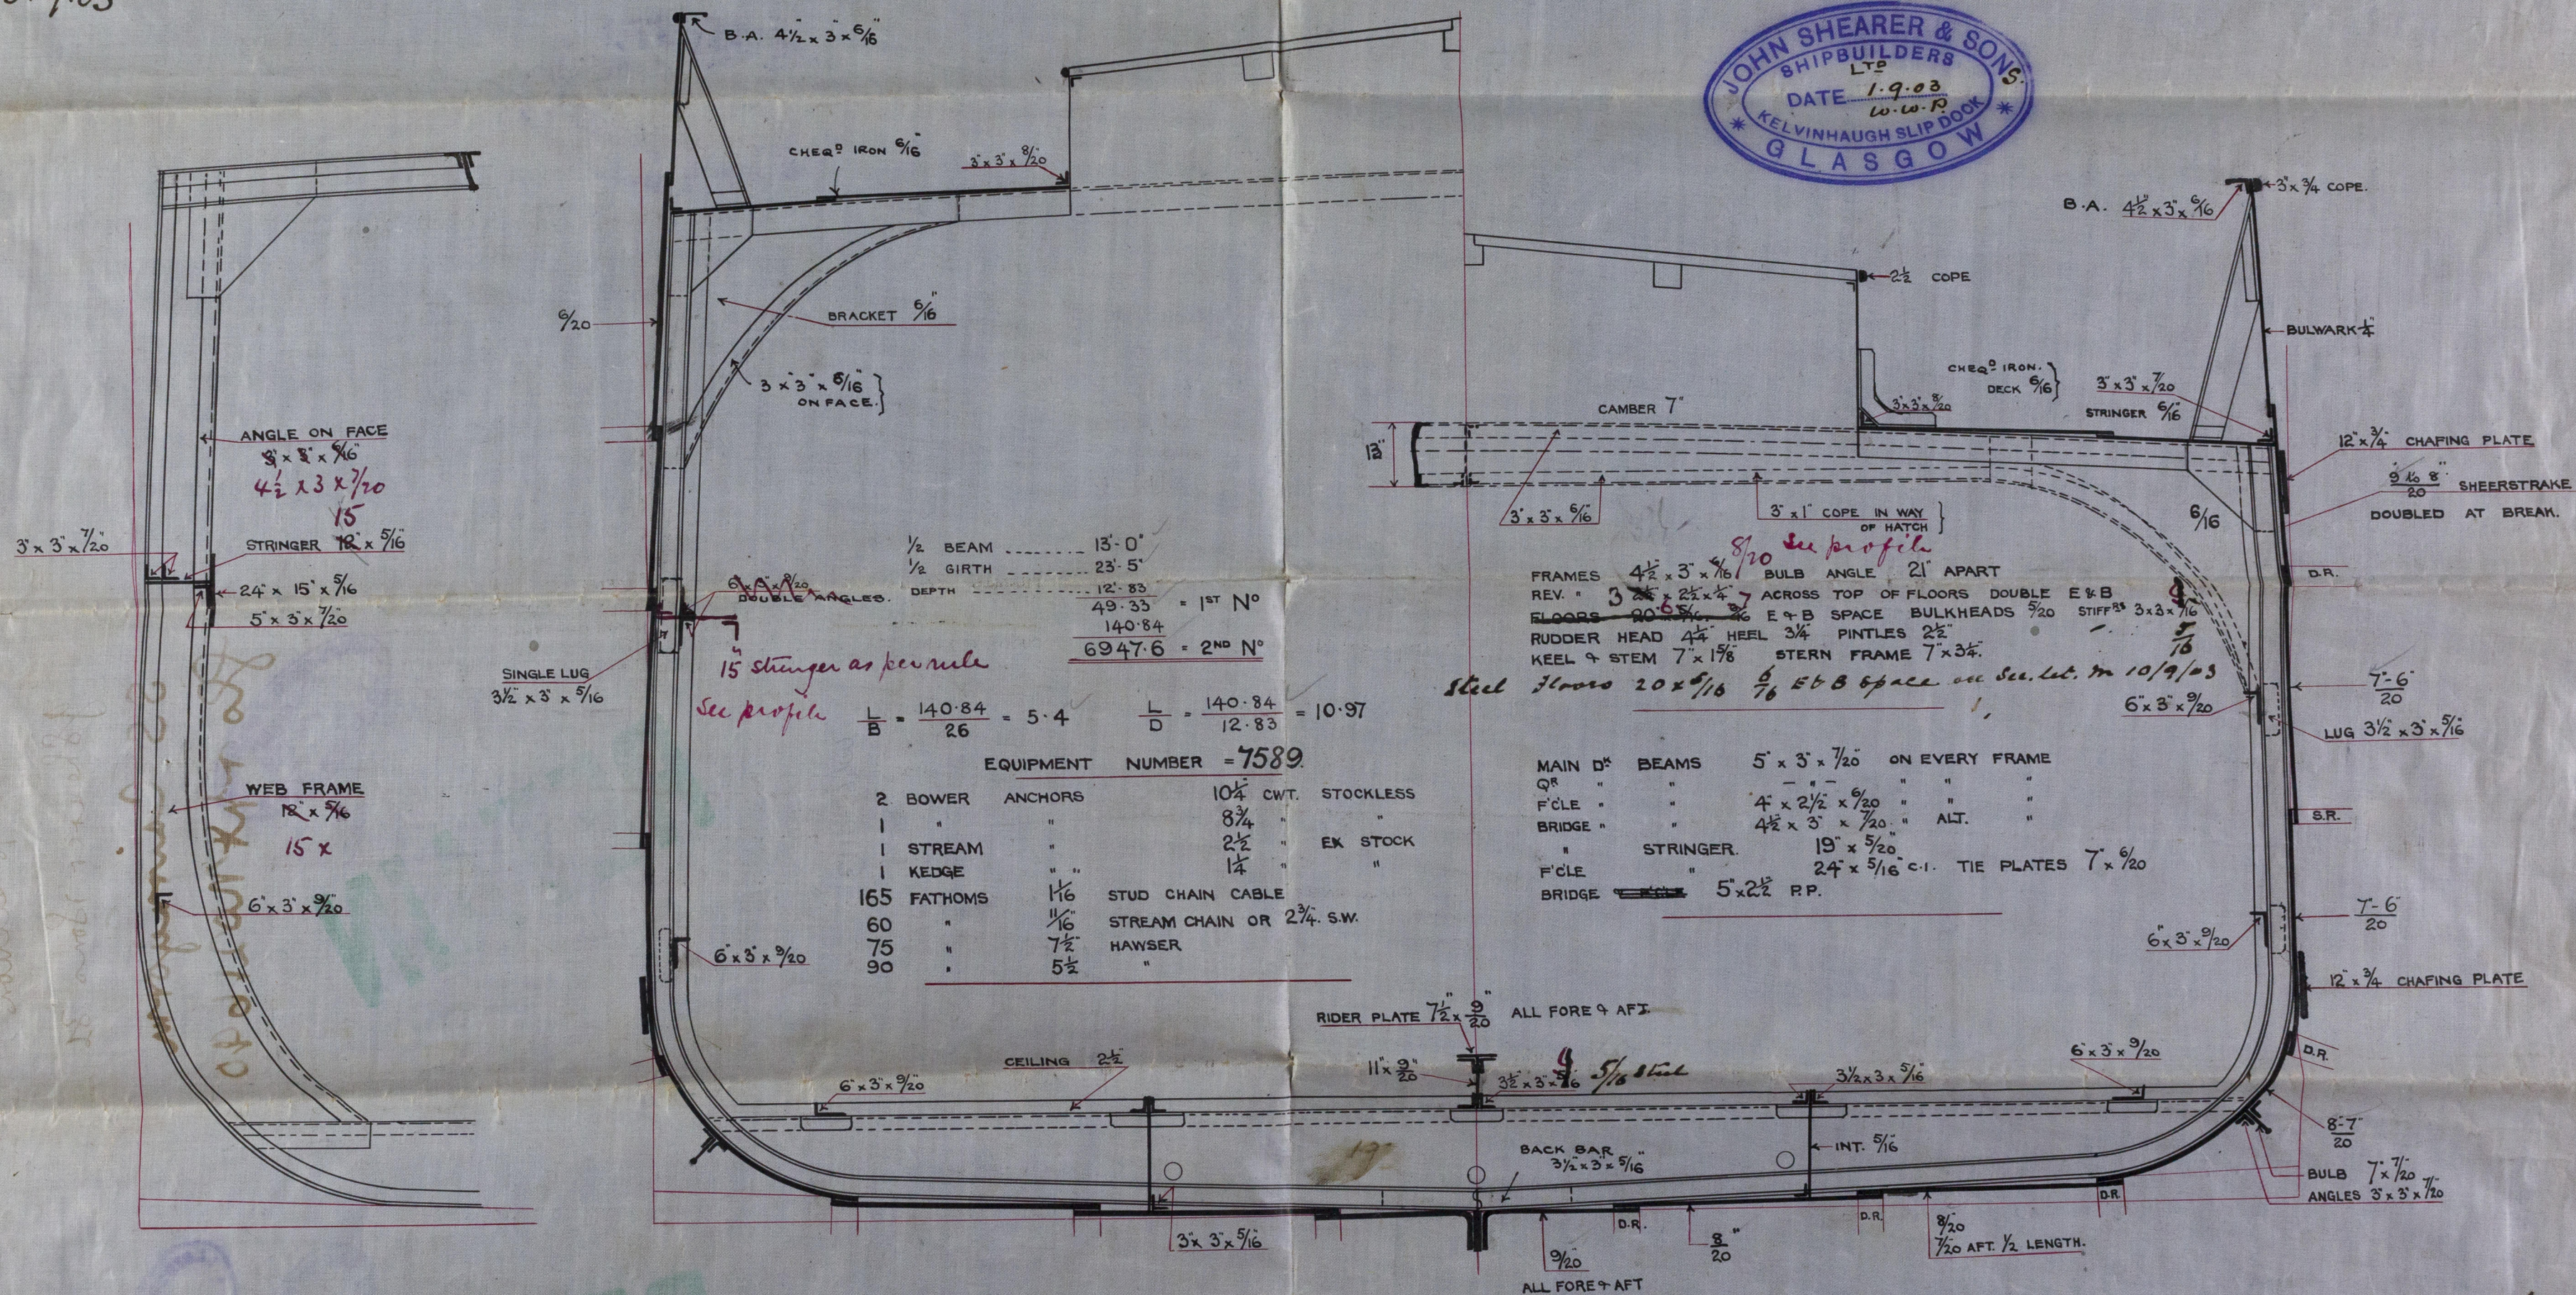

BUTTS OF SHEERSTRAKE TO HAVE DOUBLE RIVETED BUTTSTRAPS,
STRAPS $\frac{1}{20}$ THICKER THAN THE PLATES THEY CONNECT.
BUTTS OF GARBOARD STRAKE TO HAVE DOUBLE RIVETED BUTTSTRAPS.
BUTTS OF BULWARK TO HAVE SINGLE RIVETED BUTTSTRAPS.
REMAINDER OF BUTTS OF SHELL & DECK STRINGER TO BE LAPPED,
TREBLE RIVETED FOR $\frac{1}{2}$ LENGTH DOUBLE RIVETED AT ENDS
BUTTS OF CENTRE KEELSON & RIDER PLATE LAPPED & TREBLE RIVETED

W465-0113

J Shearer Sons 36

SS Cairngorm

№ 21640

LOVE'S REGISTER OF NEW
ARRIVALS
4 SEP 1909
LONDON

W465-0113

[illegible][illegible]