



HAUPTDECKSBALKEN	4	240 x 75 x 10
" " " " 23	4	135 x 65 x 8
NEBEN LUKEN	4	115 x 65 x 8
MASTBALKEN M.B	1	140 x 75 x 10 + 140 x 75 x 10
LUKENENBALKEN L-E-B	1	220 x 90 x 12 + 140 x 75 x 10
BACKSDECKBALKEN B-B	1	6150 x 70 x 9% JEDEN 2 ^{te} SPANT
POOPDECKBALKEN P.B.	4	130 x 75 x 10

Bei „GRONINGEN — HOLLAND.

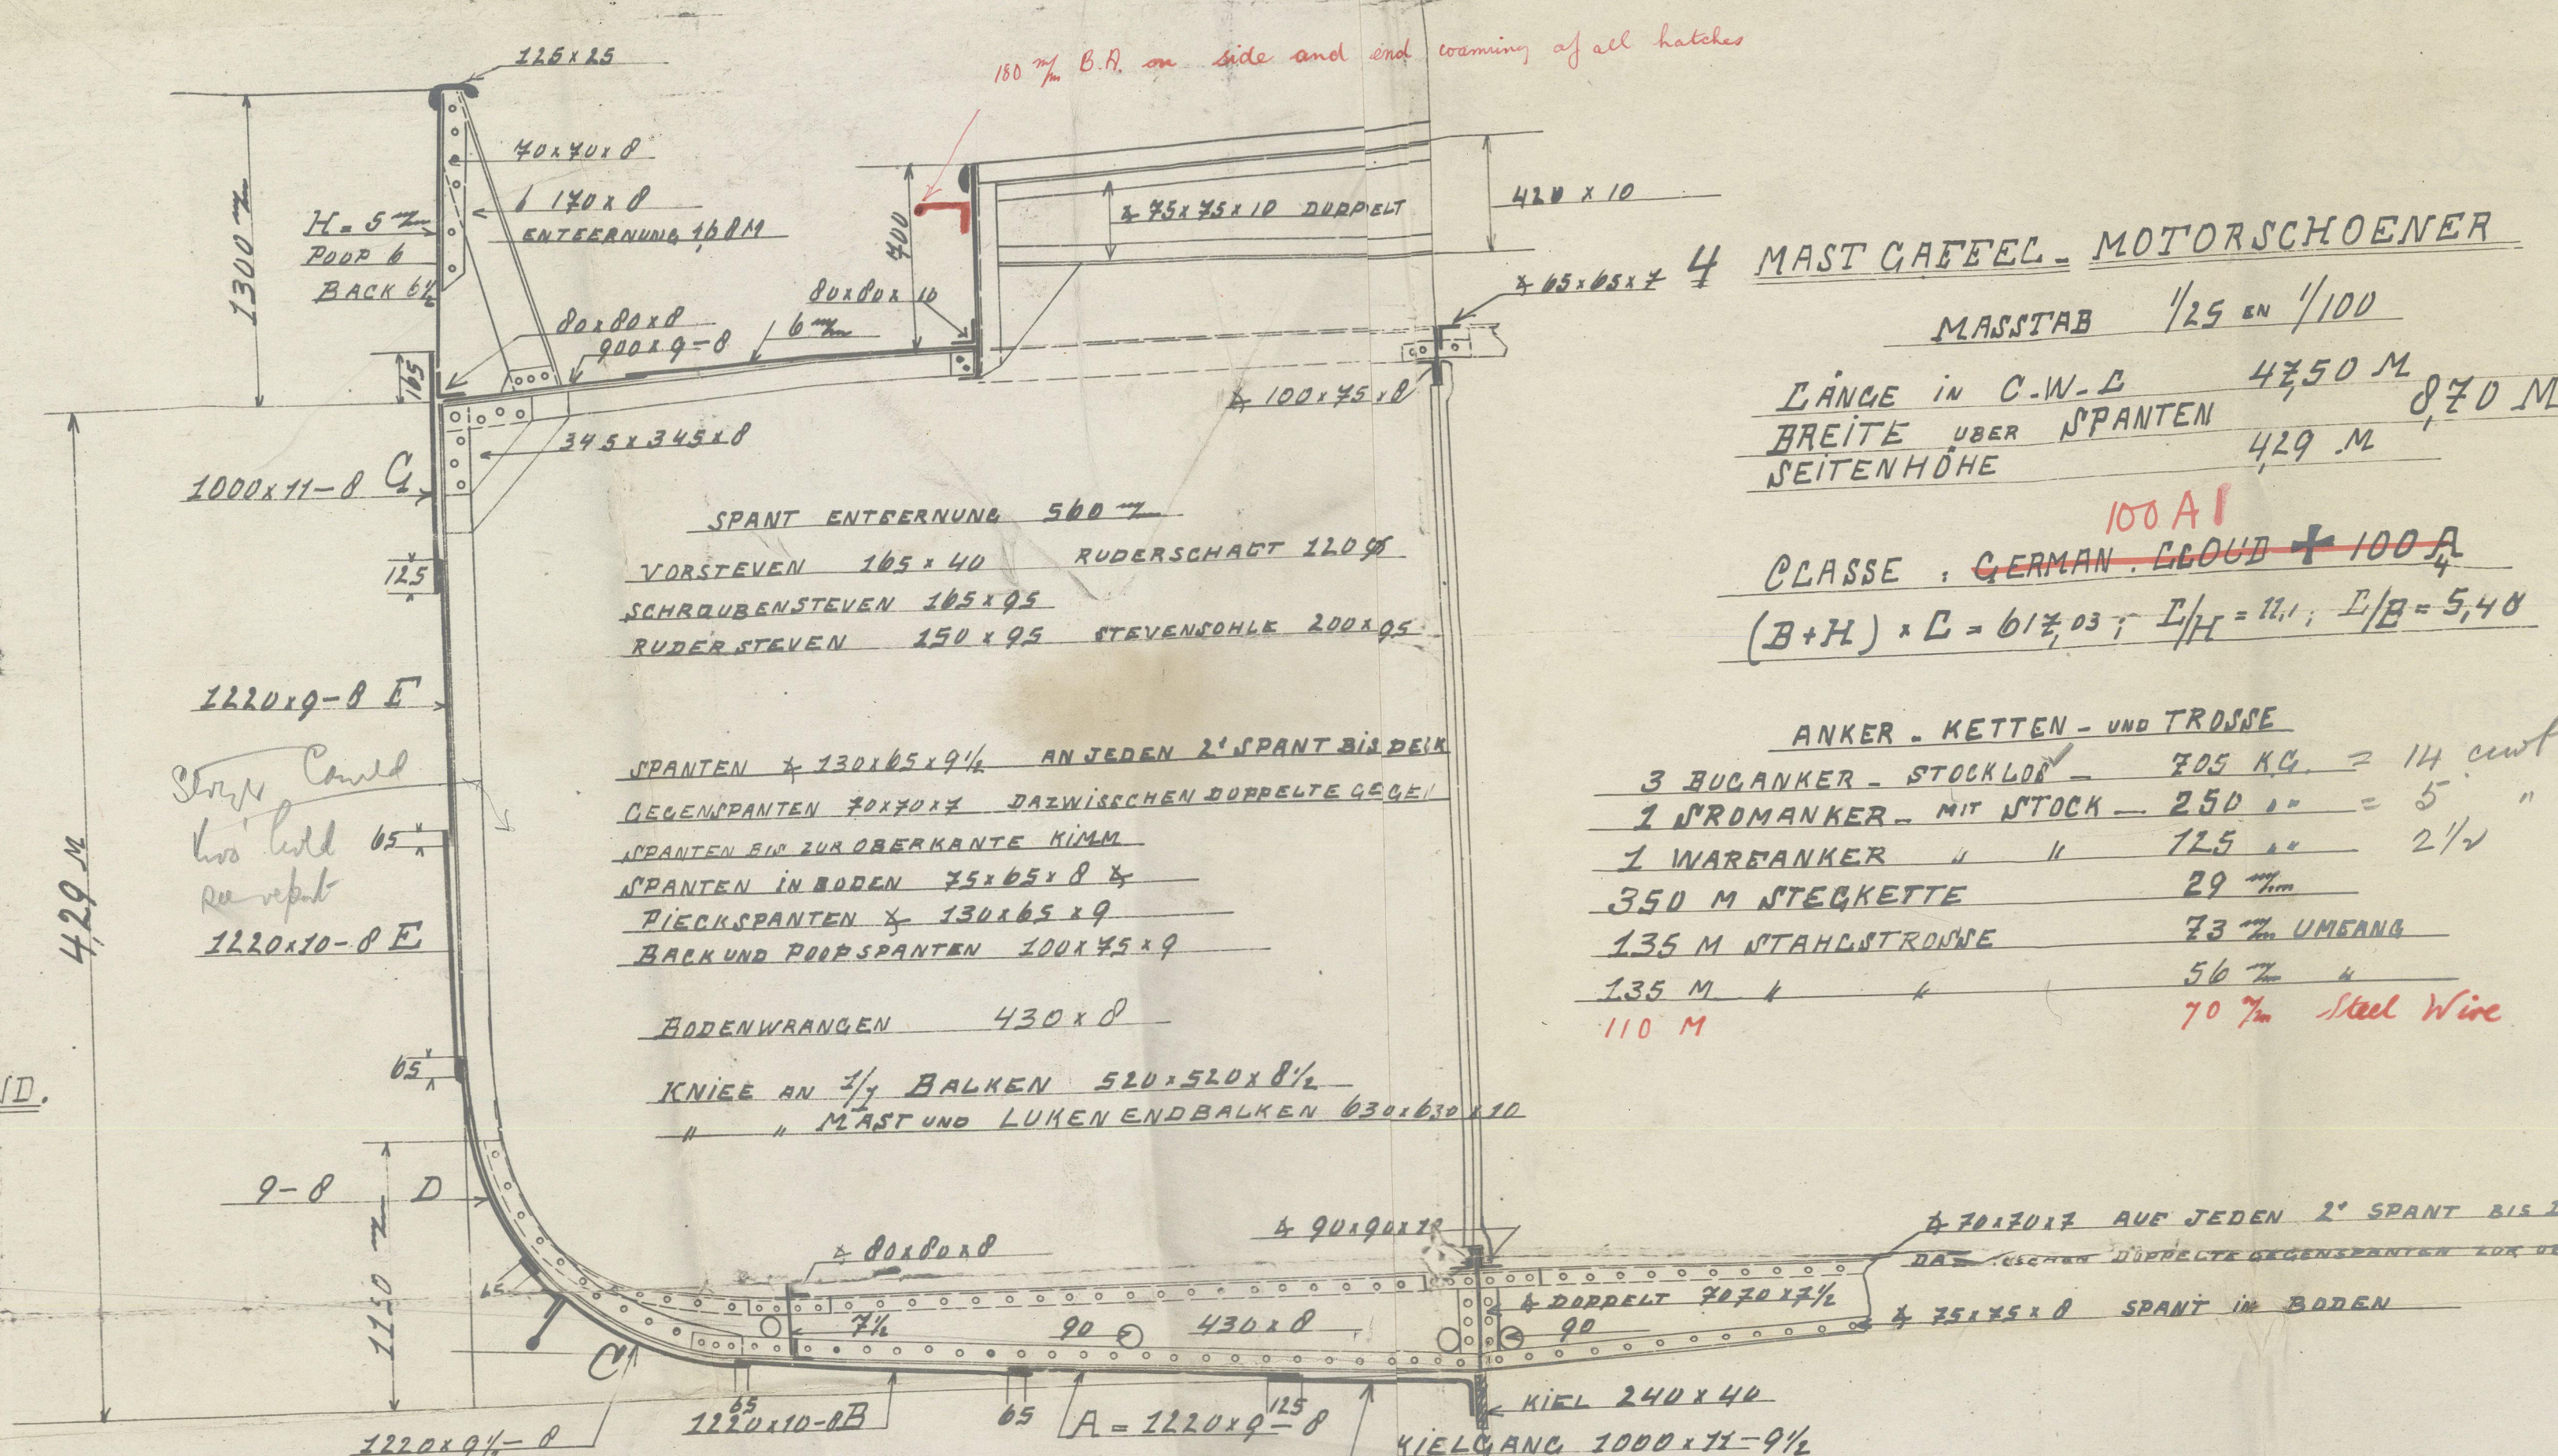

LUKE	I	II	III
ABMESSUNGEN	5600 x 4000	5040 x 4000	5600 x 4000
LÄNGSRÜLL	200 x 10%	200 x 10%	200 x 10%
QUERRÜLL	9	9	9
BALKENENTBERNUNG	1866	1680	1866
BALKHÖHE	420 x 10	420 x 10	420 x 10
& DOPELT	25 x 65 x 8	25 x 65 x 8	25 x 65 x 8
LUKEN DECKEL	25	25	25
LUKERÜLL WINKEL	80 x 80 x 10	80 x 80 x 10	80 x 80 x 10
" QUER "	25 x 25 x 9	25 x 25 x 9	25 x 25 x 9

	COLLIERIEN RAUM	MACHERIEN RAUM	HINTER DIESEN RAUM
BEPLATTUNG UNTEN	8 1/2	7 1/2	7 1/2
" " MITTE	8	8	8
" " OBEN	6 1/2	6 1/2	6 1/2
ABTEILUNGEN	8 1/2 x 15 x 9 1/2	8 1/2 x 15 x 9 1/2	8 1/2 x 15 x 9 1/2
ENTFERNUNG	800	800	800
WEGHOLSPANT 4	80 x 80 x 9	80 x 80 x 9	80 x 80 x 9
KNIEF OBERUNG: UNTEN	10 1/2	9 1/2	9 1/2

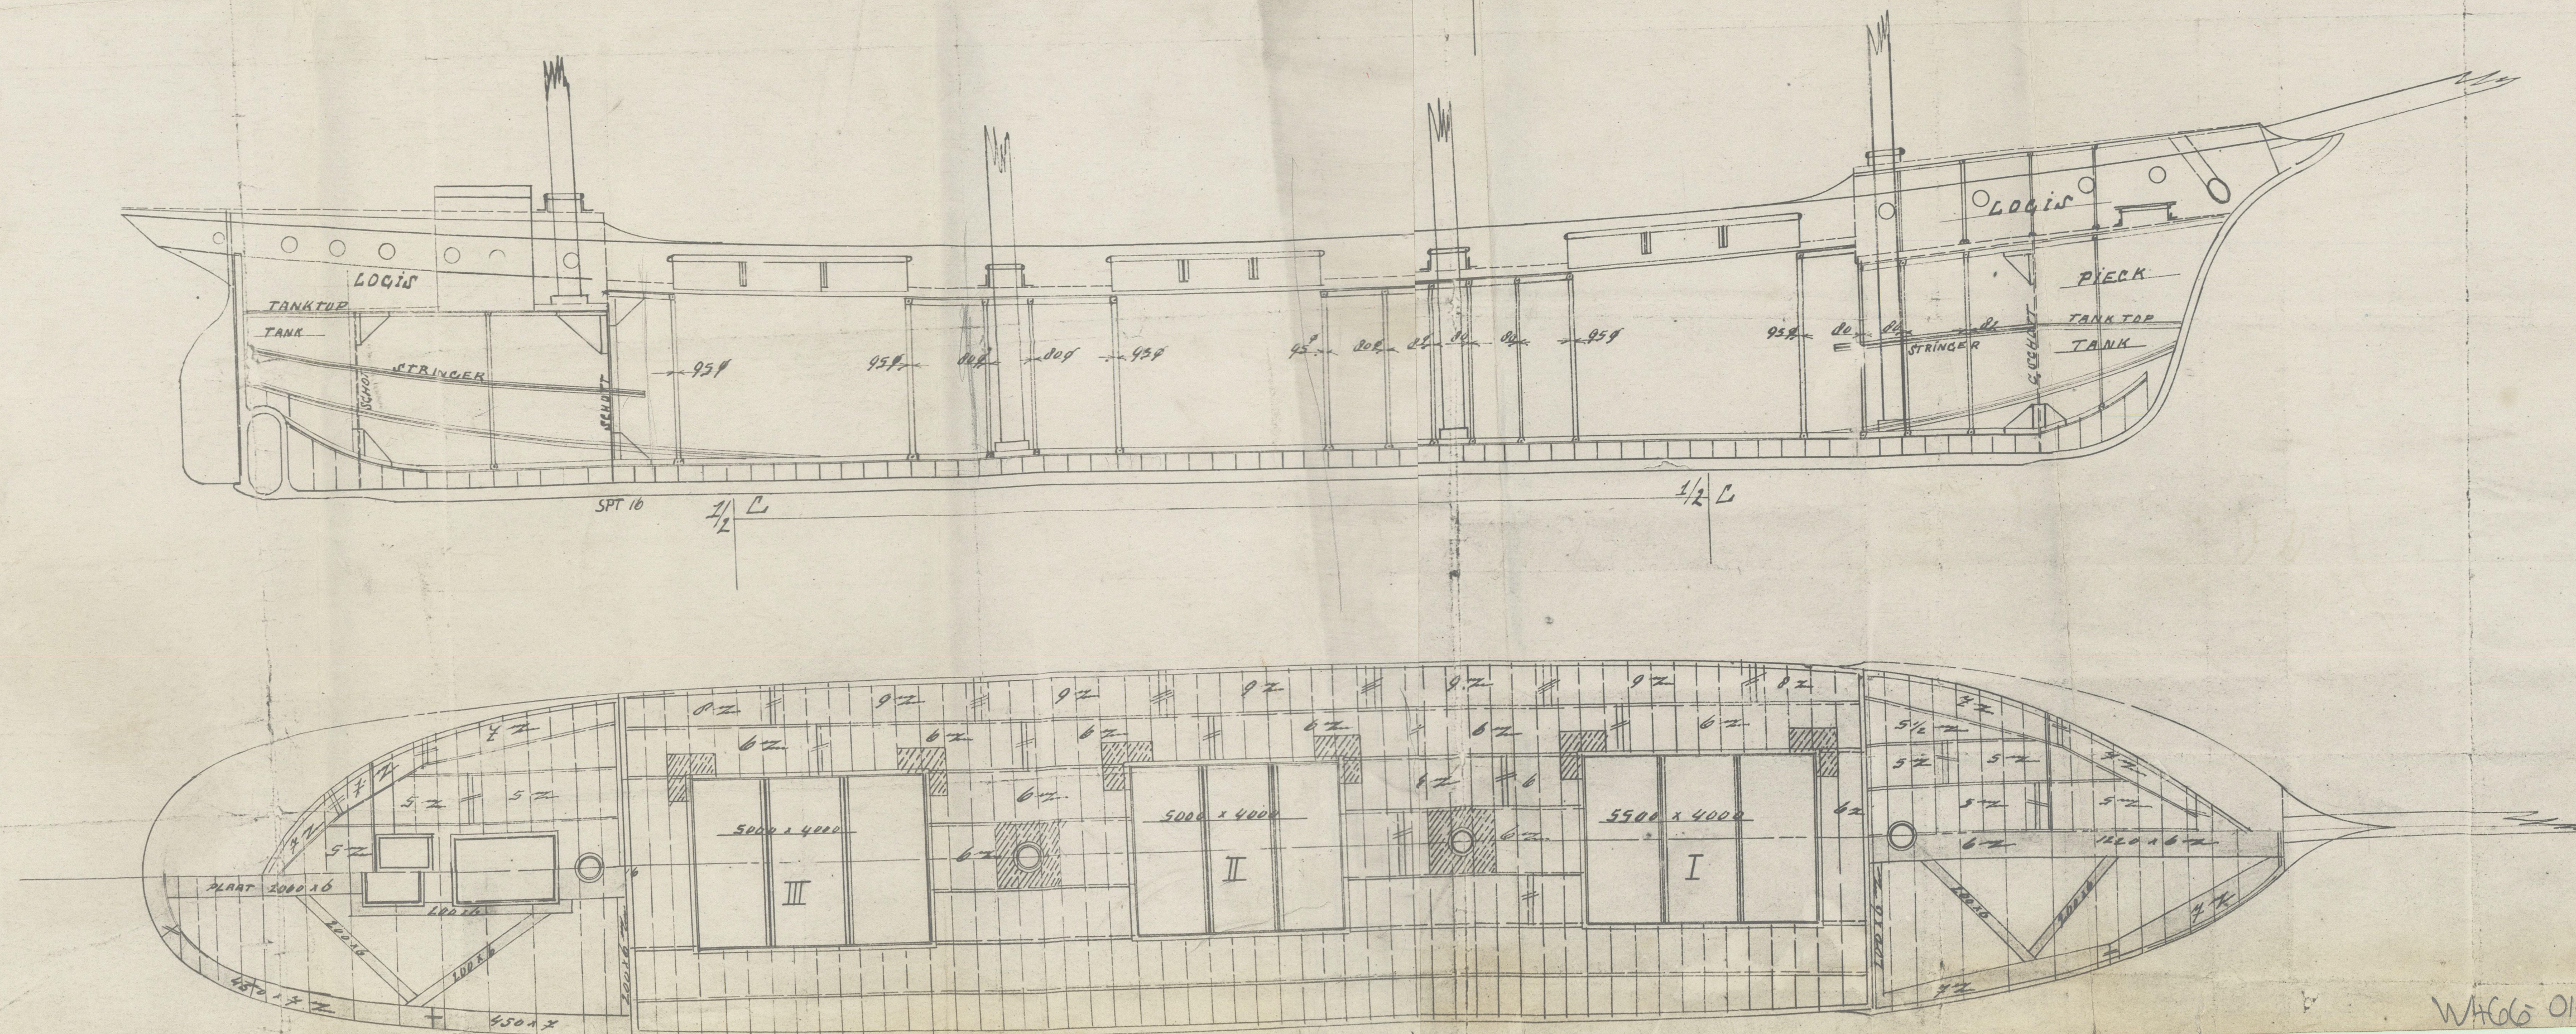

18
13

11

W.J.
24.6.30

W466 0104

MARIA PALMIRA

3 WT. BHD TO VP DK.

Midship Section
& Profile & Decks.

Fayal


Mr.

Fayal

Lis Rpt.

Lis rpt. No. 2372

RETAIN

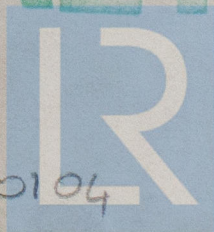

© 2020

Lloyd's Register
Foundation

Wh66-0104