


DIMENSIONS 270.0" x 38.0 MLD x 20.0 MLD

SCALE $\frac{1}{8}$ INCH = ONE FOOT

" TO CLASS AT LLOYDS 100.A.I. STEEL. PARTIAL AWNING DECK.



Pillaring arrangement to be submitted.

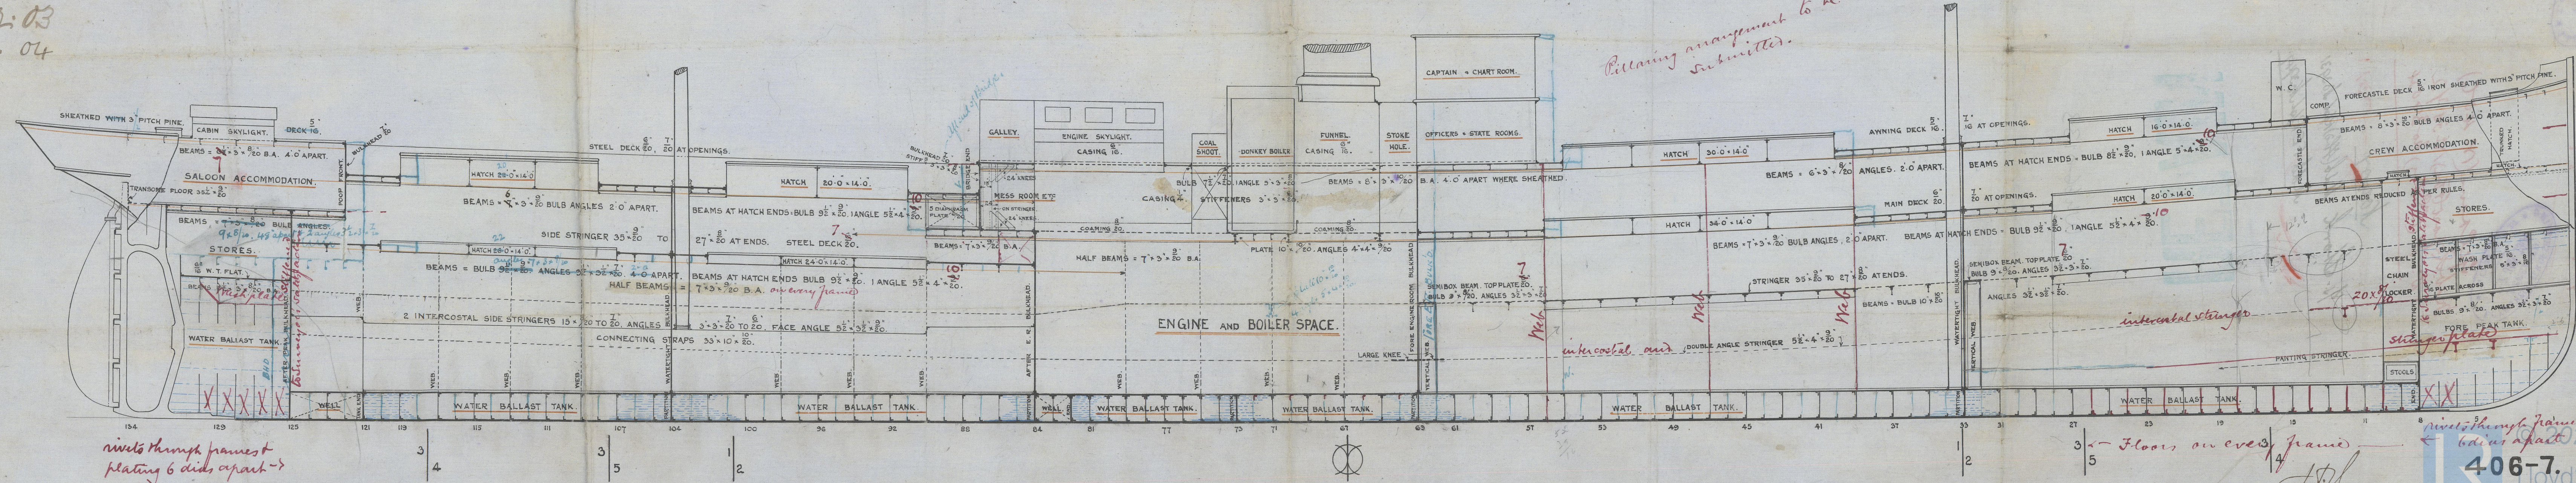

rivets through frames &
plating 6 dist apart -

4 - Floors on every frame


14
J.P.L.
7/12/03

406-7.

6-1. Lloyd's Register
Foundation
W466-0133

Propite.

Ropner & Co.,
No 4067.

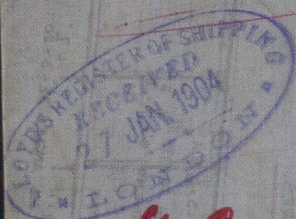

Specimen (No 406)
Mab Report (For) No 3842.
Dr. Dr (1st Entry) No 3904.

Korea

% Stock Mab (Hb) Rpt No 3931
Mab FER Rpt No 3947



RETAIN

Wu66-0133



© 2020

Lloyd's Register
Foundation