


Midship Section
Ropent Hou.

45. No 406/7.

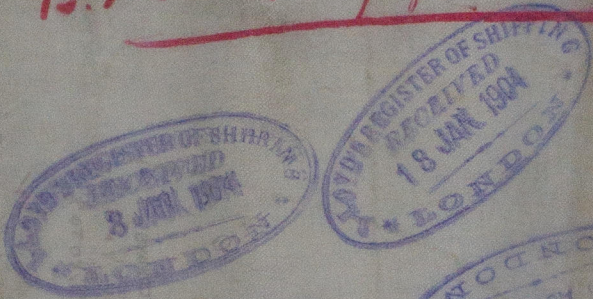

No 406
G. Crane. Mdb Rpt. (Hb) N 3972.
1st Entry Report Mdb 3904

No 407
% Stock Mdb. (Hb) Rpt 3931
Mdb. F.E. Rpt. 3947

RETAIN

W466-0135

Noted.



NOTICE



© 2020
Lloyd's Register
Foundation