

HALF GIRTH	19.96
HALF BEAM	10.91
DEPTH	13.46
FIRST N°	44.33
LENGTH	123.87
SECOND N°	5491.15

$$\frac{L}{D} = 9.2 \quad \frac{L}{B} = 5.67$$

"Lily Melling"


OF 1

DIMENSIONS 125'-0" BP x 22'-0" EXT. x 13'-0" MLP

SCALE $\frac{1}{2} = 1 \text{ FOOT.}$

✓ 1 ANCHOR 5½ EX. STOCK, OR 7 CWT. STOCKLESS
✓ 1 " 5 " " " 6¼ " "
✓ 1 " 2¾ " " "
✓ 105 FATHOMS 1¼ STUDLINK CHAIN
✓ 60 " 6 HAWSER OR 2¼ STEEL WIRE
✓ 60 " 4½ WARP " 1¾ STEEL WIRE

if with Owners constant
to steel wire

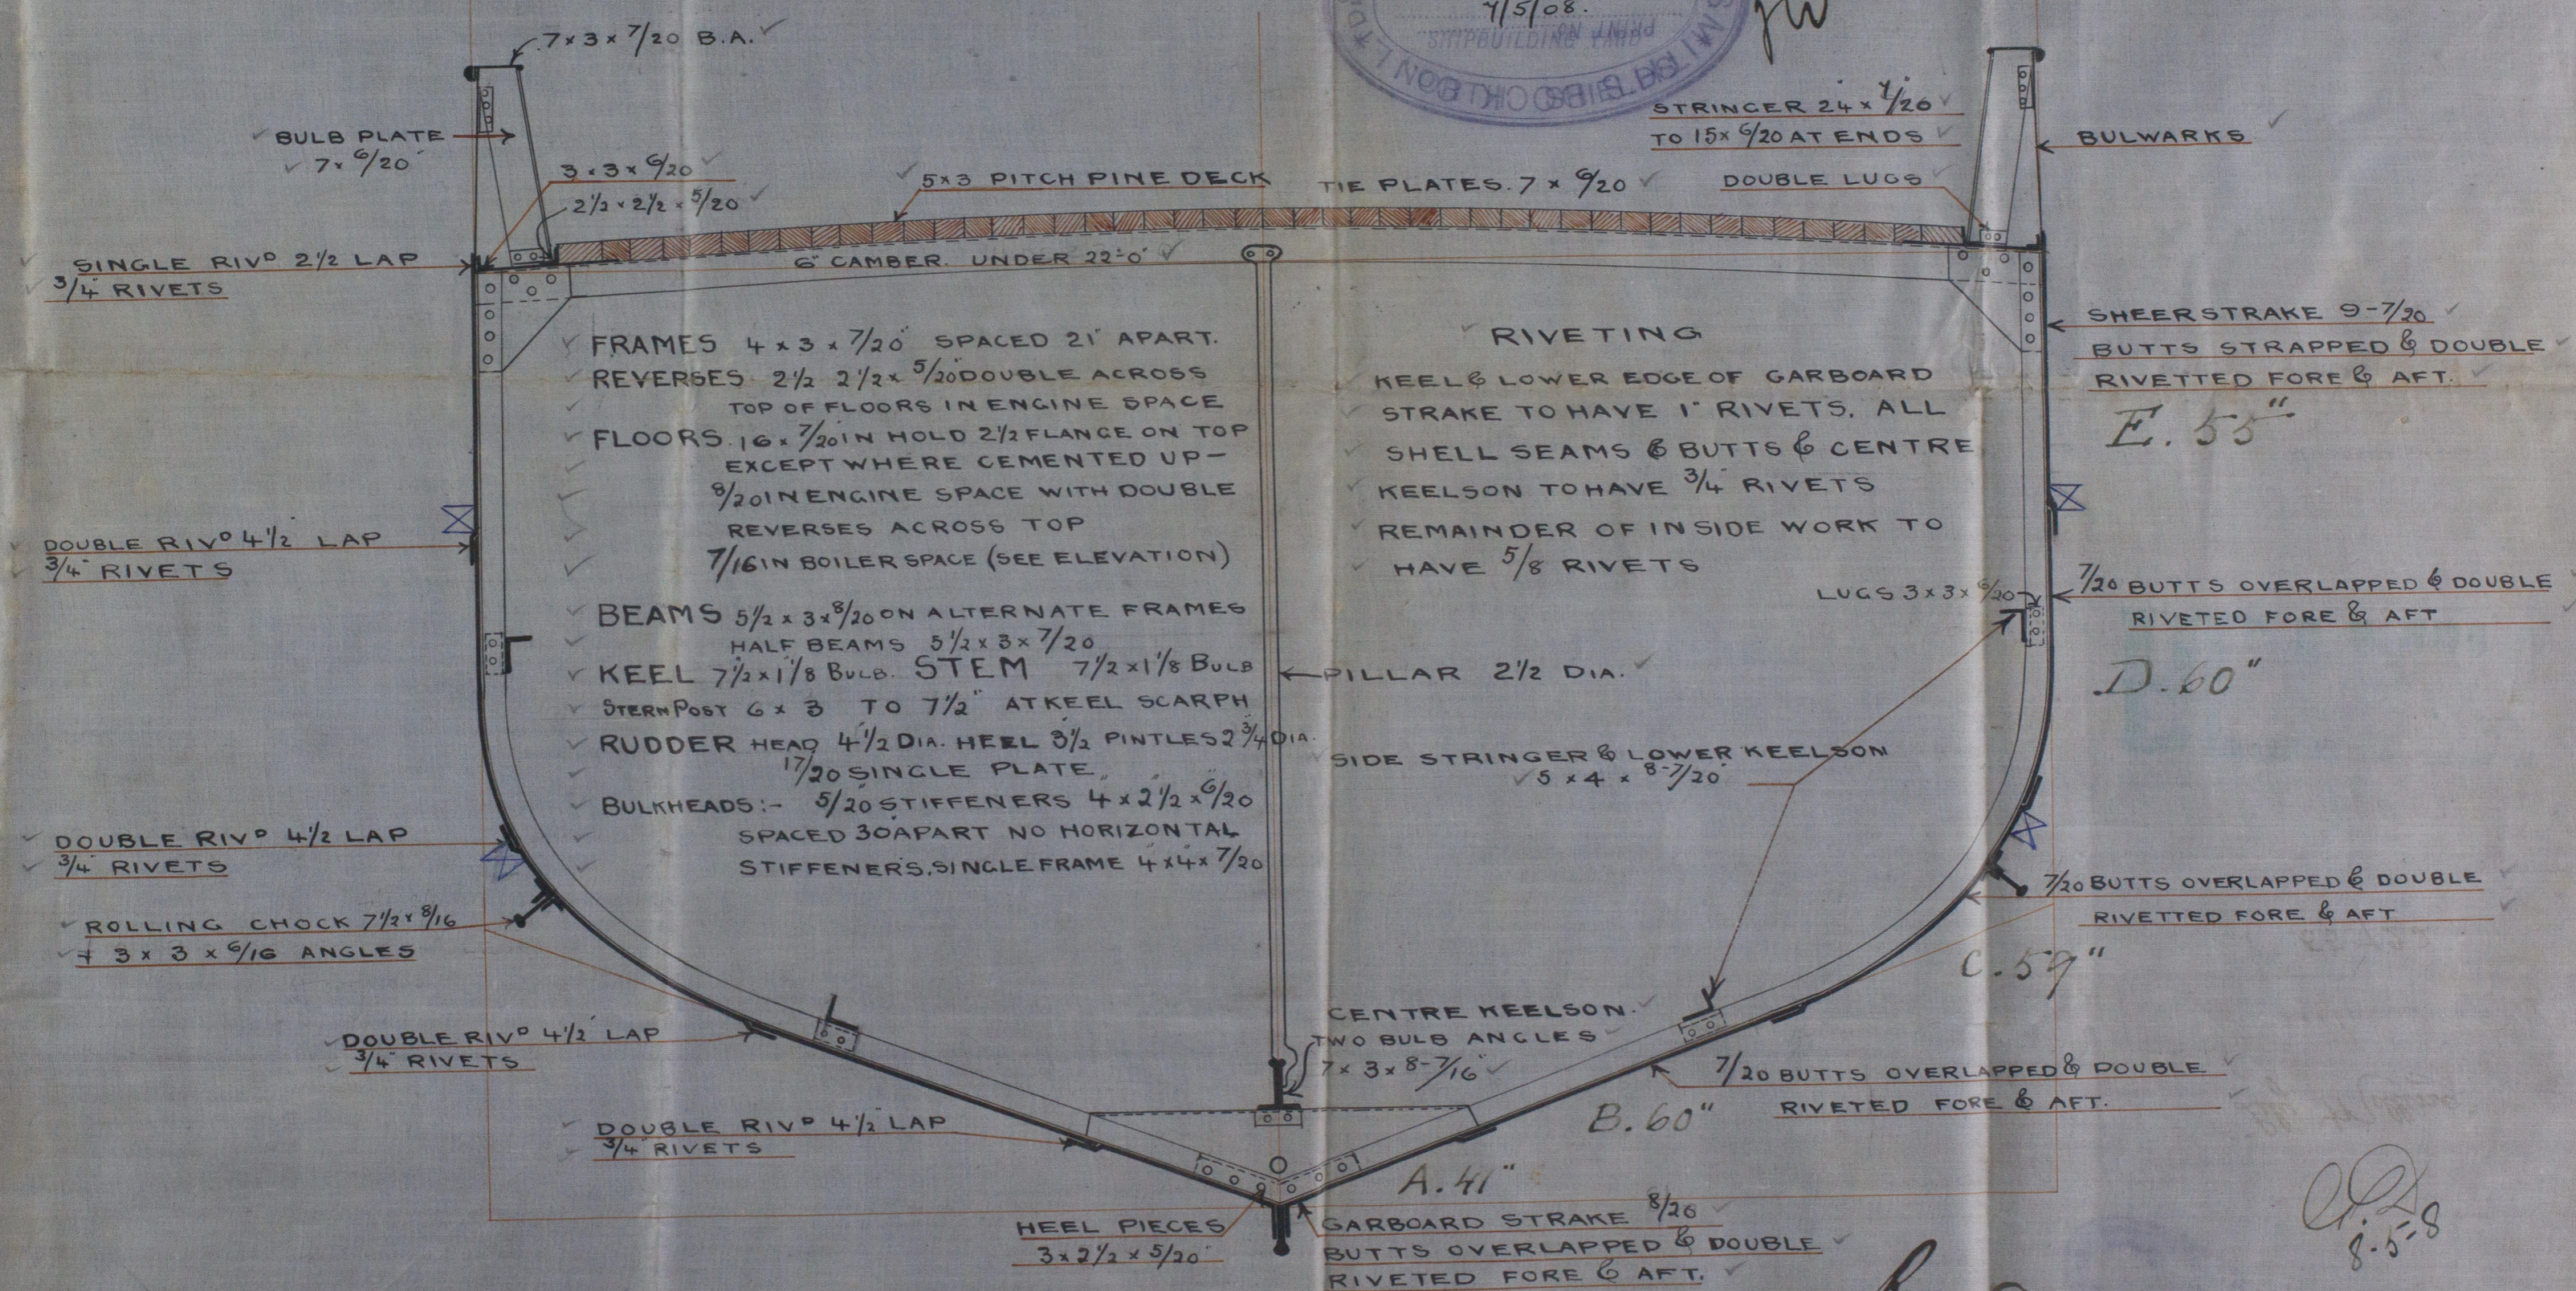


C.B.
11-5-05

8-5-8

W466-0151

Smith's Dock Co's
No. 394
Midship Section

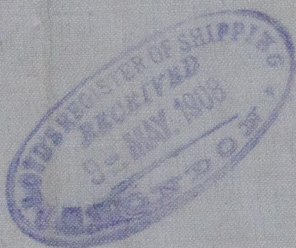


8-2-8
0078

J. J. Lily Melling

Newcastle Report

N^o 55722

RETAIN

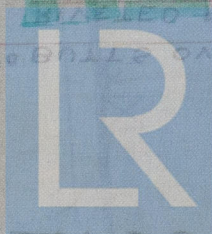

© 2020

Lloyd's Register
Foundation