


8 DEC 1936

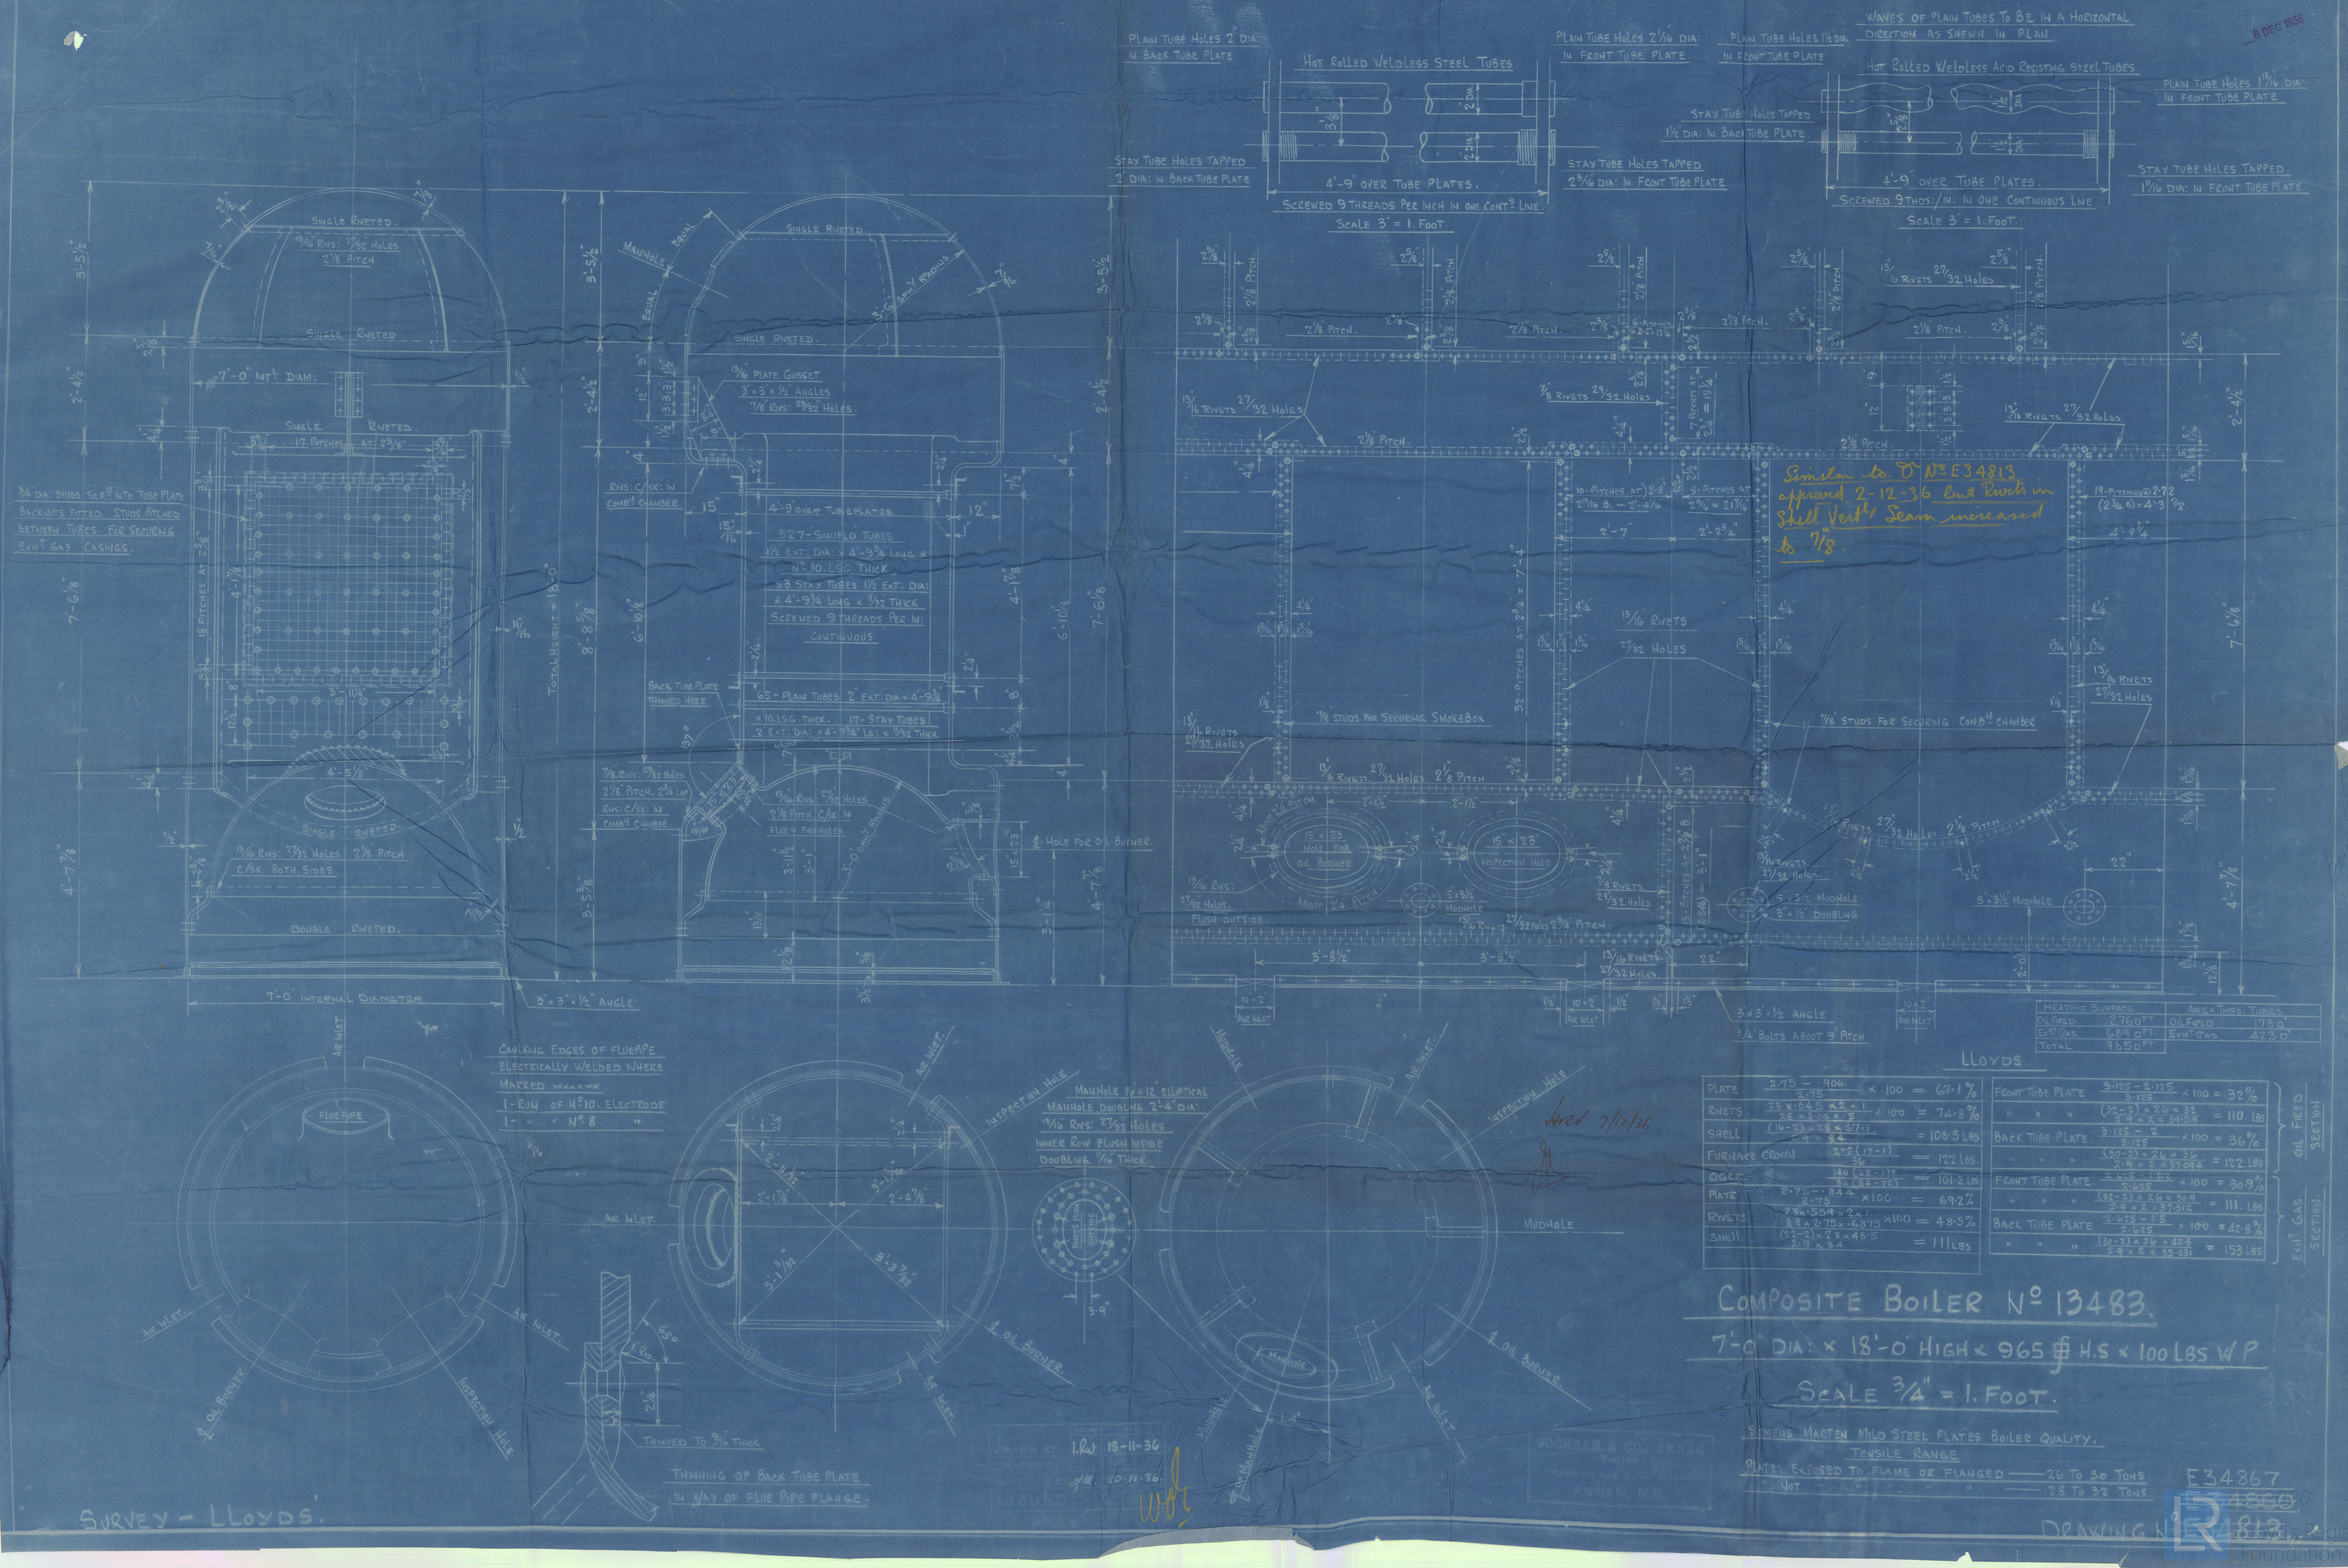

COMPOSITE BOILER N° 13483.  
7'-0" DIA. x 18'-0" HIGH x 965 # H.S. x 100 LBS W.P.  
SCALE 3/4" = 1. FOOT.

SIMENS MARTEN MILD STEEL PLATES BOILER QUALITY.  
TENSILE RANGE:  
PLATES EXPOSED TO FLAME OR FLANGED 26 TO 30 TONS.  
" " " " " " 28 TO 32 TONS.

E34867  
4860

DRAWING N° 1812  
REGISTERED  
FOUNDATION



Anchor

N° 13483

Drawing

N° E 34867

W P 100

Sul Horn 4-12-26

Alt 8-12-26

13483

N = 19938

Lloyd's List

200 lbs

W P 100

J.S.C 1-4-37

GLASGOW REPORT No 58257



Lloyd's Register  
Foundation