


DECK HOUSE ON SHELTER DECK

SCALE 1:100 & 1:50

See
4/6/36

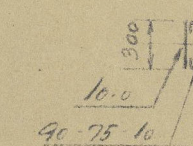

3/6 3 Mr. Lloyd's

BYGNING NR 80

DIKSHU © 2020

3-6-36


Lloyd's Register
Foundation

W467-0192

N. Nærked Skibsvæft.

Yard No. 80

Plan of Superstructure.

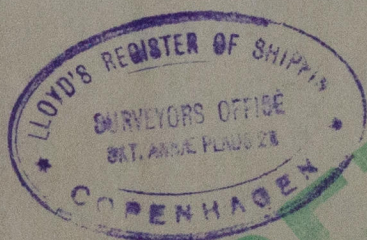

m/s. "Alex nan Opstal"
of Antwerp.

Copen. Report No. 10355.

W467-0192



© 2020

Lloyd's Register
Foundation