
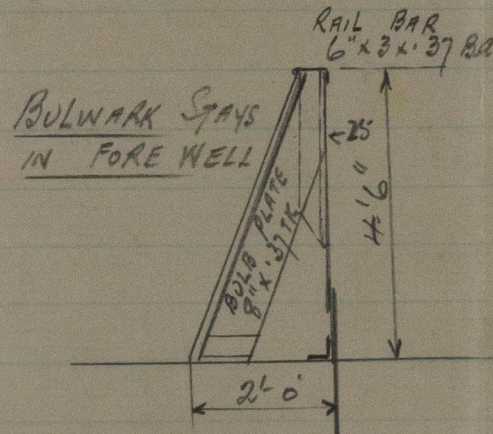
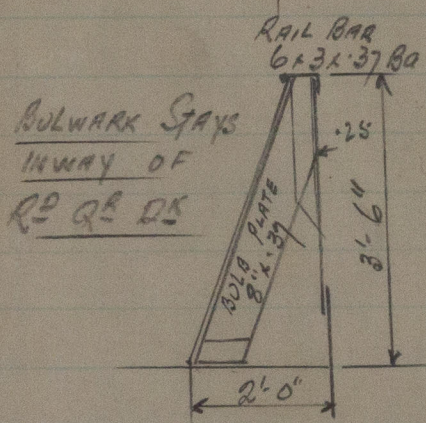
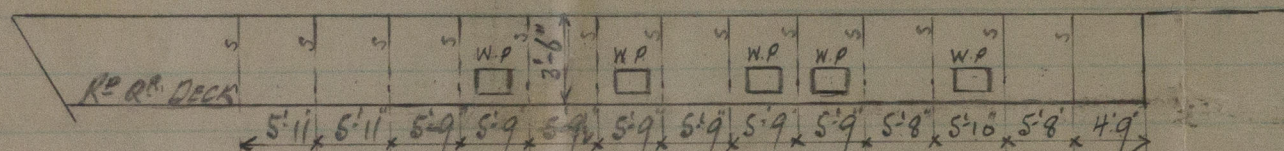


S/S "Moidart"

6/8/37

POSITION OF BULWARK STAYS & WASH PORTS AS MEASURED FROM SHIP

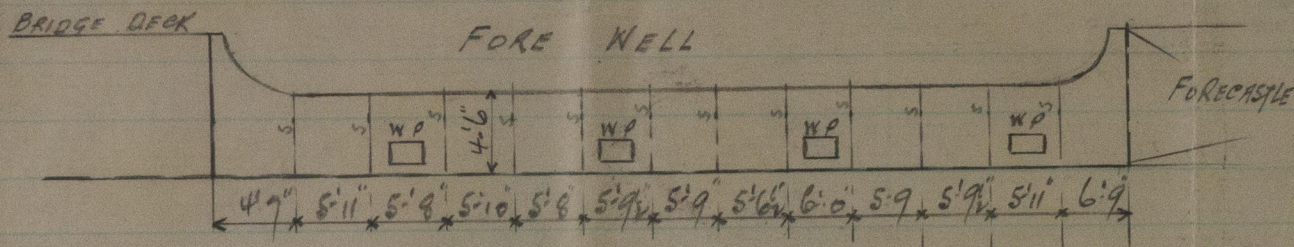

Note:- ① The Centre Keelson is Watertight between frames. H3 + 60 is under Machinery Space.

- ② A Screw hand gear is fitted aft without other protection than a canvas cover.
- ③ Lead of Steering Rods and chains along ships side.



© 2020

Lloyd's Register Foundation

W6670318