


MIDSHIP SECTION

S. S. N^o 113 AS BUILT

Scale 1/2 inch = 1 Foot.

30" steel deck. 34 where unsheathed, butts 1R

Stringer 34" x 30" carried
2 spaces over Q^r D^r
Angle 3" x 3" x 30"

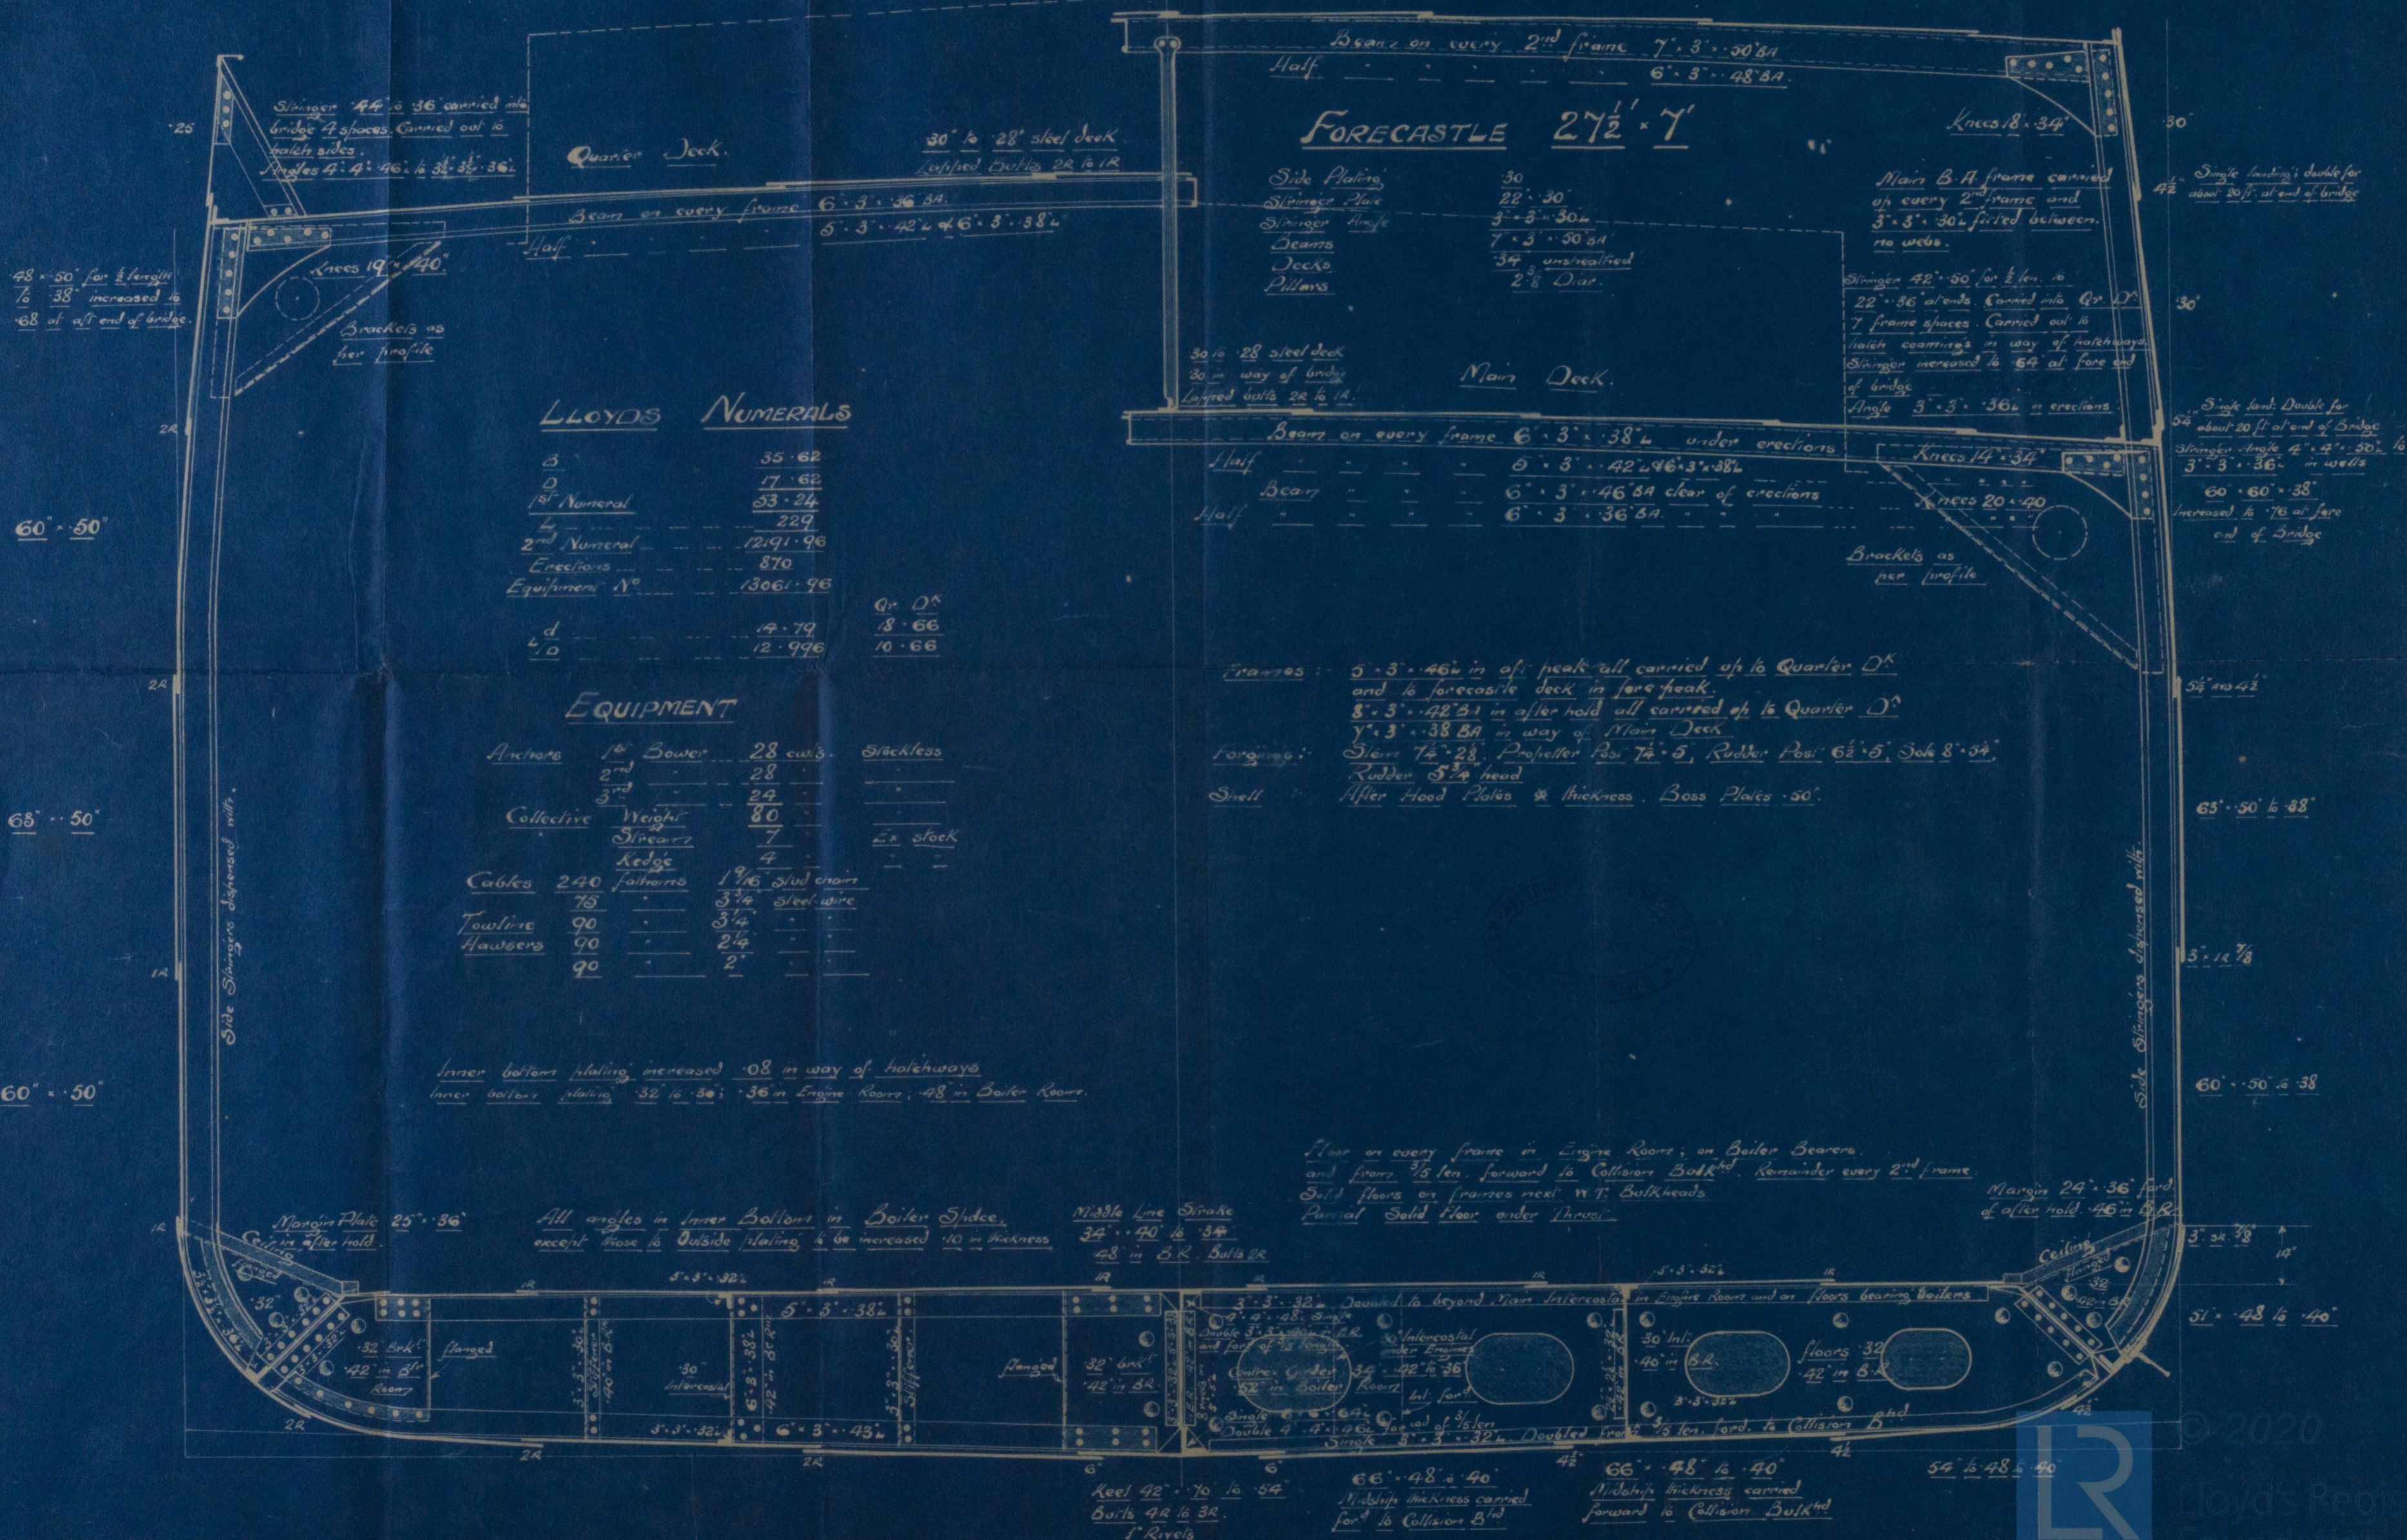

Campbeltown SBCr.

N^o 113.

S/S "FRITHJOF EIDE"

Midship Section

Gr. Rep. 17577.

Exchequer

RETAIN

LR

© 2020

Lloyd's Register
W467-0320
Foundation