

Final

Lloyd's Register of Shipping.

SURVEYS FOR FREEBOARD.—STEAM SHIPS.

Index No. 27637
(For London Office only)

TUE. 1 MAY 1921

No 17787

PARTICULARS RELATING TO ALL STEAM SHIPS ~~NEITHER FLUSH DECKED, OR WITH TOP GALLANT FORECASTLES, SHORT POOPS AND BRIDGE HOUSES DISCONNECTED, NOR WITH TOP GALLANT FORECASTLES HAVING LONG POOPS, OR RAISED QUARTER DECKS CONNECTED WITH BRIDGE HOUSES, OR OTHERWISE.~~

Port of Survey Greenock
Date of Survey While Building
Name of Surveyor R.D. Cairns

Ship's Name	Port of Registry and Nationality	Official Number	Gross Tonnage	Date of Build.	Particulars of Classification.
S.S. "DORIC STAR"	London British			Building	+100 A.I. (Contemplated)

Registered dimensions from ship's Register.	LENGTH.	BREADTH.	DEPTH.	UNDER DECK TONNAGE.
	499.8	61.0	37.0	9296.42
Length on Loadline.	499.	Frame Depth $\frac{1}{2}$ Ceiling fitted Rule $\frac{8}{5} \times \frac{1}{2}$ Sheer $\frac{1}{5}$ Tanks	Peak 7' mid 25' Drop - 60 tons for tank + 10' Casing Stern	
CORRECTED DIMENSIONS.	499	63.77	36.94	9236.42

Co-efficient of fineness 79 ✓
Any modification necessary [Para. 4 (a) to (e)]* - .02 Cell D.B.
Co-efficient as corrected 77 ✓

Moulded Depth as measured 40' 6"

NOTE.—If the depth is measured when vessel is afloat, the details of measurement should be reported.

Addition for Keel below base line for draught record 2 $\frac{1}{2}$ inches.

CORRECTION FOR LENGTH.

Length of Ship on Loadline	499 ✓
Length in Table	486 ✓
Difference	13 ✓
Correction for 10ft., Table A	1.7 ✓
× Difference divided by 10	2.21 ✓
If $\frac{1}{10}$ ths length covered divide by 2	1.04 ✓
+ 2 $\frac{1}{4}$ ✓	+ 1' ✓

CORRECTION FOR IRON DECK.

Proportion covered, if less than $\frac{7}{10}$ ths length covered	53.45 ✓
Thickness of usual wood deck, less stringer	3 $\frac{1}{2}$ - 2" ✓

CORRECTION FOR ROUND OF BEAM.

Breadth at Gunwale amidships	63 ✓
Round of Beam	8.5 ✓
Normal round	15.75 ✓
Difference	7.25 ✓
Proportion of Deck uncovered (Para. 19)	3.625 ✓

NOTE.—The round of beam should be reported on the full breadth of vessel at the gunwale.

Freeboard, Table A	11-8 $\frac{1}{4}$ ✓
Correction for Sheer	+ 1 $\frac{1}{2}$ ✓
Correction for Length	11-9 $\frac{3}{4}$ ✓
Allowance for Deck Erections	+ 2 $\frac{1}{4}$ ✓
Correction for Round of Beam	12-0 ✓
Correction for fall in Sheer (if any)	1-3 ✓
Correction for Iron Deck (if required)	10-9 ✓
Additions for non-compliance with provisions of Para. 11 (d) and (e)†	+ 1 $\frac{1}{2}$ ✓
Other Corrections (if any)	10-10 $\frac{1}{2}$ ✓

Winter Freeboard	10-8 $\frac{1}{2}$ ✓
Summer Freeboard	10-1. ✓
Indian Summer Freeboard	9-5 $\frac{1}{2}$ ✓
N.A. Winter Freeboard	

Correction necessary because clearside amidships, measured in accordance with the Statute is not taken at the intersection of the wood or iron deck with side. + 1. ✓

Winter Freeboard from deck line	10-9 $\frac{1}{2}$ ✓
Summer " " " "	10-2. ✓
Indian Summer " " " "	9-6 $\frac{1}{2}$ ✓
N.A. Winter " " " "	

Upper (Iron) Deck :— 10-2 ✓
7 $\frac{1}{2}$ ✓
7 $\frac{1}{2}$ ✓
7 $\frac{1}{2}$ ✓

* If the frames, skin planking, or ceiling are of unusual thickness the breadth of vessel to inside of ceiling should be reported if possible.

† In vessels obtaining an allowance for deck erections under Para. 11 where the sheer drops abaft amidships the height of the R.Q.D. is to be taken from the level of the top of the amidship beam.

‡ In flush-decked vessels the total standard mean sheer means the sheer measured at the stem and stern-post. In vessels having poops and forecastles, it means the sheer measured at points distant one-eighth of the vessel's length from stem and stern-post.






Do all the Frames extend to the top height in the Poop? Yes
 To what height do the Reverse Frames extend? To Upper & 2nd Deck All BA frames to forecastle Yes
 Has the Poop or Raised Quarter Deck an efficient Iron Bulkhead at the fore end? Yes
 Give particulars of the means for closing the openings in Bulkhead Two hinged Wood Doors 5'6" x 2'3" (see sketch below).
 Is the Poop or Raised Quarter Deck connected with the Bridge House? No Has the Bridge House an efficient Bulkhead at the fore end? Yes
 Give particulars of the means for closing the openings in Bulkhead One Steel hinged door 5'6" x 2'0" (to San Room)
 What is the thickness of the Bridge Front plating? 140 and Coaming plate? 144
 Give scantlings and spacing of the Stiffeners 9x32 x 64 BA 30' apart
 Are bracket plates fitted at each end of the Stiffeners? Yes Are hor'l. brackets fitted connecting Bridge Bulk'd. with Bulwarks? Yes
 Has the Bridge House an efficient Iron Bulkhead at the after end? Yes
 How are the openings closed? One Steel hinged door 5'6" x 2'6"
 Is the Forecastle at least as high as the main or top-gallant rail? Yes Has the Forecastle an efficient Iron or Wood Bulk'd. at after end? Yes
 Are the Engine and Boiler openings covered by a Bridge, Poop, Raised Quarter Deck, or enclosed by a Strong Iron or Steel Deckhouse? Covered by Bridge Deck
 If the openings are not so protected are the exposed parts of the Casings efficiently constructed?
 Give thickness of plating; scantlings and spacing of Stiffeners
 What is the height of the exposed Casings? Are suitable means provided for closing all openings in them in bad weather? Yes
 Are the Weather Deck Hatchways efficiently constructed and at least equal to the requirements of Section 28 of the Rules for 1904-5? Give particulars below:—

Position and Size.		N°1 18'-0" x 18'-0"	N°2 21'-2" x 18'-0"	N°3+4 19'-8" x 18'-0"	N°5 24'-7" x 18'-0"	N°6 19'-8" x 18'-0"		
Item.	Ship.	Rule.	Ship.	Rule.	Ship.	Rule.	Ship.	Rule.
COAMING. Thickness { Sides..... Ends.....	34 .44 .44	do.	34 .44 .44	do	34 .44 .44	do	34 .44 .44	do
SHIFTING BEAMS OR WEB PLATES. { Number Section and Scantlings Material	3 15x35 Steel	(3) 14x34 4x3x44 14x34 4x3x44 (2) 7F-3x3x46 40 web from depth Steel 6x3x6.2	Same as No 2	2 Same as No 2. Steel	(3) Same as No 2. 3-4 (2) Same as No 2. 3-4 Steel	5 14x34 4x3x44 Steel		
* FORE AND AFTERS. { Number Section and Scantlings Material	None	None	None	None	None	None	3"	
HATCHES Thickness Remarks.....	3" W.P.	3" W.P.	3" W.P.	3" W.P.	3" W.P.	3" W.P.		

* The depth of Fore and Afters should be stated from the underside of the hatches in all cases.

(If the sill of the lowest side scuttle will be less than 6 inches above the Indian Summer Load Line if assigned under the tables, state vertical distance from top of deck at side amidships to lower edge of lowest side scuttle.)

The following information is to be given in all Cases of vessels dealt with under Paras. 11, 12 (under 15 feet Moulded depth) and under Shelter Deck Rules.

Strake between Main and Bridge Sheerstrakes?

What is the thickness of the Bridge Sheerstrake?

Delete the words { The Crew are, are not, berthed in the bridge house.
that do not apply { The arrangements to enable them to get backwards and forwards from their quarters are, are not satisfactory.

Length of Bulwarks in well

Area of Freeing Ports required by Para. 11 (e) each side of vessel

Sq. ft.

Ft. Tenths. Ft. Tenths. No.


Freeing Ports = Sq. ft.

x x (each side of vessel)

Total deficiency or excess = Sq. ft.

8.5 - 8.5 (2575) = 31.5

8.5 - 7.55 = 1 inch. State

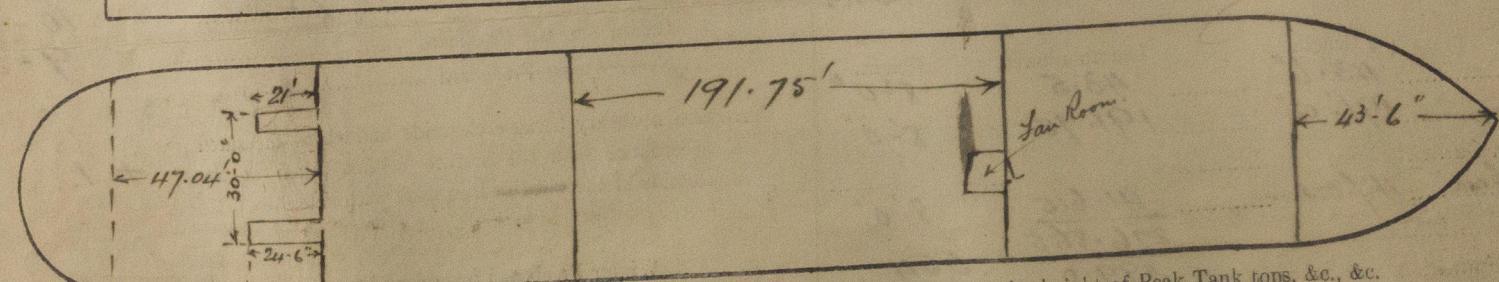

Show hereon line of Floors or Tank Top with position of any Breaks in same; also height of Peak Tank tops, &c., &c.

State any special features in the construction of the Vessel

This vessel has a Cruiser Stern and a Preliminary Freeboard assignment was made please see Secy's Letter M. 15th April 1919. A Freeboard Request is enclosed herewith. Plans of bridge deck, Profile, Decks forward.

Builder Lithgows Ld.

" Address Glasgow Yard, Port Glasgow

Fee £15 : 0 : 0 Received by me

© 2019



Lloyd's Register
Foundation