



S.S. "DORIC STAR"

PLAN SHOWING PARTICULARS FOR FREEBOARD ASSIGNMENT

SCALE $\frac{1}{16}'' = 1 \text{ FOOT}$


PALMERS HEBBURN CO. LTD.

PLAN N^o 311
21-12-38

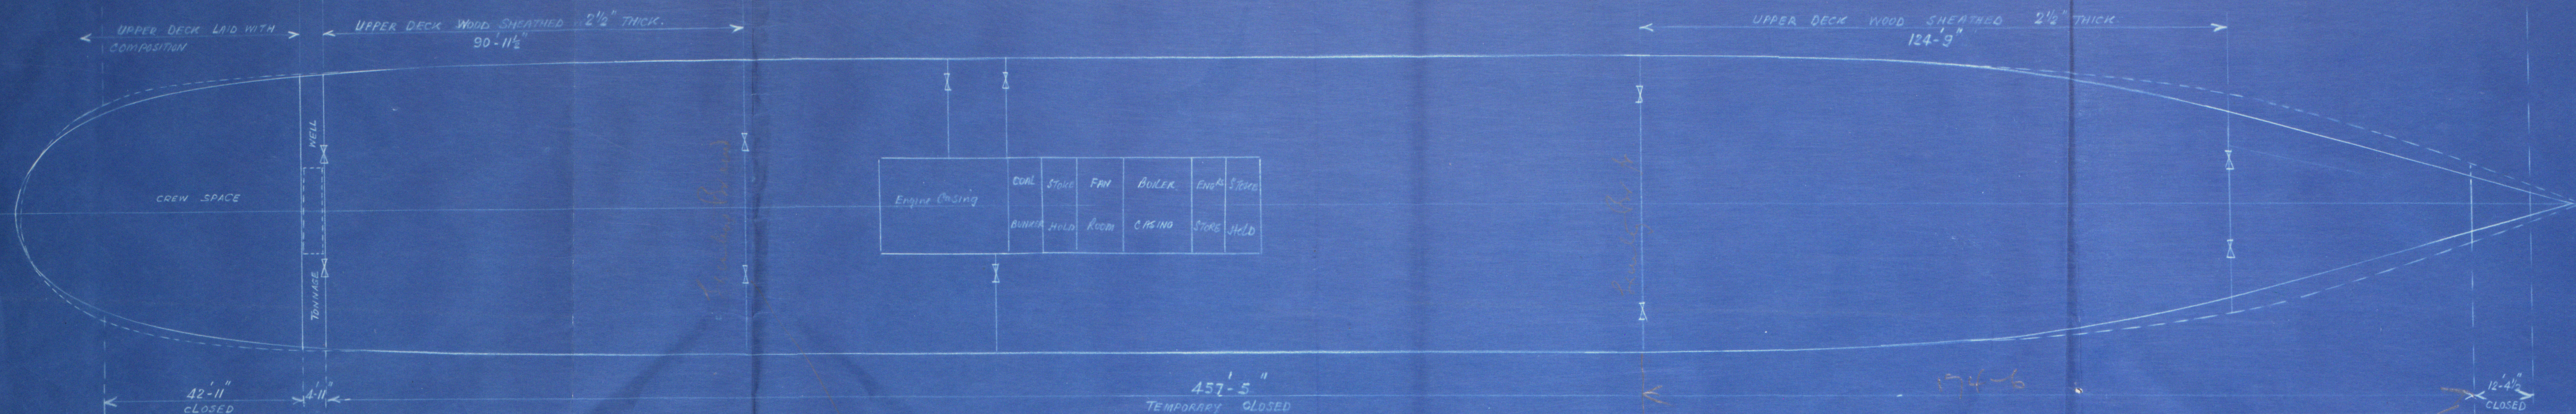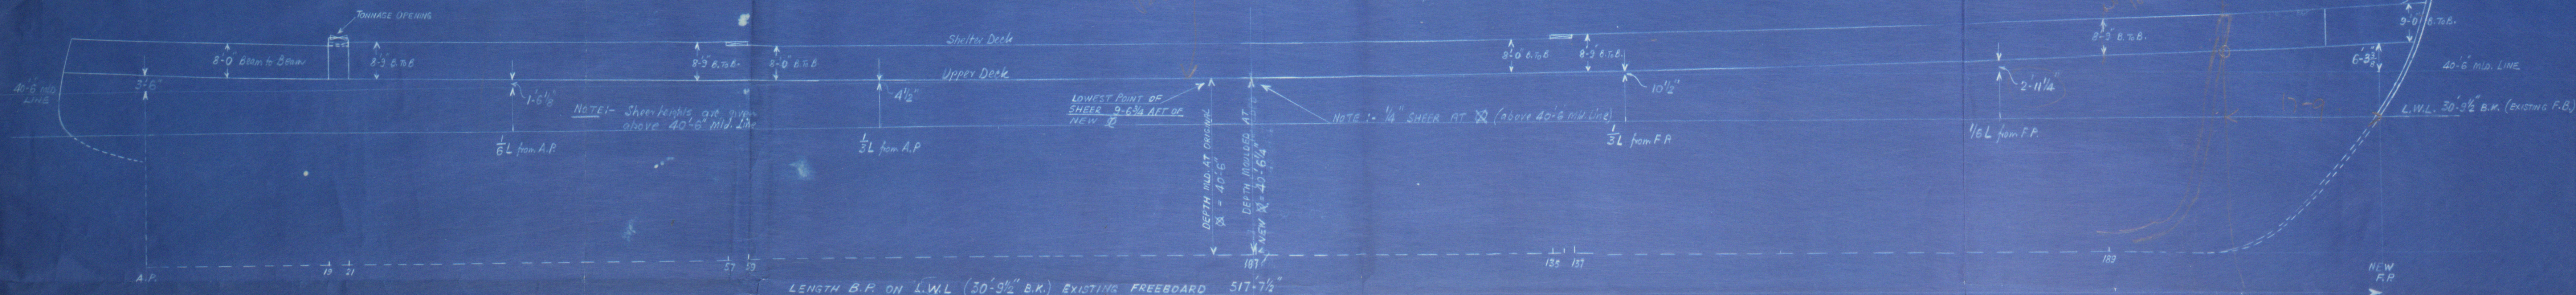

see R.M. 34
with note for 30

RETAIN

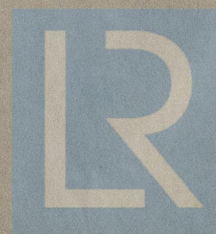

© 2019

Lloyd's Register
Foundation

Doris St
Sheer Diagram
Howe Rpt

W468-00 91



© 2019

Lloyd's Register
Foundation