


S.S. DORIC STAR

SKETCH OF FORE END SHEWING PROPOSED ADDED LENGTH

SCALE 1/16" = 1 FOOT

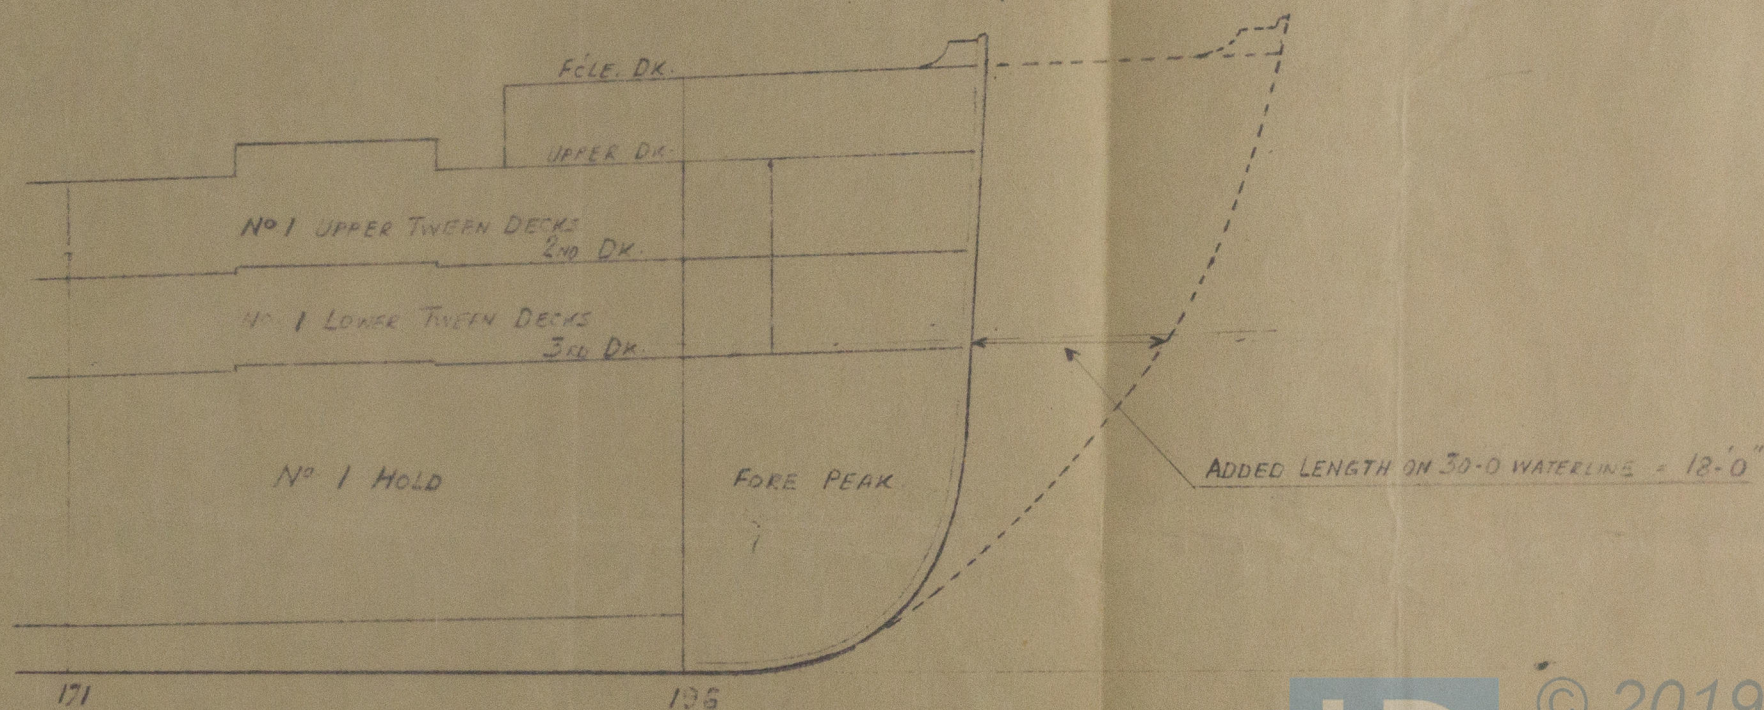

PALMERS HEBBURN CO. LTD.



© 2019
Lloyd's Register
Foundation
W468-0188