


*Mace*

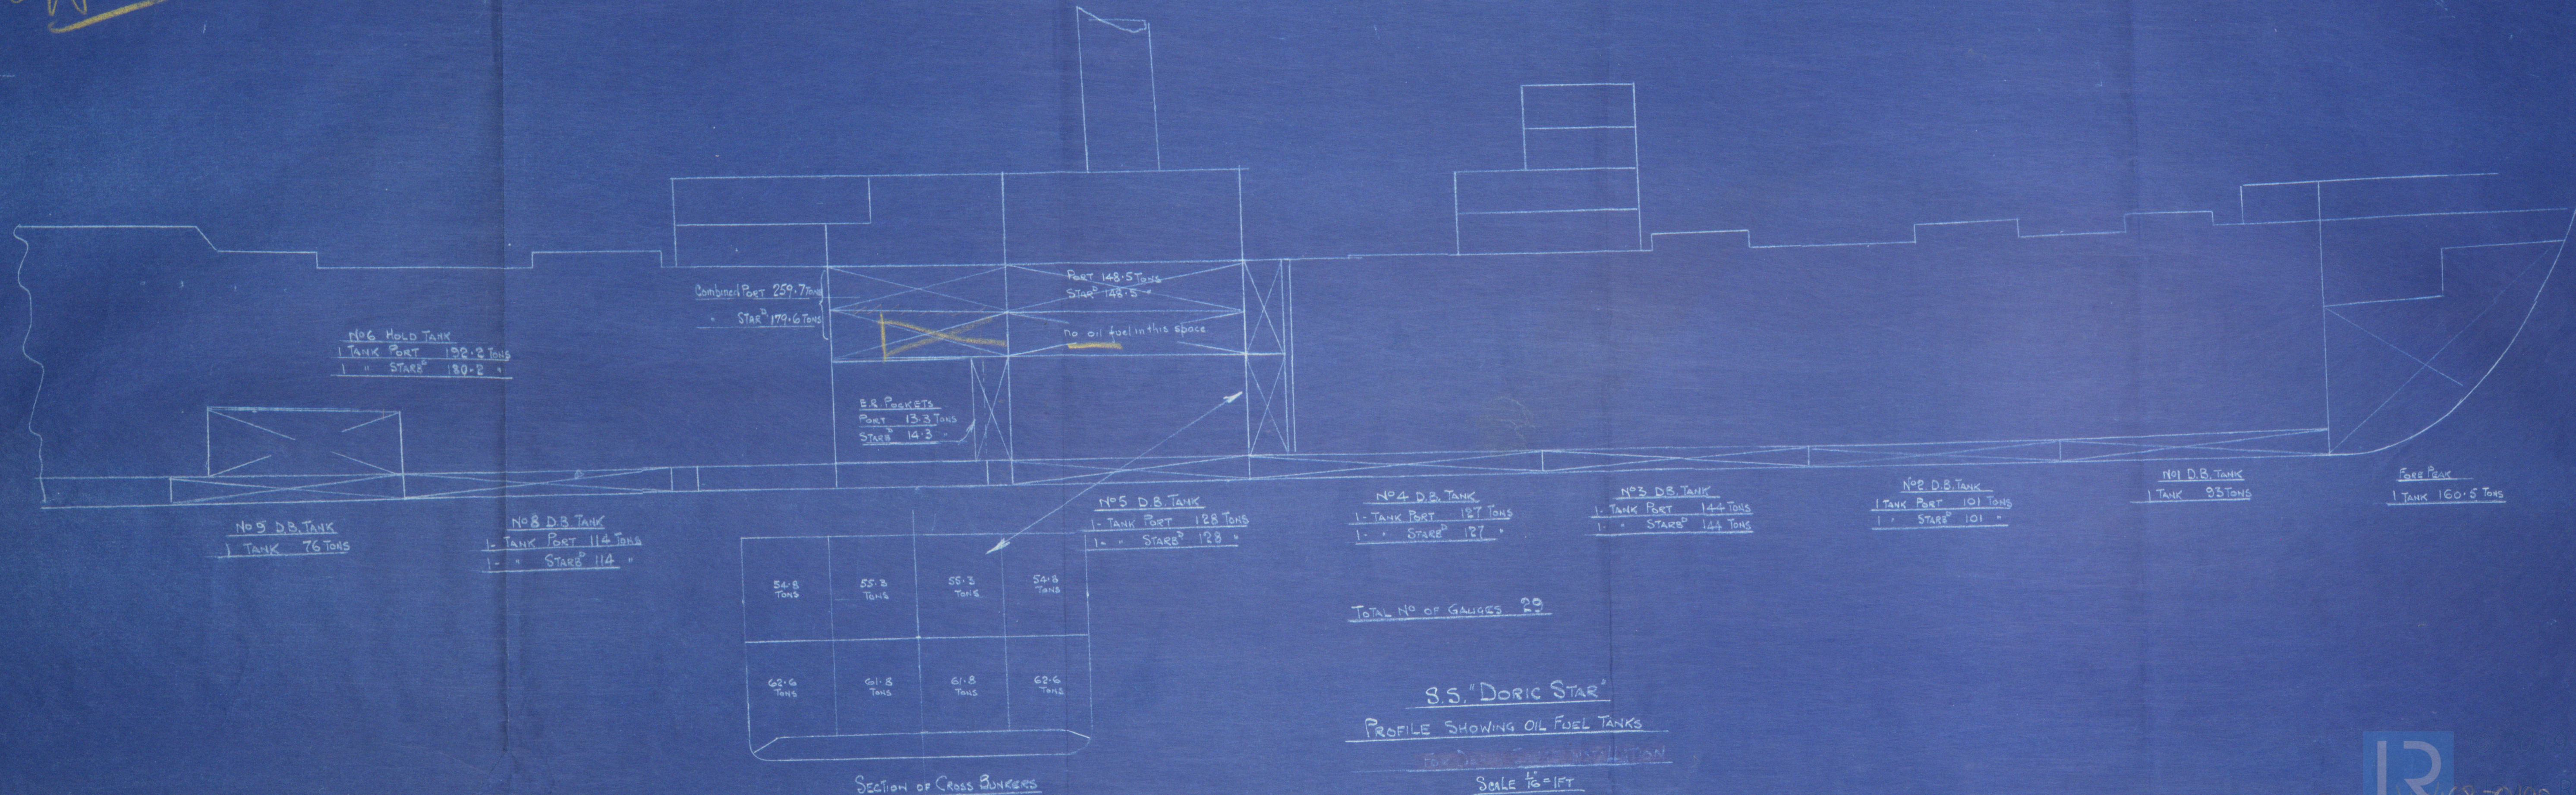




Ampt of  
O F tanks

W468-0192

Prof. Shawing  
O F tanks

25  
RETAIN

W468-0192

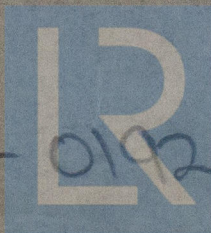

© 2019

Lloyd's Register  
Foundation