


General Ayr.

26

RETAIN

General Ayr.

W468-0197

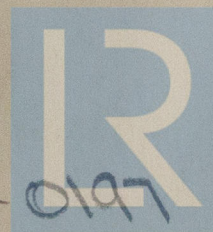


© 2019

Lloyd's Register
Foundation

PALMERS HEBBURN CO. LTD.

Plan No 267.

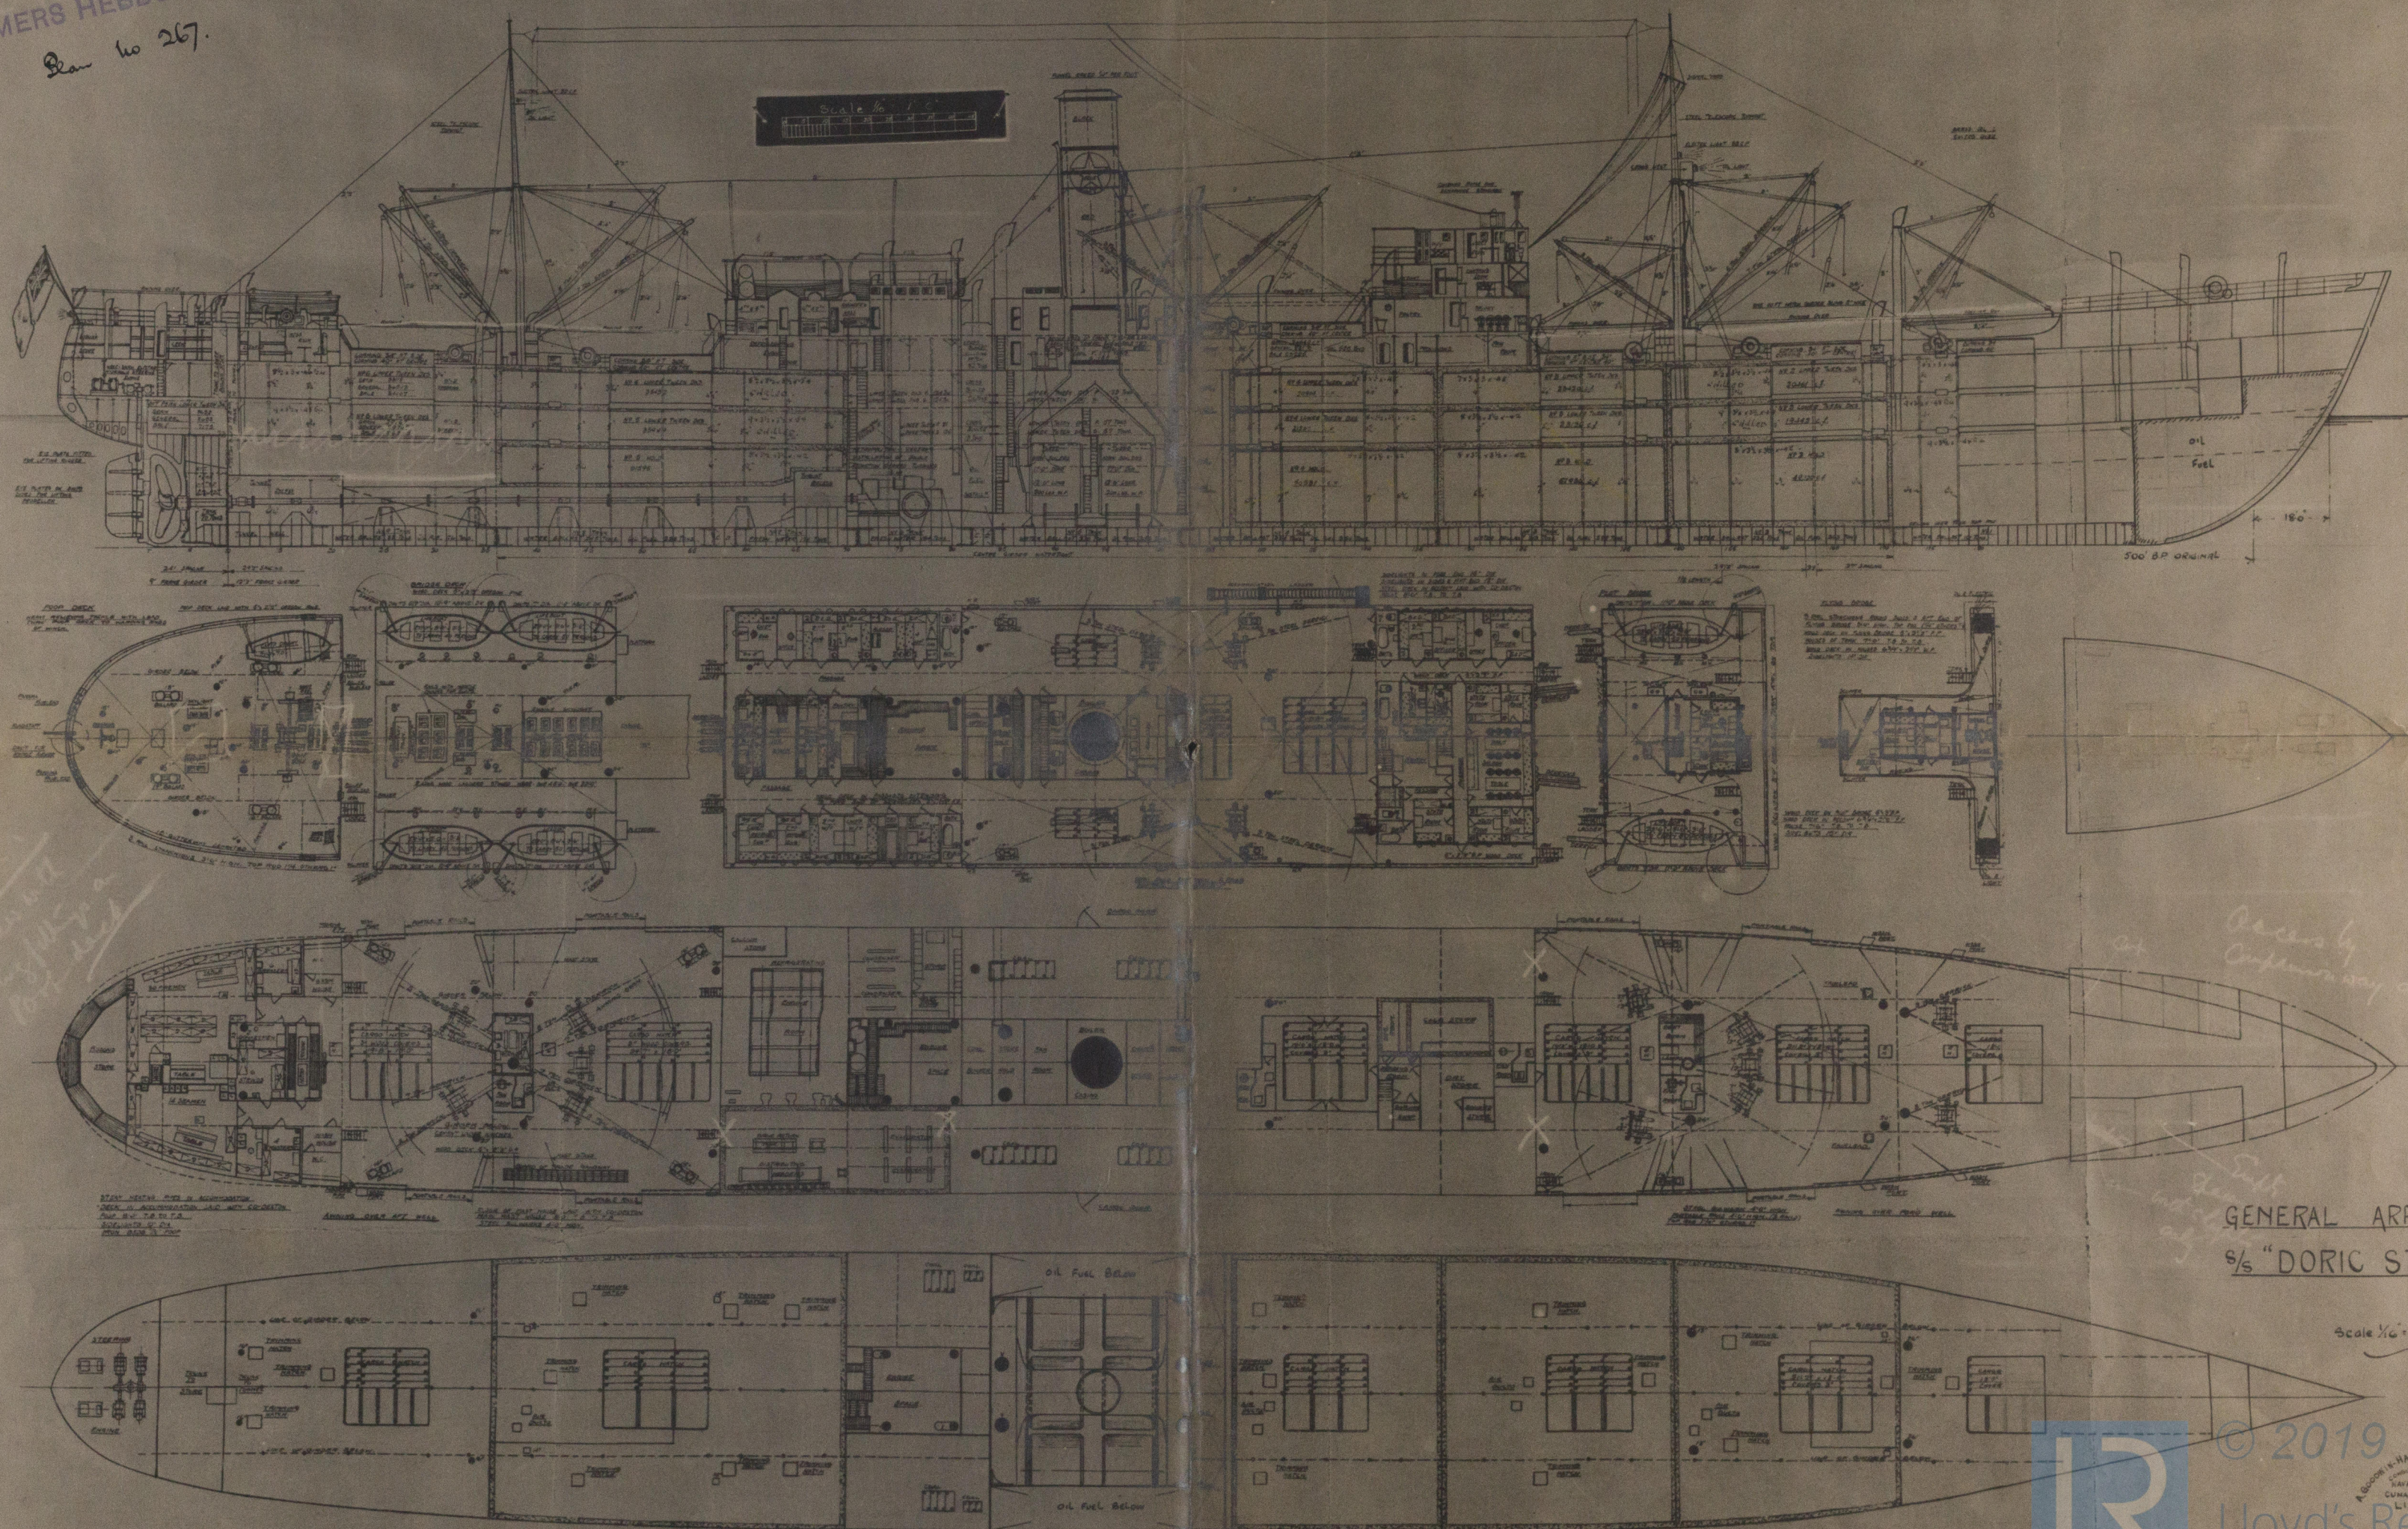

GENERAL ARRANGEMENT
S/S "DORIC STAR"

Scale 1/16" = 1 Foot



© 2019
Lloyd's Register
Foundation
W468-0197