

13.11.02  
4.12.02  
31.1.03



# STEEL SCREW STEAMER

N° 23

scale 1/8" = 1'

## PLAN OF UPPER DECK

Class 100 A1 Lloyd Three Deck Rules.

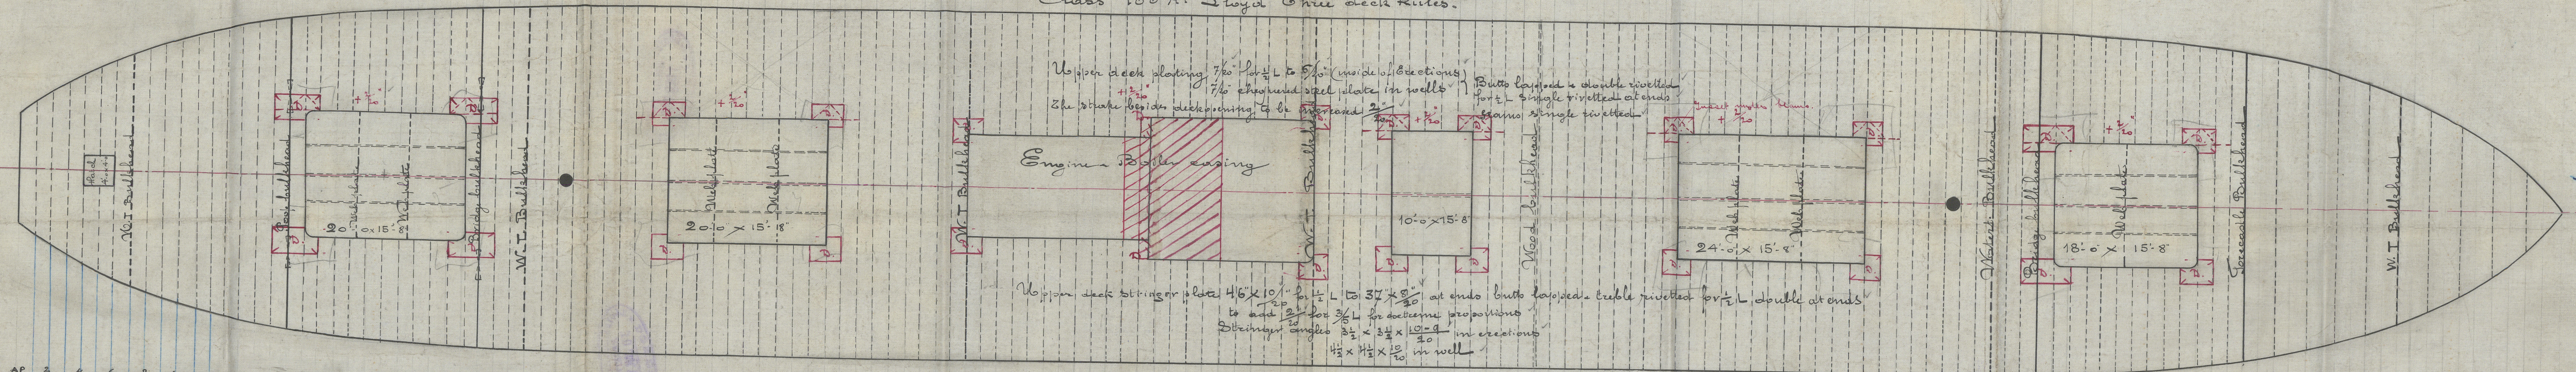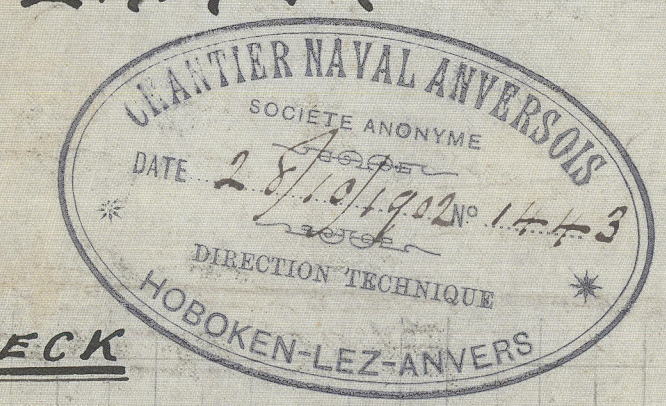


AP 2 4 6 8 10 12 14 16 18 20 22 24 26 28 30 32 34 36 38 40 42 44 46 48 50 52 54 56 58 60 62 64 66 68 70 72 74 76 78 80 82 84 86 88 90 92 94 96 98 100 102 104 106 108 110 112 114 116 118 120 122 124 126 128 130 132 134 136 138 140 142 144 146 148 150 152 154 156 158 160 FP

RETAIN

## PLAN OF MIDDLE DECK

Beams of middle deck 24' apart L 8 1/2" x 3 1/2" x 1/4" Ranges.  
Beams at hatch ends L 11 3/4" x 4" x 1/4" Ranges.  
Hoboken 21-11-02

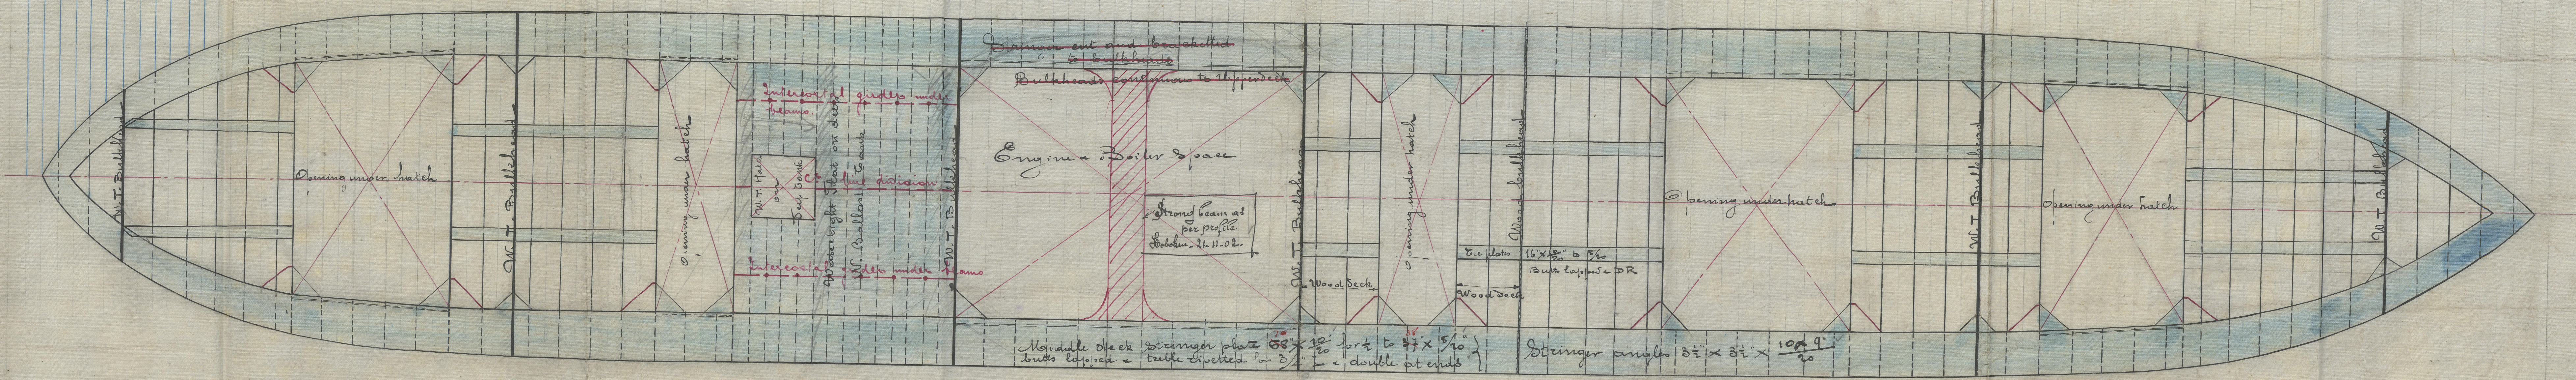

RETAIN




St. Rosalia  
Ant. 8962.

27 Oct 21

No. 23





Class of ...  
Date of ...

...

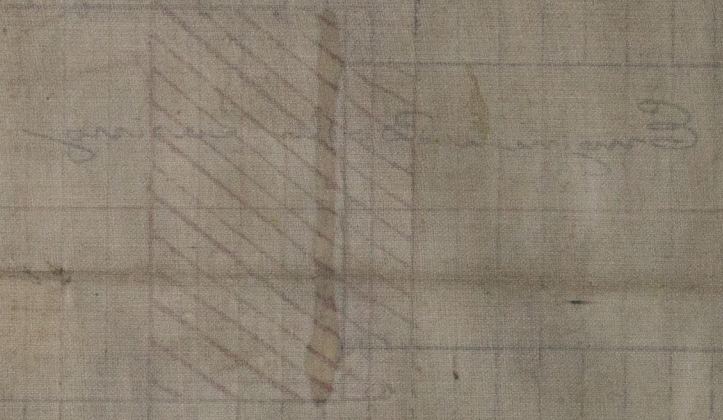

...

W468-0292

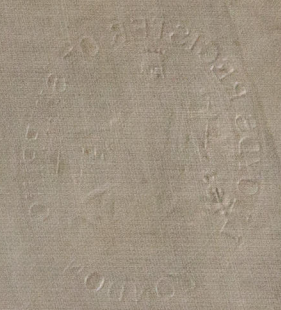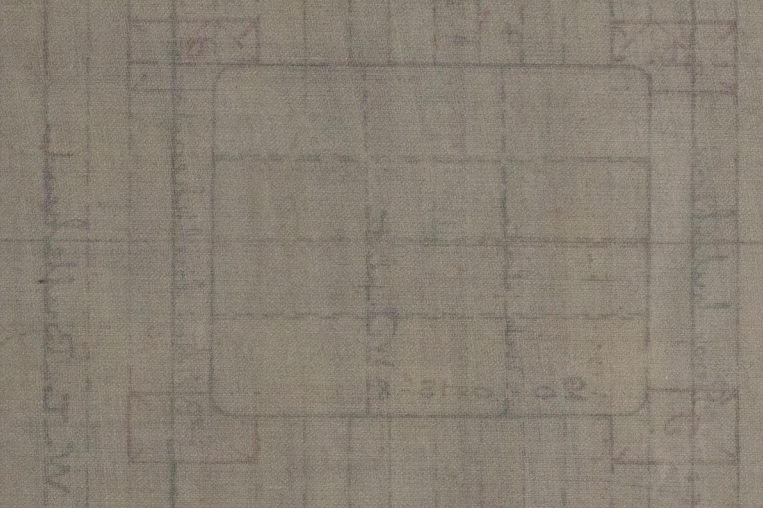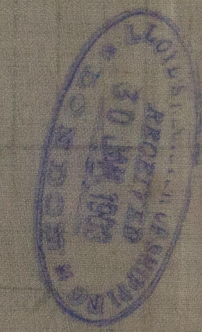 

...



© 2019  
Lloyd's Register  
Foundation



RETAIN

Plan of ~~the~~ Deck Plan



RETAIN

W 468-0202

W 468-0202



© 2019

Lloyd's Register  
Foundation