

J. S. Ybarra No 14, W. H. R. Report No: 5106.

S.S. N^o 210

Admission Section

IRON SCREW STEAMER

DIMENSIONS.

	FEET
LENGTH OVER ALL	282.0
Do. "B.P.	270.0
BREADTH	39.0
DEPTH IN HOLD	18.9
Do. MOULDED	21.2
TONNAGE O.M.	1996
HORSE POWER	200
CLASS	100 A. 1. Lloyd

Scale $\frac{1}{2} = 1$ Foot.

'Churning decked'

250000.125		
2	Bowers (ex-Stock)	132 bwt each.
1	Stream	24 1/4
1	Kedge	110 1/2
1	"	5 1/4
1	"	2 1/2
270	fathoms of	113 1/2 stud chain cable.
25	"	112 stream chain
90	"	112 bowline
90	"	9 1/2 Hawser.
90	"	


1/2 Breadth	19.50	
1/2 Girth	38.25	
Depth	22.00	
	<u>79.75</u>	Frame No.
	2685	

Proportions
D. to L. --- 12.20 ✓
B. to L. --- 6.88 ✓

$$\begin{array}{r}
 39845 \\
 63800 \\
 44850 \\
 15950 \\
 \hline
 21412.845
 \end{array}$$
 Plating N.



J. L.
W. Hpl. 29/7/82

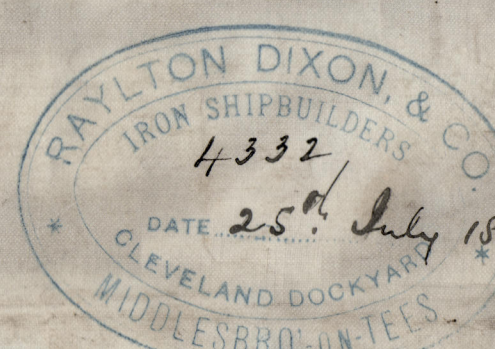

S.S N° 210

J.H.L.
2/8/82

W469-0376

RETAIN

Middle Section

RETAIN

W469-0376

RETAIN



© 2019

Lloyd's Register
Foundation