

RECEIVED 14th AUG. 82.


Ltr. to West Hartlepool
14/8/82

A.D. Ybarra; No. 4; W. H. P. Report No 5706

Amended part of Midship section.

No 210.

Scale $\frac{1}{2} = 1$ Foot.

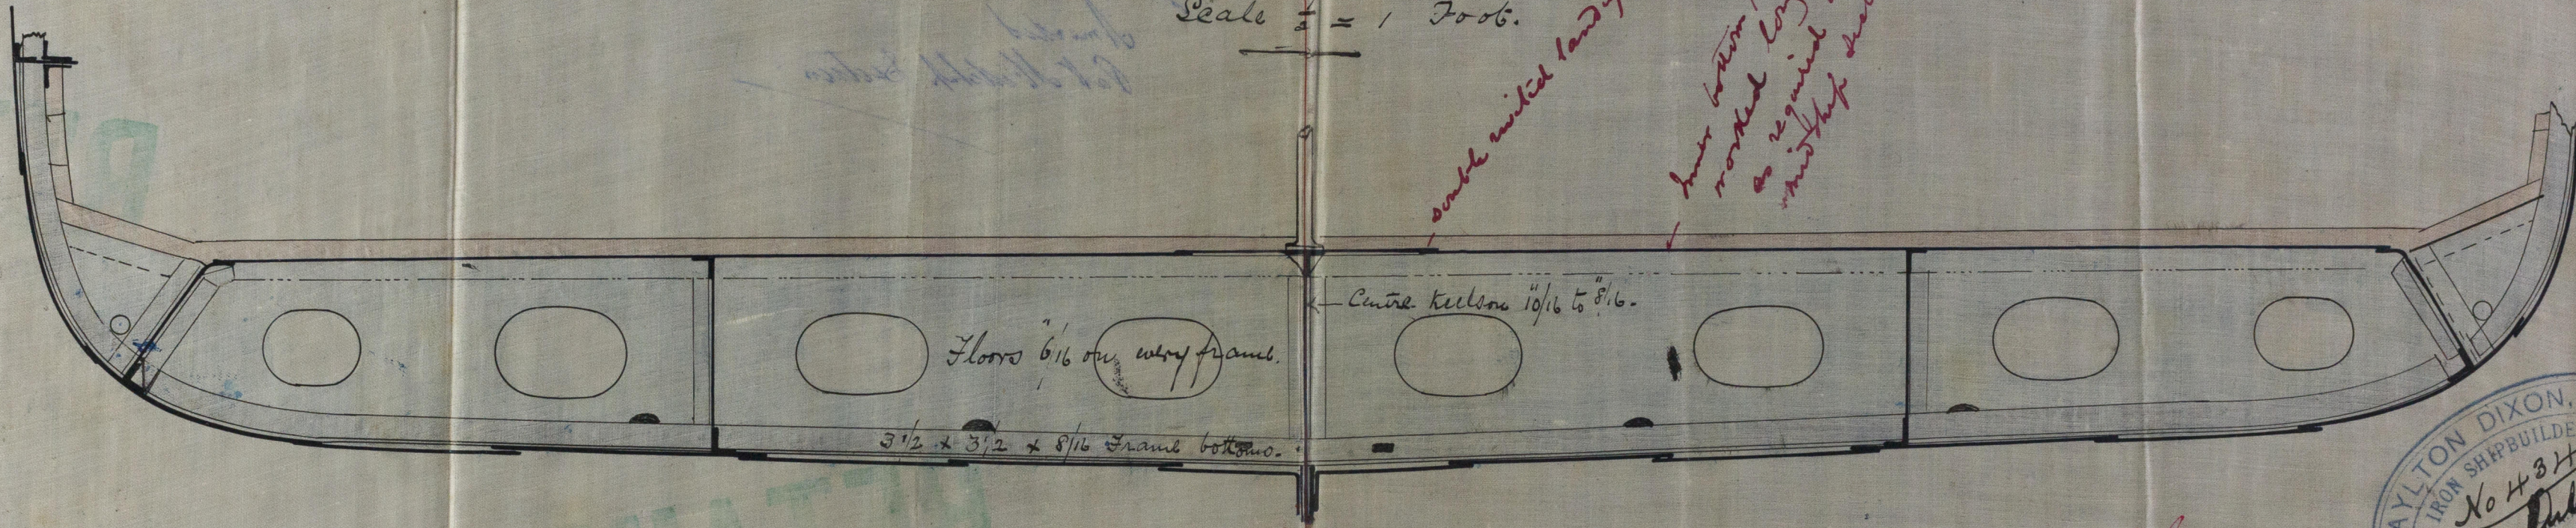

double mild landing edge
have bottom plating
worked longitudinally
as required in approved
midship section

14/8/82 E.C.

12/8/82

RAYLTON DIXON, & CO.
IRON SHIPBUILDERS
No 4343
DATE 10th August 1882
CLEVELAND DOCKYARD
MIDDLESBROUGH-ON-TEES

© 2019
Lloyd's Register
Foundation

RETAIN

*Amended
Part Midship Section*

RETAIN

© 2019

Lloyd's Register
Foundation

W469-0377

