


RECEIVED 1st JULY, 82.
Ltr: to West ppl.
9/8/82
14/8/82

A. L. Ybarra Sr. & W. S. Pl. Report No 5106.

PROFILE S.S.Nº 210

SCALE.—1/8 INCH TO 1 FOOT

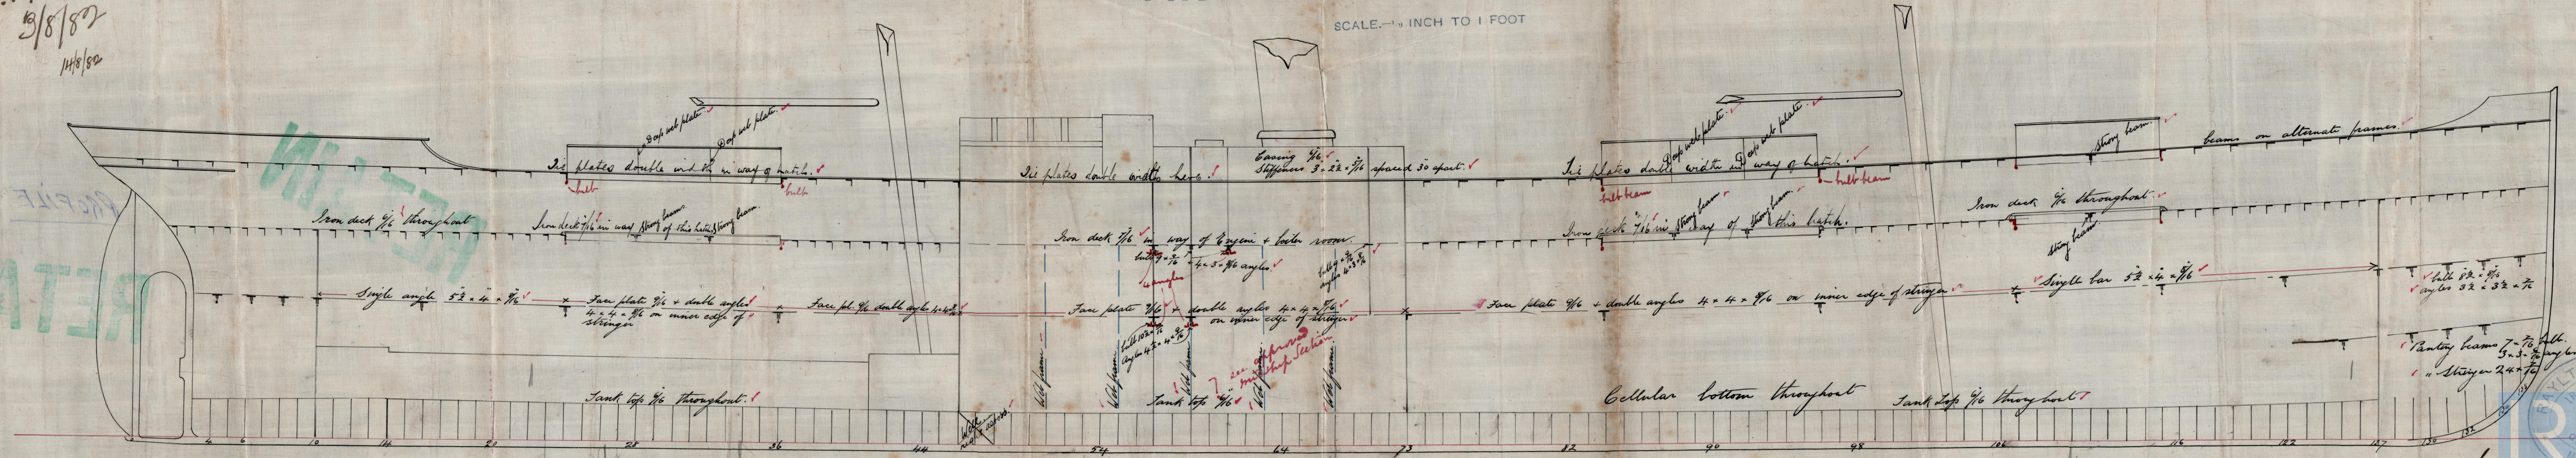

J. J.
W. Hpl. 29/4/




W 469-0378

2/8782

RETAIN

PROFILE.

RETAIN

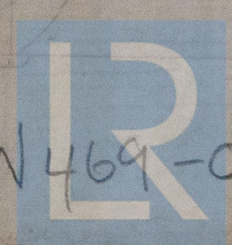

© 2019

W 469-0378
d's Register
Foundation