

Verification

Vancouver Report No 690

Rpt. 11b.

War Camp 26131

REC'D NEW YORK Dec 2 3 1918

Index No. 27376

Lloyd's Register of Shipping.

SURVEYS FOR FREEBOARD.—STEAM SHIPS.

PARTICULARS RELATING TO ALL STEAM SHIPS ~~WHICH HAVE DECKED OR WITH TOP GALLANT FORECASTLES, SHORT POOPS AND BRIDGE HOUSES DISCONNECTED,~~

Port of Survey Vancouver B.C.

Date of Survey 28/11/18

Name of Surveyor Jas Kinnear

~~WHICH HAVE DECKED OR WITH TOP GALLANT FORECASTLES HAVING LONG POOPS OR RAISED QUARTER DECKS CONNECTED WITH BRIDGE HOUSES, OR OTHERWISE~~

Ship's Name "Alfonso Perez" of Santander

Port of Registry and Nationality British

Official Number 143090

Gross Tonnage

Date of Build 1918

Particulars of Classification 100.A1. Class Contemplated

Number in Register Book 705

Registered dimensions from Ship's Register.	LENGTH.	BREADTH.	DEPTH.	UNDER DECK TONNAGE.
	<u>410.5</u>	<u>54.0</u> <u>54.1' ex</u>	<u>27.16</u> <u>27.50</u>	<u>5140.44</u> <u>Including peaks</u>
Length on LOADLINE.	<u>410.0</u>	Frame Depth <u>10</u> Rule <u>6</u>	Ceiling <u>+20</u> Sheer <u>+1.38</u> <u>4 Tank Top 4" drop</u> <u>+ .16</u>	Peak <u>FP 45.94</u> Tanks <u>AP 96.26</u>
CORRECTED DIMENSIONS.	<u>410.0</u>	<u>53.44</u>	<u>28.9</u> <u>29.74</u>	<u>5140.44</u> <u>Including peaks</u>

Moulded Depth as measured..... 29.9"

Addition for Keel below base line for draught record. 2.75 inches.

NOTE.— If the depth is measured when vessel is afloat, the details of measurement should be reported.

CORRECTION FOR LENGTH.

Length of Ship on Loadline.....	<u>410.0"</u>	
Length in Table	<u>357.0</u>	
Difference	<u>53.0</u>	
Correction for 10ft., Table A.	<u>1.5</u>	Table C. <u>8</u>
× Difference divided by 10	<u>4.95</u>	(if required.) <u>4.24</u>
If $\frac{1}{10}$ ths length covered divide by 2	<u>+8</u>	<u>+4.4</u>

CORRECTION FOR IRON DECK.

Proportion covered, if less than $\frac{1}{10}$ ths length covered	<u>.50</u>
Thickness of usual wood deck, less stringer	<u>3 1/2</u>
	<u>3 1/2 × .50 = 1.75</u>
	<u>-1 3/4</u>

CORRECTION FOR ROUND OF BEAM.

Breadth at Gunwale amidships.....	<u>54.0"</u>	
Round of Beam	<u>13 1/2</u>	
Normal round.....	<u>13 1/2</u>	
Difference	<u>✓ ÷ 2 =</u>	
Proportion of Deck uncovered (Para. 19)	<u>.499</u>	

NOTE.— The round of beam should be reported on the full breadth of vessel at the gunwale.

Co-efficient of fineness..... .82.81

Any modification necessary [Para. 4 (a) to (e)]* .02

Co-efficient as corrected77.79

Sheer { Stem..... 141 } 212 ÷ 2 = 106 Mean
at { Sternpost... 41 }

Sheer at $\frac{1}{2}$ of the length from { Stem 40 } 111 ÷ 2 = 55.5 Mean
{ Sternpost 41 }

Gradual mean Sheer allowed 100.9 + 55 = 100.9

Standard mean Sheer [Table, Para. 18] 57.0 Correction

Difference..... 49.9 ÷ 4 = 12 1/2

§ If limited as Para. 18 (f) 12.47 - 12 1/2

Rise in Sheer { At front of bridge house

from amidships { [Para. 18 (e)] At after end of forecastle

Fall in Sheer { Para. 18 (d) } ÷ 2 =

Length uncovered

Correction

ALLOWANCE FOR DECK ERECTIONS:—

Freeboard, Table C.....	<u>4.83 1/4</u>
Correction for Length, if required (Para. 12, 13, and 14)	<u>+ 1 1/2</u>
Freeboard by Table A, corrected for sheer, and for length, if required (Para. 12, 13, and 14)	<u>7.18 3/4</u>
Difference	<u>2.58 1/2</u>
Percentage as below.....	<u>32%</u>
	<u>29.75 × 32 = 9.52</u>
	<u>100</u>

Correction for R. Q. Dk. if engine and boiler openings not covered by bridge house (Para. 11)

Allowance for Deck Erections -9 1/2

recast	Length.	Length allowed.	Height.
Bridge House	<u>47.0</u>	<u>47.0</u>	<u>8.0</u>
Raise Qr. Dk.....	<u>114.95</u>	<u>114.75</u>	<u>8.5</u>
.....	<u>43.75</u>	<u>42.75</u>	<u>7.75</u>
Total		<u>205.50</u>	<u>501</u>
of Ship		<u>410.00</u>	
loading percentage (Para. 12, 13, or 14)	<u>32%</u>		

BOARD recommended amidships from centre of Disc to top of Statutory Deck Line, (Iron) Deck:—	
Fresh Water Line	above centre of Disc
Indian Summer Line	" " "
Winter Line	below " "
Winter North Atlantic Line	" " "

Freeboard, Table A	<u>4.68 3/4</u>
Correction for Sheer	<u>1.0 1/2</u>
Correction for Length	<u>6.8 3/4</u>
Allowance for Deck Erections	<u>+ 8</u>
Correction for Round of Beam.....	<u>4.7 3/4</u>
Correction for fall in Sheer (if any).....	<u>- 9 1/2</u>
Correction for Round of Beam.....	<u>6.4 3/4</u>
Correction for fall in Sheer (if any).....	<u>✓</u>
Correction for Iron Deck (if required)	<u>- 1 3/4</u>
Additions for non-compliance with provisions of Para. 11 (d) and (e) †	<u>6.2 3/4</u>
Other Corrections (if any)	

Winter Freeboard	<u>6.2 3/4</u>
Summer Freeboard	<u>5.8 3/4</u>
Indian Summer Freeboard	<u>5.8 1/2</u>
N. A. Winter Freeboard	<u>✓</u>
Correction necessary because clearside amidships, measured in accordance with the Statute is not taken at the intersection of the wood or iron deck with side.	<u>+ 1 3/4</u>

Winter Freeboard from deck line	<u>6.4 3/4</u>
Summer " " "	<u>5.10 1/2</u>
Indian Summer " " "	<u>5.4 3/4</u>
N. A. Winter " " "	<u>5.11 1/2</u>
	<u>5.10 1/2</u>
	<u>5 1/2</u>
	<u>5</u>

When planking, or ceiling are of unusual thickness the breadth of vessel to inside should be reported if possible.

Allowance for deck erections under Para. 11 where the sheer drops abaft amidships is to be taken from the level of the top of the amidship beam.

Standard mean sheer means the sheer measured at the stem and stern and forecastles, it means the sheer measured at points distant from stem and stern-post.

† State dimensions of freeing port area on back of this form.

The Surveyor should state whether the fall in sheer as reported is measured relatively to the straight line of keel or to the mean line of the hull, and also the usual load draft forward and aft, should be reported.

RECEIVED JUN 11 1981

RECEIVED 24 NOV 1924

Lloyd's Register of Shipping
Foundation
MARKING REPORT
RECEIVED 1.4.19

1900-11471-0061

Do all the Frames extend to the top height in the Poop? *Yes* Raised Quarter Deck? *Yes* Bridge House? *Yes* Forecastle? *Yes*
 To what height do the Reverse Frames extend? *all to upper deck, alternate to fore and aft, none to poop*
 Has the Poop or Raised Quarter Deck an efficient Iron Bulkhead at the fore end? *Yes*
 Give particulars of the means for closing the openings in Bulkhead *Steel hinged*
 Is the Poop or Raised Quarter Deck connected with the Bridge House? *No* Has the Bridge House an efficient Bulkhead at the fore end? *Yes*
 Give particulars of the means for closing the openings in Bulkhead *Steel hinged w. g. doors*
 What is the thickness of the Bridge Front plating? *.40* and Coaming plate? *.44*
 Give scantlings and spacing of the Stiffeners *13x4x4x.32 in way of doors. 8x3 1/2 x 3 1/2 x 27.1" in others, spaced 30" apart*
 Are bracket plates fitted at each end of the Stiffeners? *Large angle clips* Are hor'l. brackets fitted connecting Bridge Bulk'd. with Bulwarks? *Yes*
 Has the Bridge House an efficient Iron Bulkhead at the after end? *Yes*
 How are the openings closed? *with portable steel plates secured with dog bolts, 12" apart & storm boards in riveted channels full height of openings*
 Is the Forecastle at least as high as the main or top-gallant rail? *Yes* Has the Forecastle an efficient Iron or Wood Bulk'd. at after end? *Yes*
 Are the Engine and Boiler openings covered by a Bridge, Poop, Raised Quarter Deck, or enclosed by a Strong Iron or Steel Deckhouse? *By Bridge House*
 If the openings are not so protected are the exposed parts of the Casings efficiently constructed?
 Give thickness of plating; scantlings and spacing of Stiffeners.
 What is the height of the exposed Casings? Are suitable means provided for closing all openings in them in bad weather?


Are the Weather Deck Hatchways efficiently constructed and at least equal to the requirements of Section 28 of the Rules for 1904? *Yes* Give particulars below: *Bridge*

Position and Size.	No. 1 - 31'6" x 21'0"		No. 2 - 31'6" x 21'0"		No. 3 - 15'9" x 14'0"		No. 4 - 31'6" x 21'0"		No. 5 - 31'6" x 21'0"		
	Ship.	Rule.	Ship.	Rule.	Ship.	Rule.	Ship.	Rule.	Ship.	Rule.	
COAMING: Height above top of DECK	36"	36"	36"	36"	33"	33"	36"	36"	36"	36"	
Thickness:	Sides	.50	.50	.50	.50	.50	.50	.50	.50	.50	
	Ends	.50	.50	.50	.50	.50	.50	.50	.50	.50	
SHIFTING BEAMS OR WEB PLATES:	Number	5	5	5	5	3	5	5	5	5	
	Section and Scantlings	1 1/2 x .36 4 x 3 x 9.5" DA	1 1/2 x .36 4 x 3 x 9.5" DA	1 1/2 x .36 4 x 3 x 9.5" DA	1 1/2 x .36 4 x 3 x 9.5" DA	1 1/2 x .36 4 x 3 x 9.5" DA	1 1/2 x .36 4 x 3 x 9.5" DA	1 1/2 x .36 4 x 3 x 9.5" DA	1 1/2 x .36 4 x 3 x 9.5" DA	1 1/2 x .36 4 x 3 x 9.5" DA	1 1/2 x .36 4 x 3 x 9.5" DA
	Material	Steel									
* FORE AND AFTERS:	Number										
	Section and Scantlings										
	Material	Nil									
HATCHES Thickness	3"	3"	3"	3"	3"	3"	3"	3"	3"	3"	
Remarks	Good		Good		Good		Good		Good.		

* The depth of Fore and Afters should be stated from the underside of the hatches in all cases.
 (If the sill of the lowest side scuttle will be less than 6 inches above the Indian Summer Load Line if assigned under the tables, state vertical distance from top of deck at side amidships to lower edge of lowest side scuttle.)

The following information is to be given in all Cases of vessels dealt with under Paras. 11, 12 (under 15 feet Moulded depth) and under Shelter Deck Rules.

What is the thickness of the Bridge Sheerstrake? _____ Strake between Main and Bridge Sheerstrakes? _____
 Delete the words { The Crew are, are not, berthed in the bridge house.
 that do not apply { The arrangements to enable them to get backwards and forwards from their quarters are, are not satisfactory.
 Length of Bulwarks in well _____
 Area of Freeing Ports required by Para. 11 (a) each side of vessel = _____ Sq. ft.
 Ft. Tenths. Ft. Tenths. No. Freeing Ports (each side of vessel) = _____ Sq. ft.
 Total deficiency or excess = _____ Sq. ft.

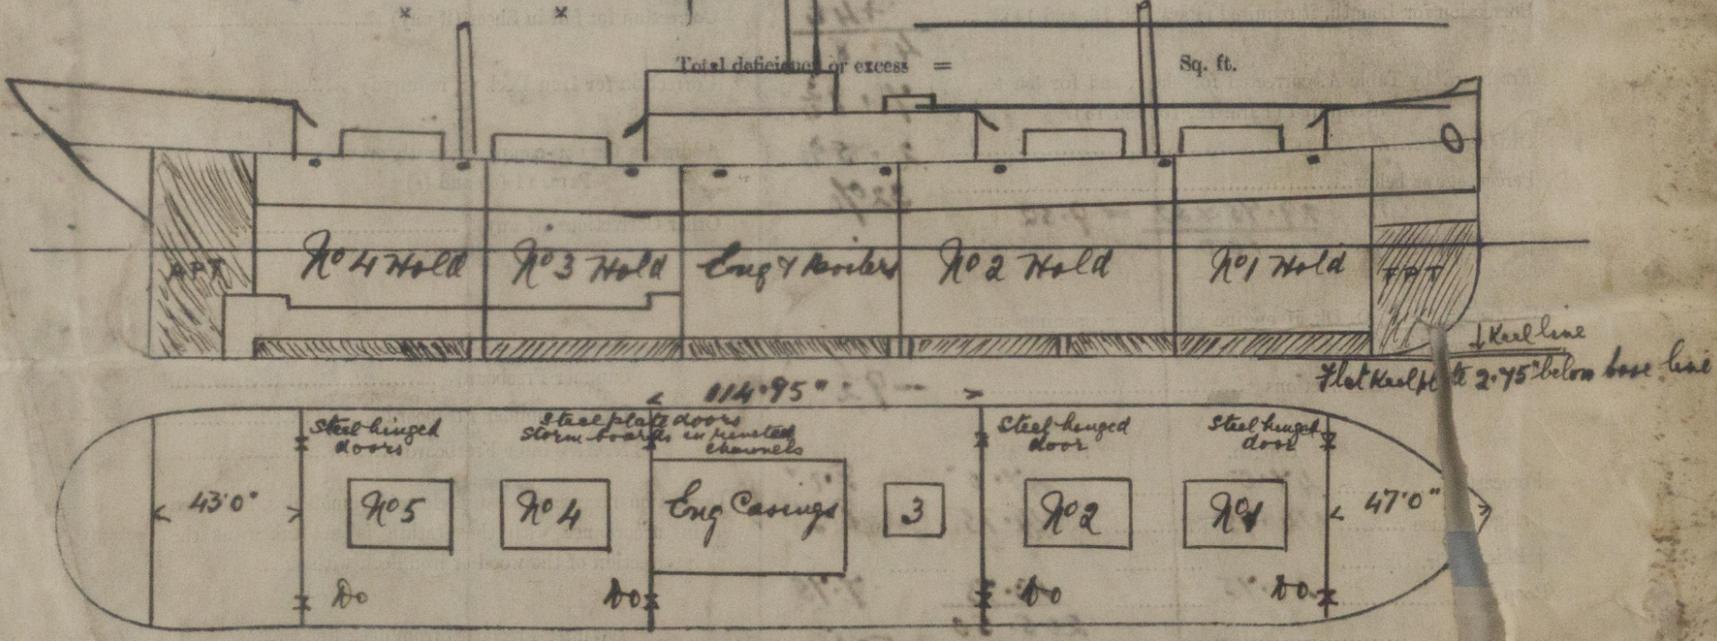

Show hereon line of Floors or Tank Top with position of any Breaks in same; also height of Peak Tank tops, &c., &c.

State any special features in the construction of the Vessel *This vessel is constructed with a Poop, Bridge & Forecastle Decks.*
Request form is here with attached.
 Owners *Imperial Munitions Board; (Managing Owners, Rarburn & Co.)*

Address _____
 Fee \$ *50.00*

Received by me _____

