

J.P.  
12/6



THE NORTH EASTERN MARINE ENGINEERING CO., LTD.,

WALLSEND-ON-TYNE, 192

SHEET No.

D. R. & Co. Ltd. 4801/23.

AMENDED ARRANGEMENT OF TOP MANHOLE.

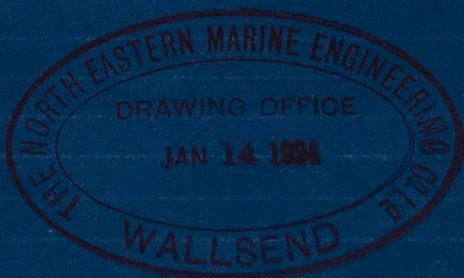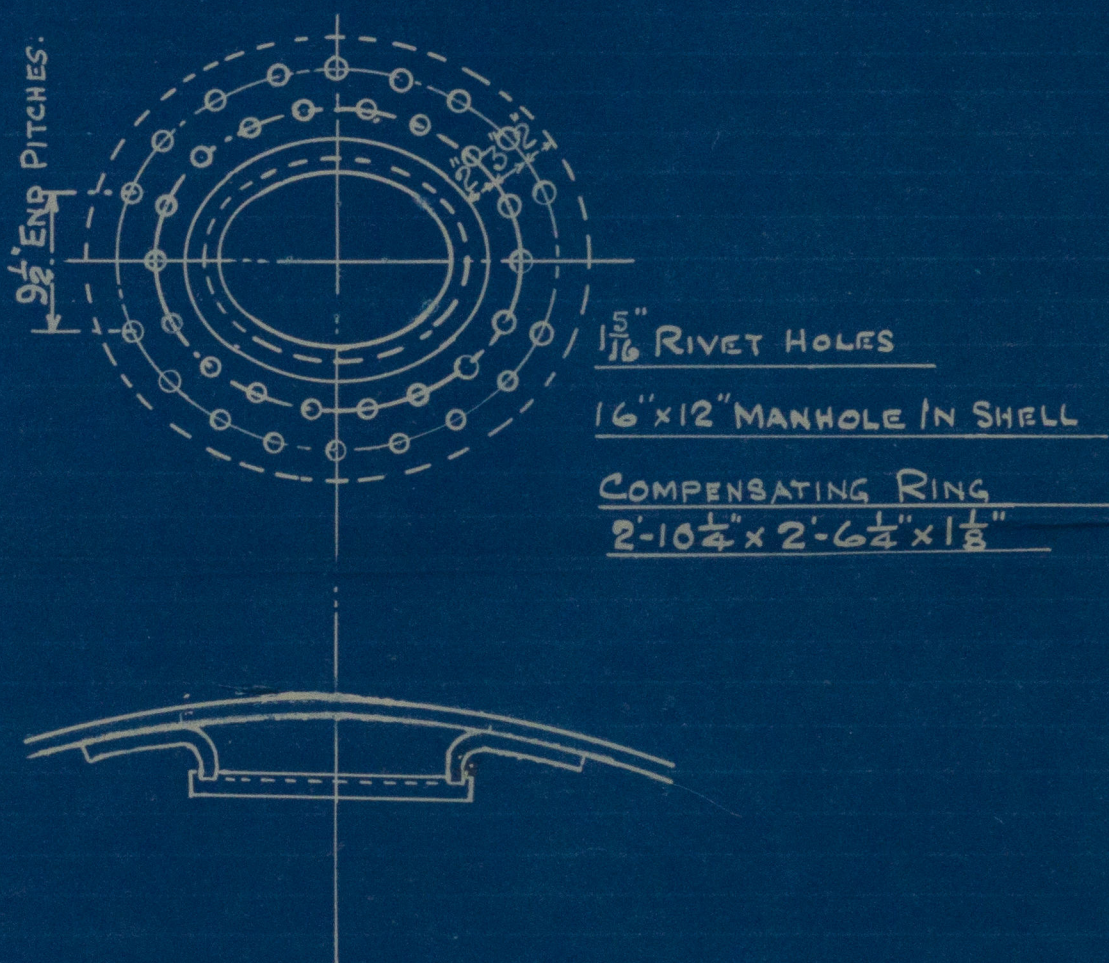

CONTRACT 2566

*Ref  
15.1.24*

N. E. M. E. Co., Limited, Wallsend.

ENCLOSURE

FOR

Messrs *Lloyd's Register*

W472-0133(1/2)

W472-0133(2/2)



North Eastern Maine's  
62566 - Capt. of  
Lep. Meahole.



© 2020

Lloyd's Register  
Foundation

W472-0133(212)