

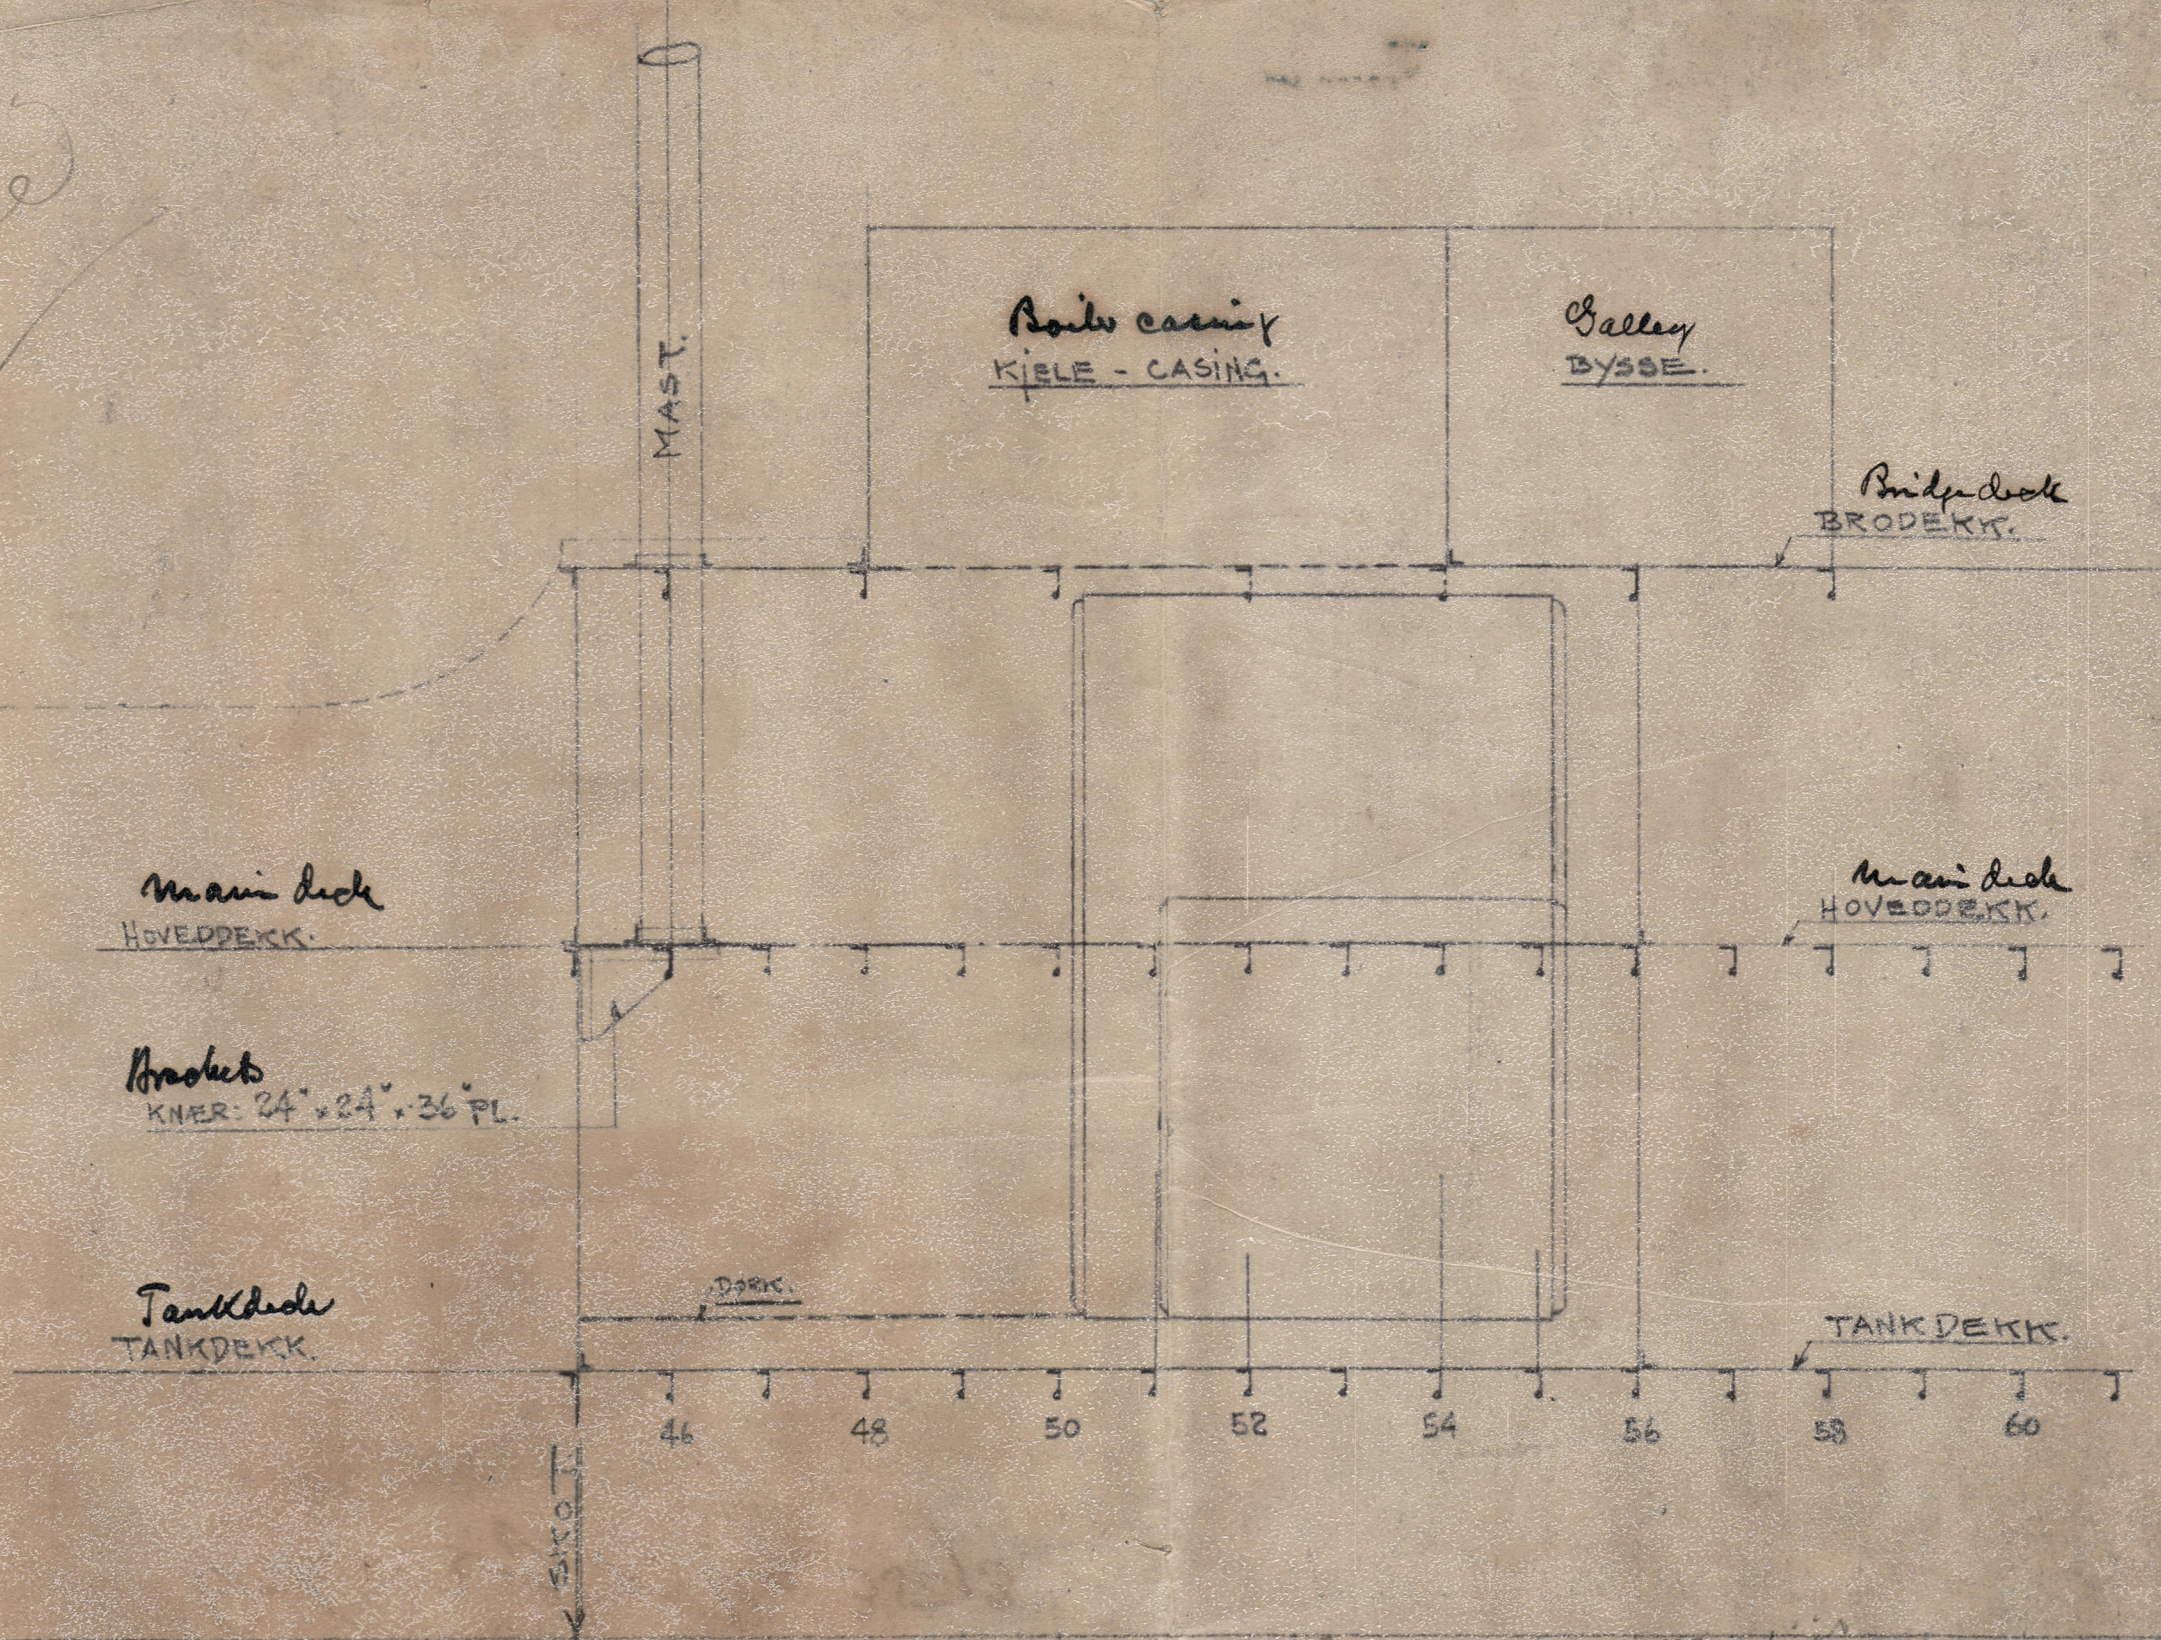
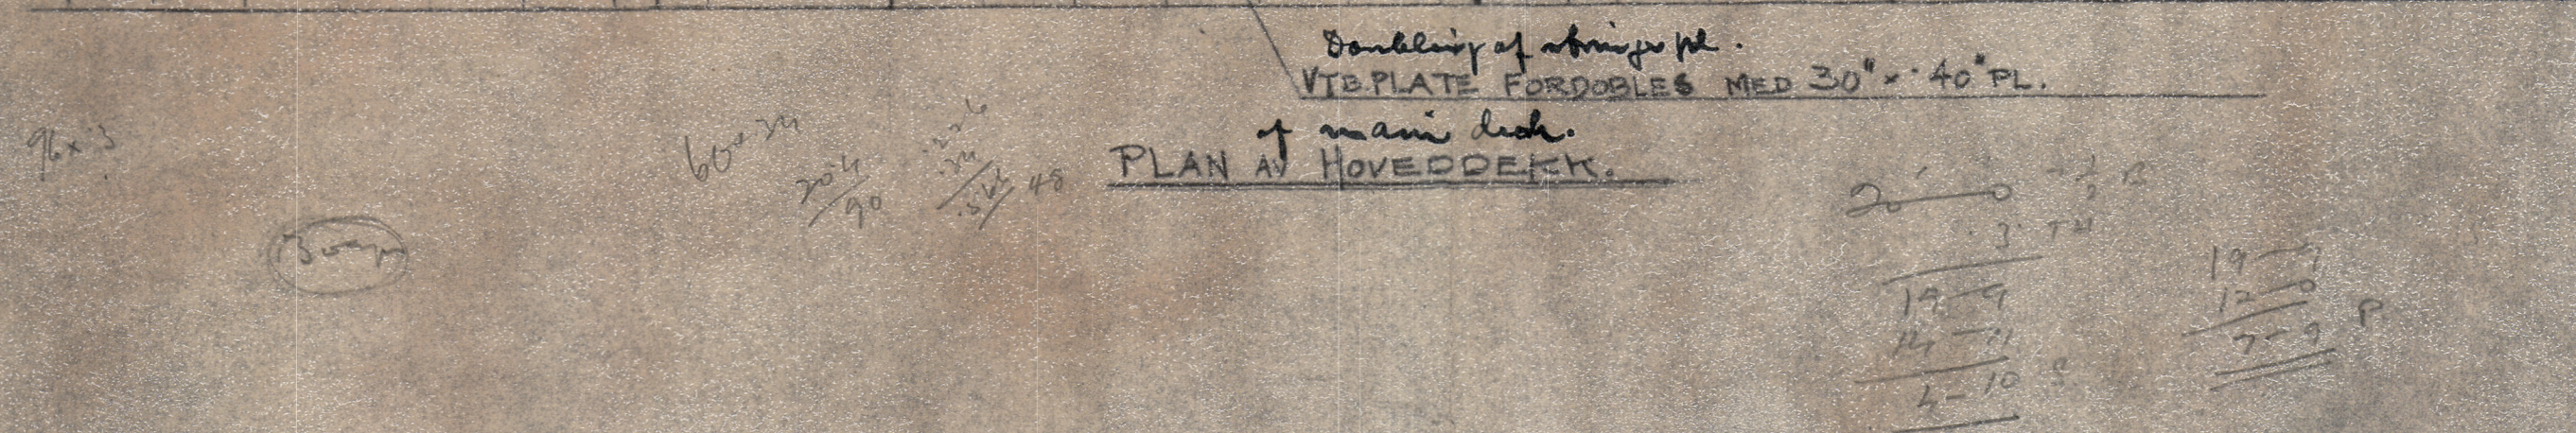
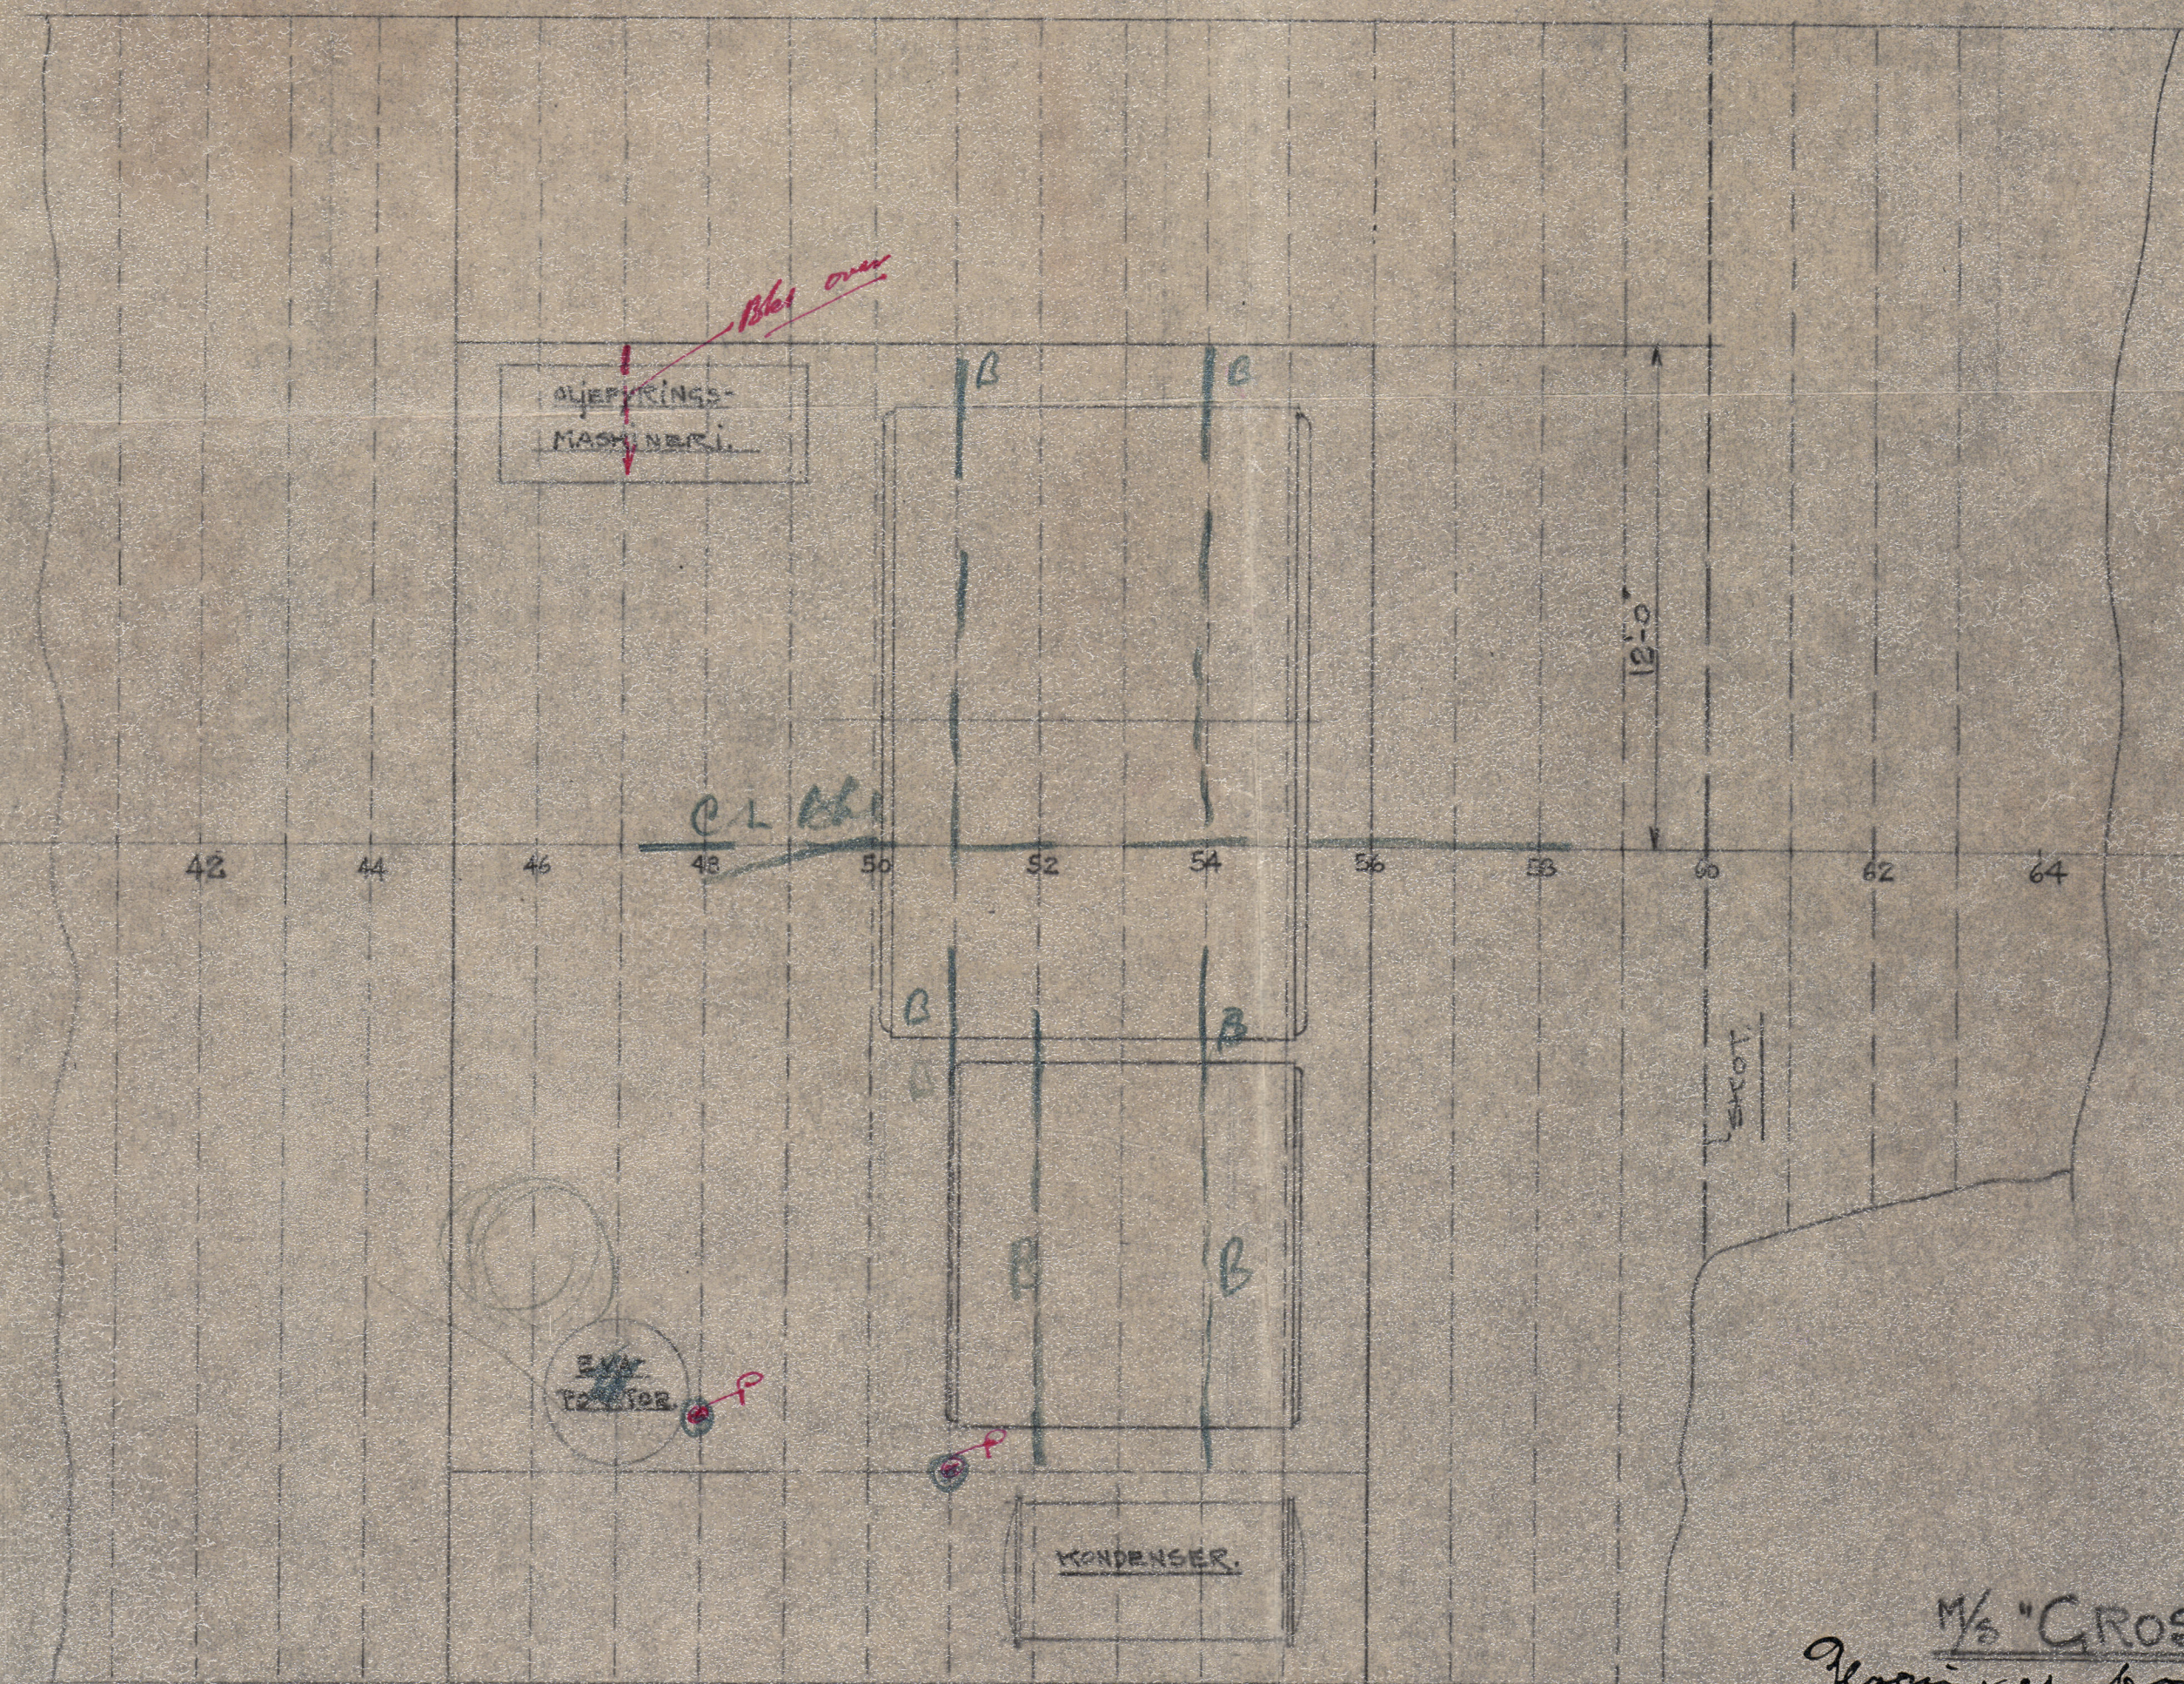


*Office*

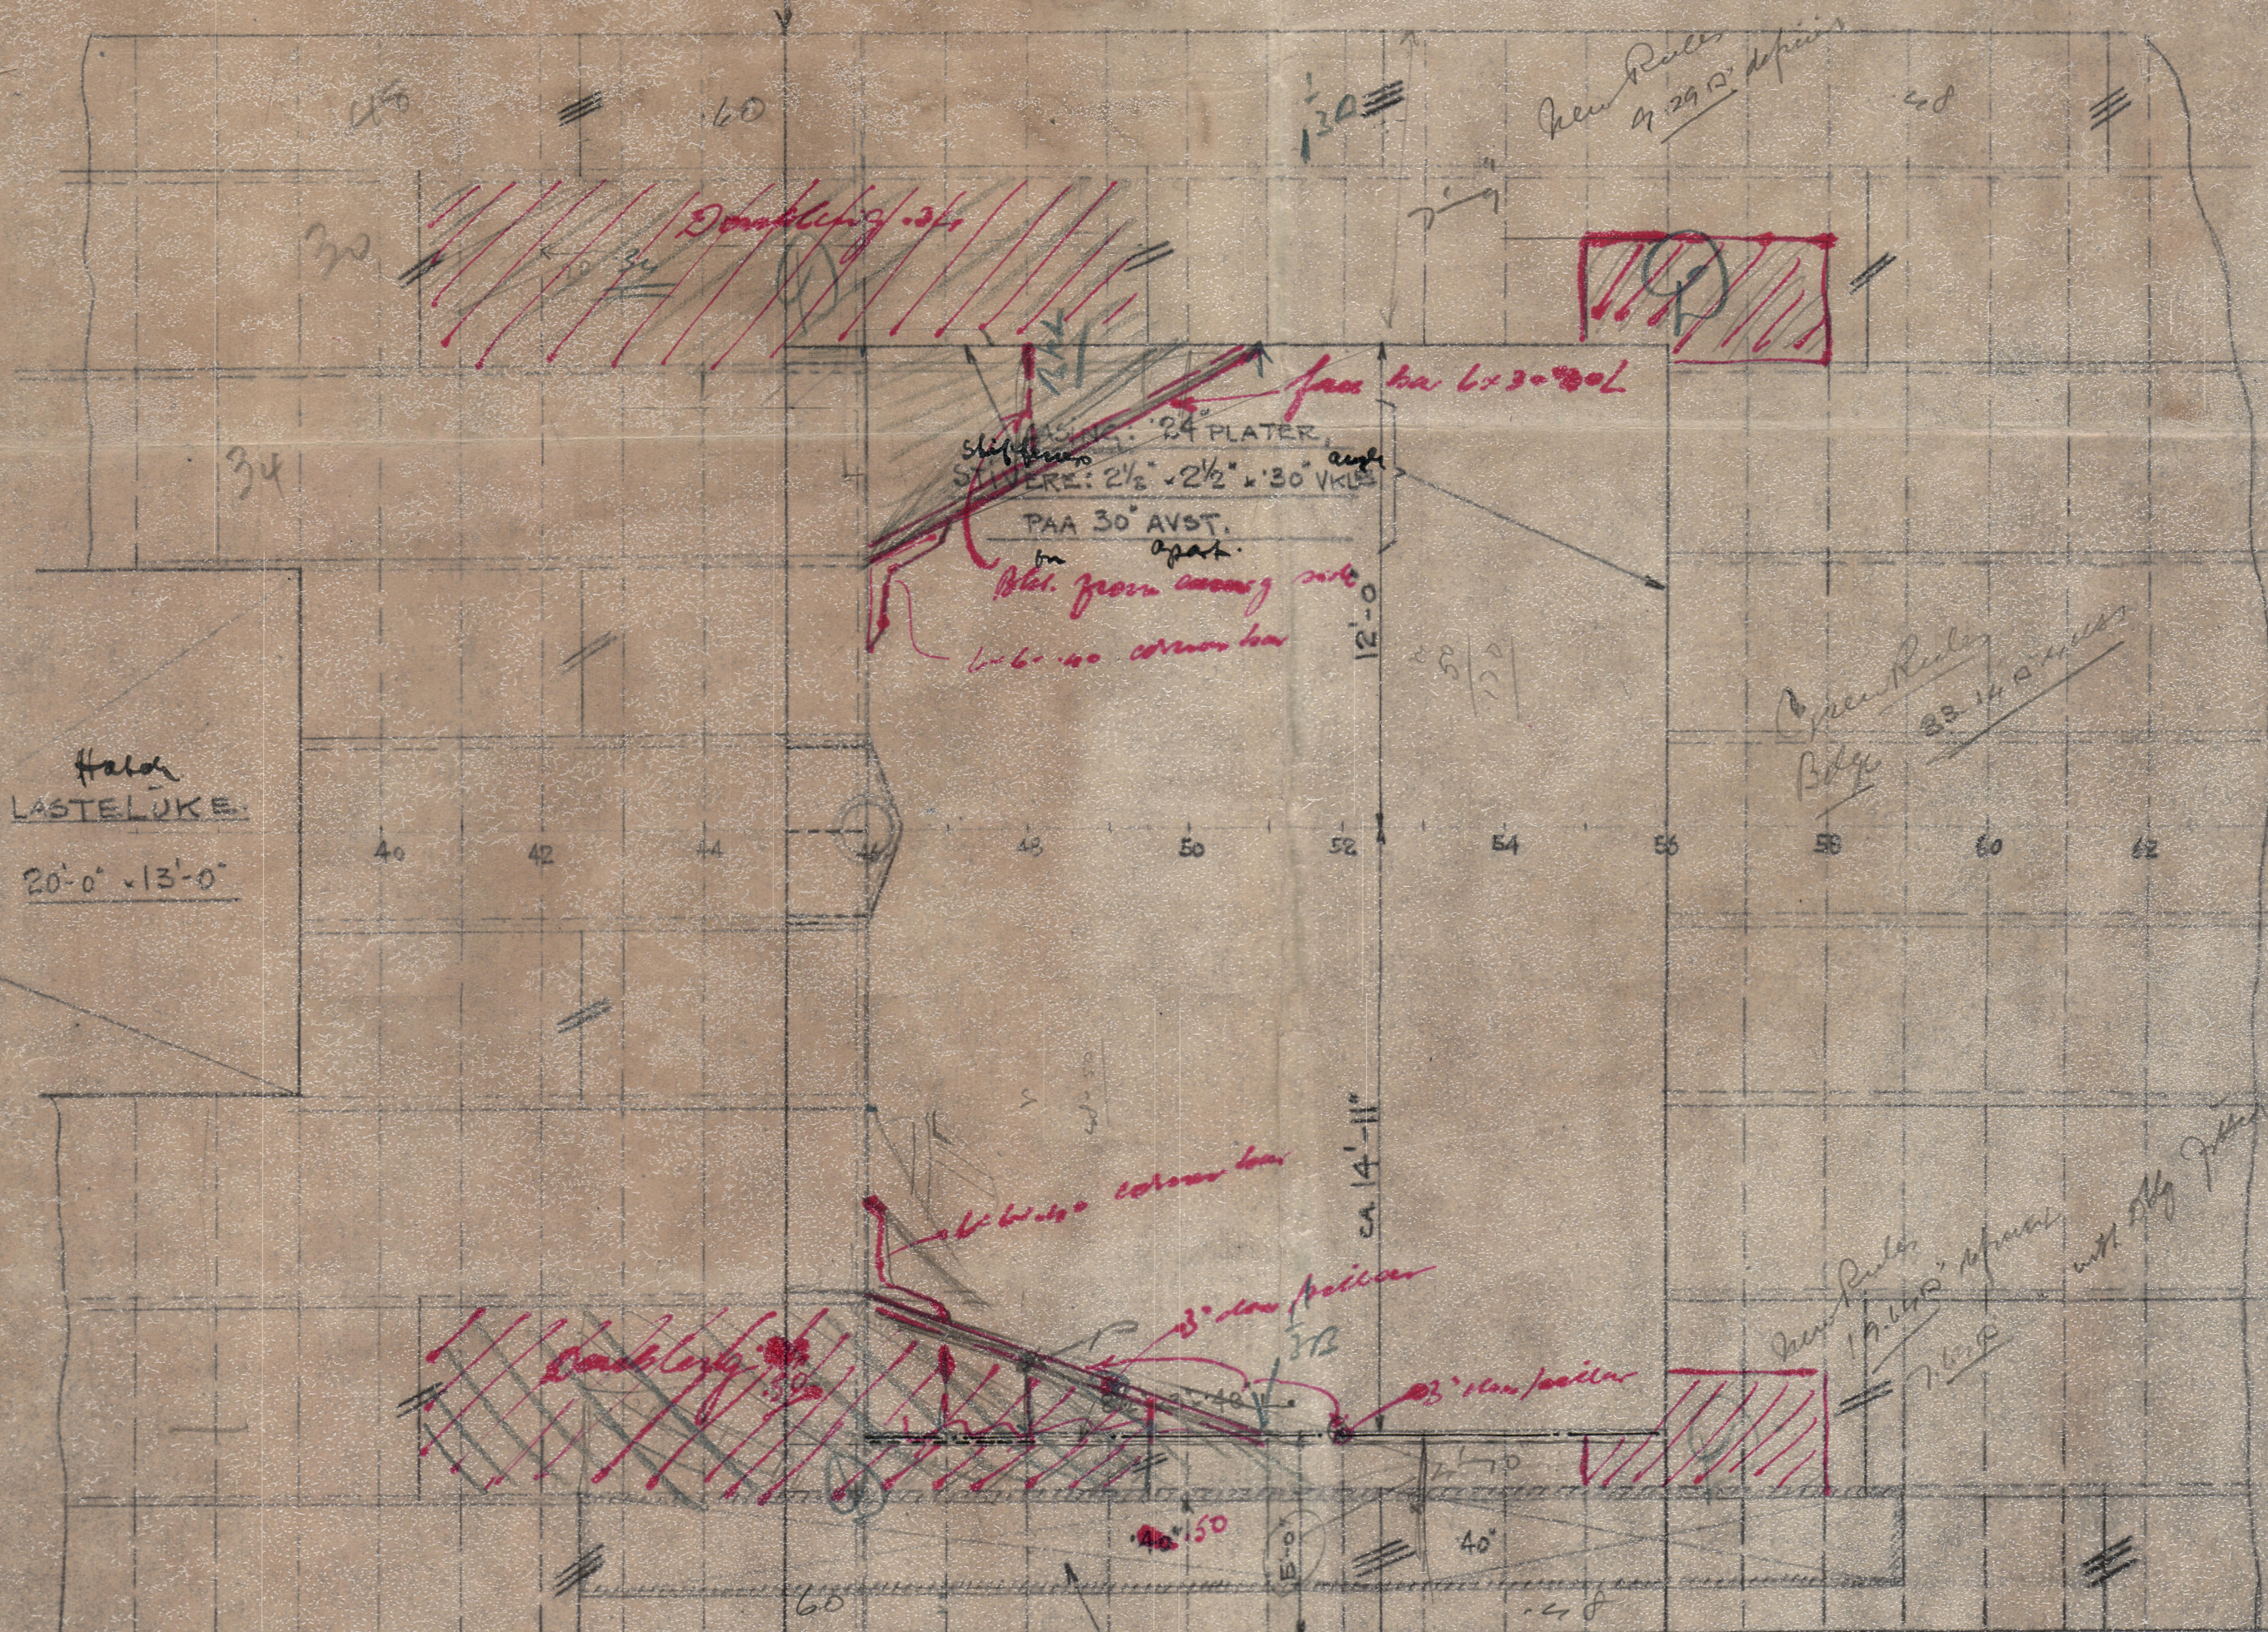

Frame no  
**SPANT 51.**  
(SEET AKTEN FRA).

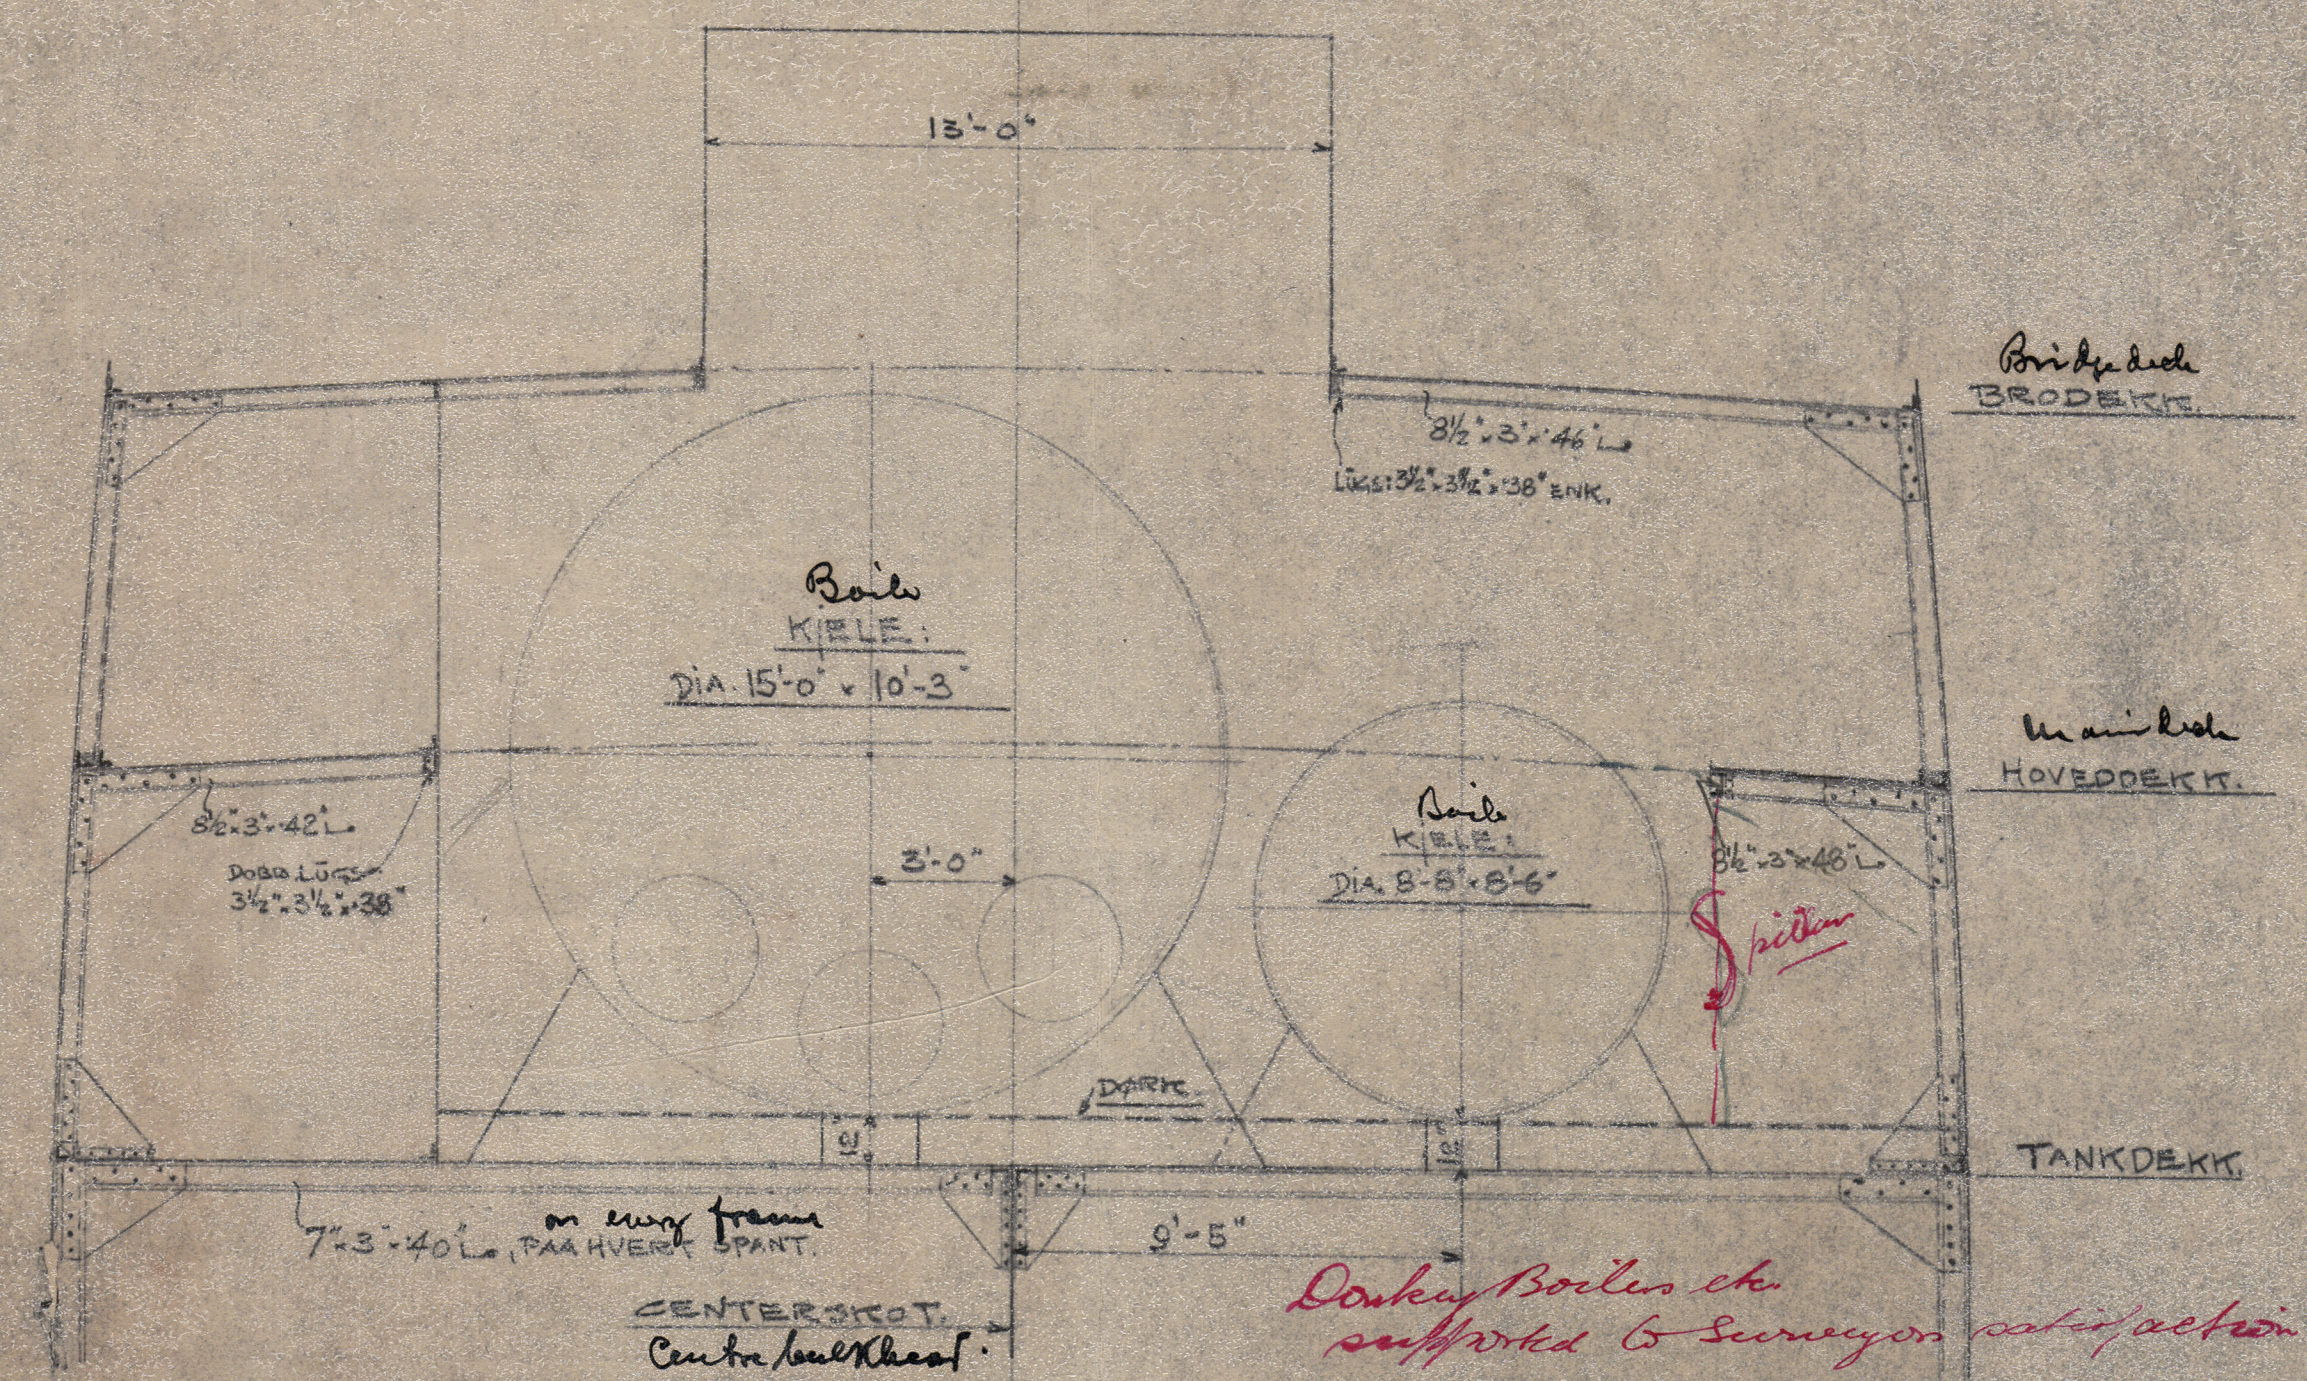

**PLAN AV TANKDEK.**

**1/2 \"GROSHOLM\"  
Plan of boiler.  
KIELE ARRANGEMENT.**

SKALA: 1/4\"/>



S.S. Pioneer (ex Stockholm)

Od. regt. No 3593

W473-0115

Stockholm



© 2019

Lloyd's Register  
Foundation