

Lloyd's Register of Shipping.

(Report on Vessel No. _____ Port _____)

No. 140

SHIP FORGINGS OR CASTINGS.

I have to report that the undermentioned ~~Iron or Steel Forgings or~~ castings, manufactured by M/s Strømmen Verktøjsfabrik of Strømmen for the Vessel No. _____, being built by Framnes Møb. Verktøjsfabrik of Landesjøen have been inspected by me as set forth below and found to be, so far as can be seen, sound and free from defects.

Forgings or Castings.

Lloyd's
- 1-25
No. 5764-5765
- P.E

Oslo, January 4th 1925


D. Gade & Per Geir Røhli

Shaft brackets

	STERN FRAME.	RUDDER FRAME.	STEM.
...	Steel		
...	Cast		
...	As per approv. plans		
on Inspection ...	Cast & rough finished		
Inspected	5/1 and 7/1/1925		
STINGS.			
Standard Test	Nº 5764 and Nº 5765		
Pieces.	↓	↓	
Test—	27.2	28.45	
square inch	37.6	30.	
per cent. ...	160°	160°	
ing Test—	10'	10'	
ore fracture	1/2	1/2	
om ground ...			
g Test—			
according to Rules			
and satisfactory ...			

SKETCHES OF FRAMES SHOWING POSITION AND DESCRIPTION OF WELDS OF FORGINGS.


* on examination of the shaft bracket, Nº 5764, at Framnes Møb. Verktøjsfabrik on the 28/1/1925, after the boss having been bored, a serious defect in the casting was found and same was rejected.

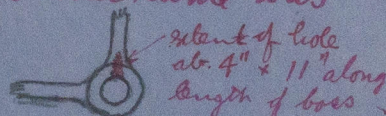

(if any chargeable) £ 46.00

to be paid at Oslo.

on, state whether scrap or puddled Iron. If of Steel, state whether made on the Open Hearth process.

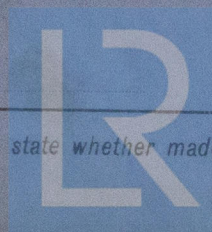

© 2019

Lloyd's Register
Foundation

W473-0185