


- M/S. "GROSHOLM." -

OWNER: SKIBS. A/S. GRIMSTAD. W. MARKUSSEN.
CLASSED: +100 A.I. LLOYDS STEEL.


DIMENSIONS:
LENGTH BETW. P.P. = 242'-2"
BREADTH MOULDED = 40'-0"
DEPTH = 23'-8"
HEIGHT OF POOP AND FORECASTLE = 7'-2"
BRIDGE = 7'-10"
DRAFT AT L.W.L. = 21'-8"
LIGHT W.L. =
REGISTERED TONNAGE: GROSS = 1734.20 NETT. = 1286.20

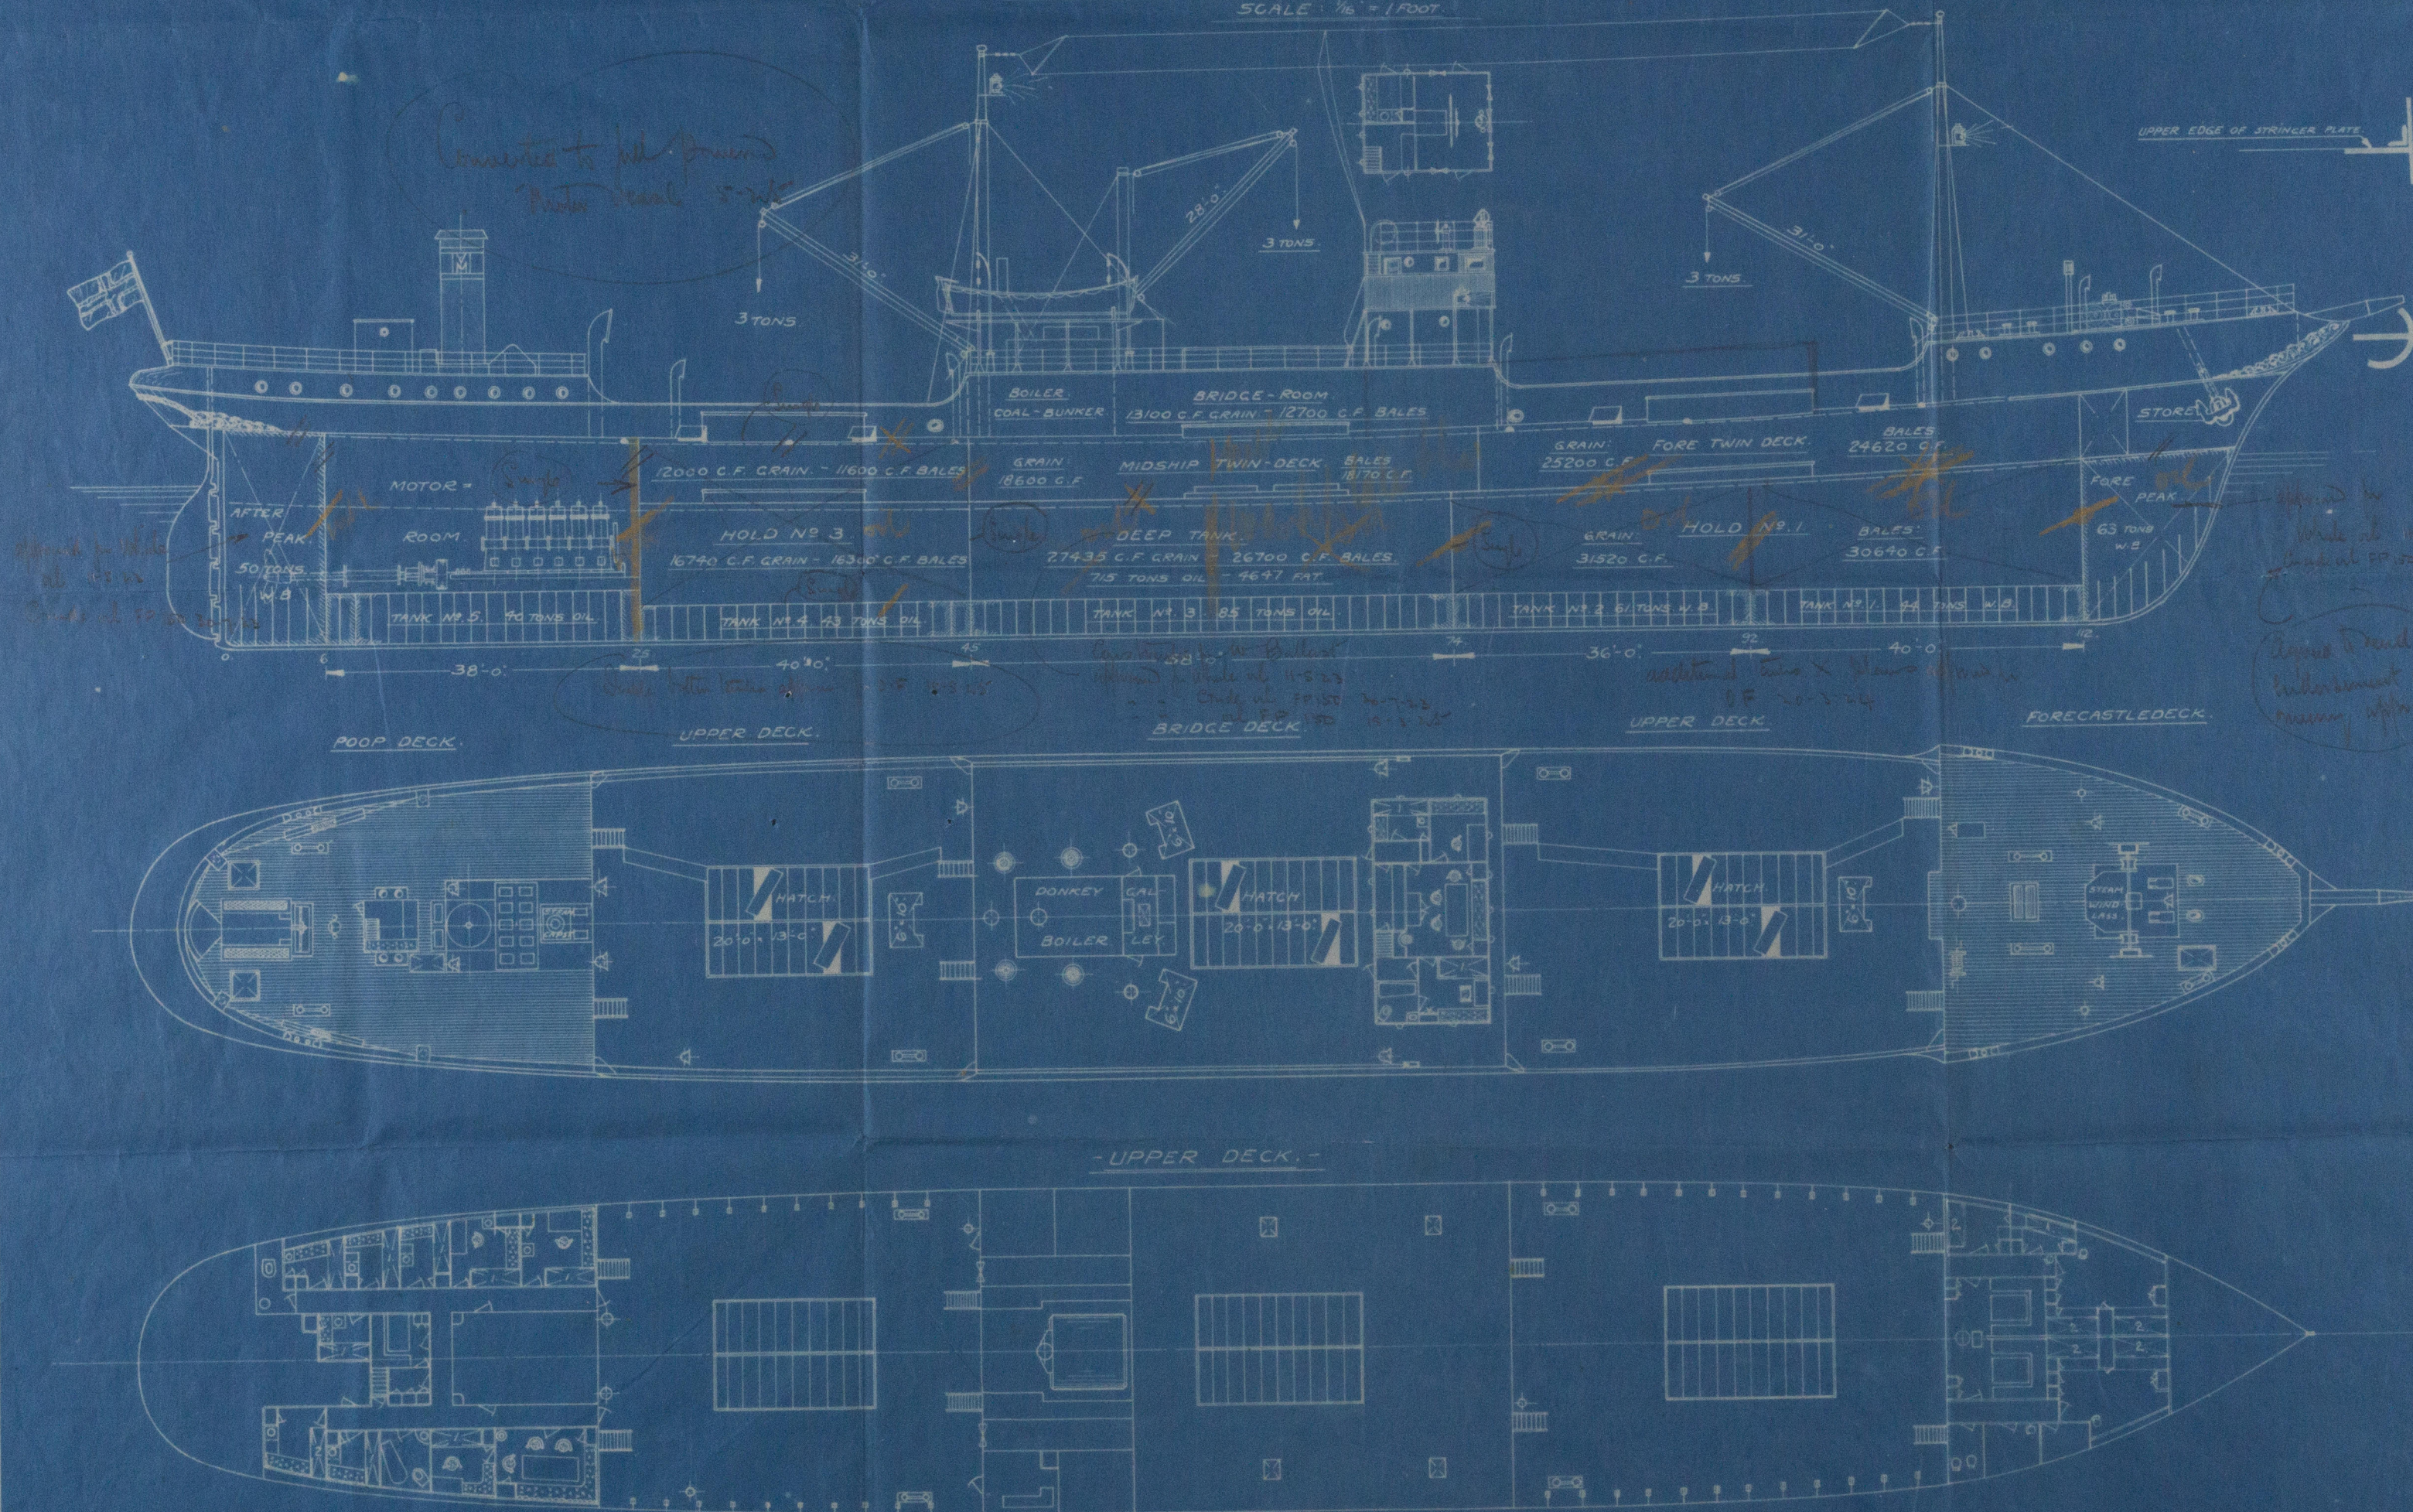

LOADING SCALE.					
FREE BOARD FEET	DRAUGHT FEET	DEADWEIGHT TONS	TONS PER INCH	SALT W. TONS	FRESH W. TONS
25					
24					
23	7.				
22					
21					
20	6.				
19					
18					
17					
16	5.				
15					
14					
13	4.				
12					
11					
10	3.				
9					

TRACING No. 4567.
SKUF No. 17.

BUILT BY: ANTIKESKAPET RØBYHAVNS SKIBSVERFT. 1920. THESE PARTICULARS ARE BELIEVED TO BE CORRECT BUT ARE NOT GUARANTEED.

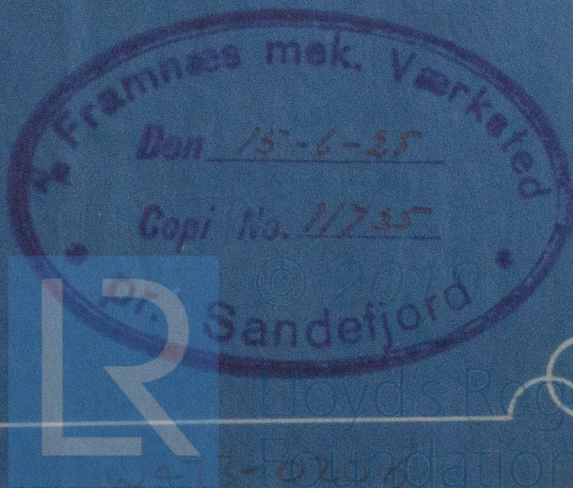

Profile

RELIANT

W473-0206



© 2019

Lloyd's Register
Foundation