


N^o 1507.



52

EXTENSION OF CENTRE SKEG.



Scale. 1" = 1 Foot.

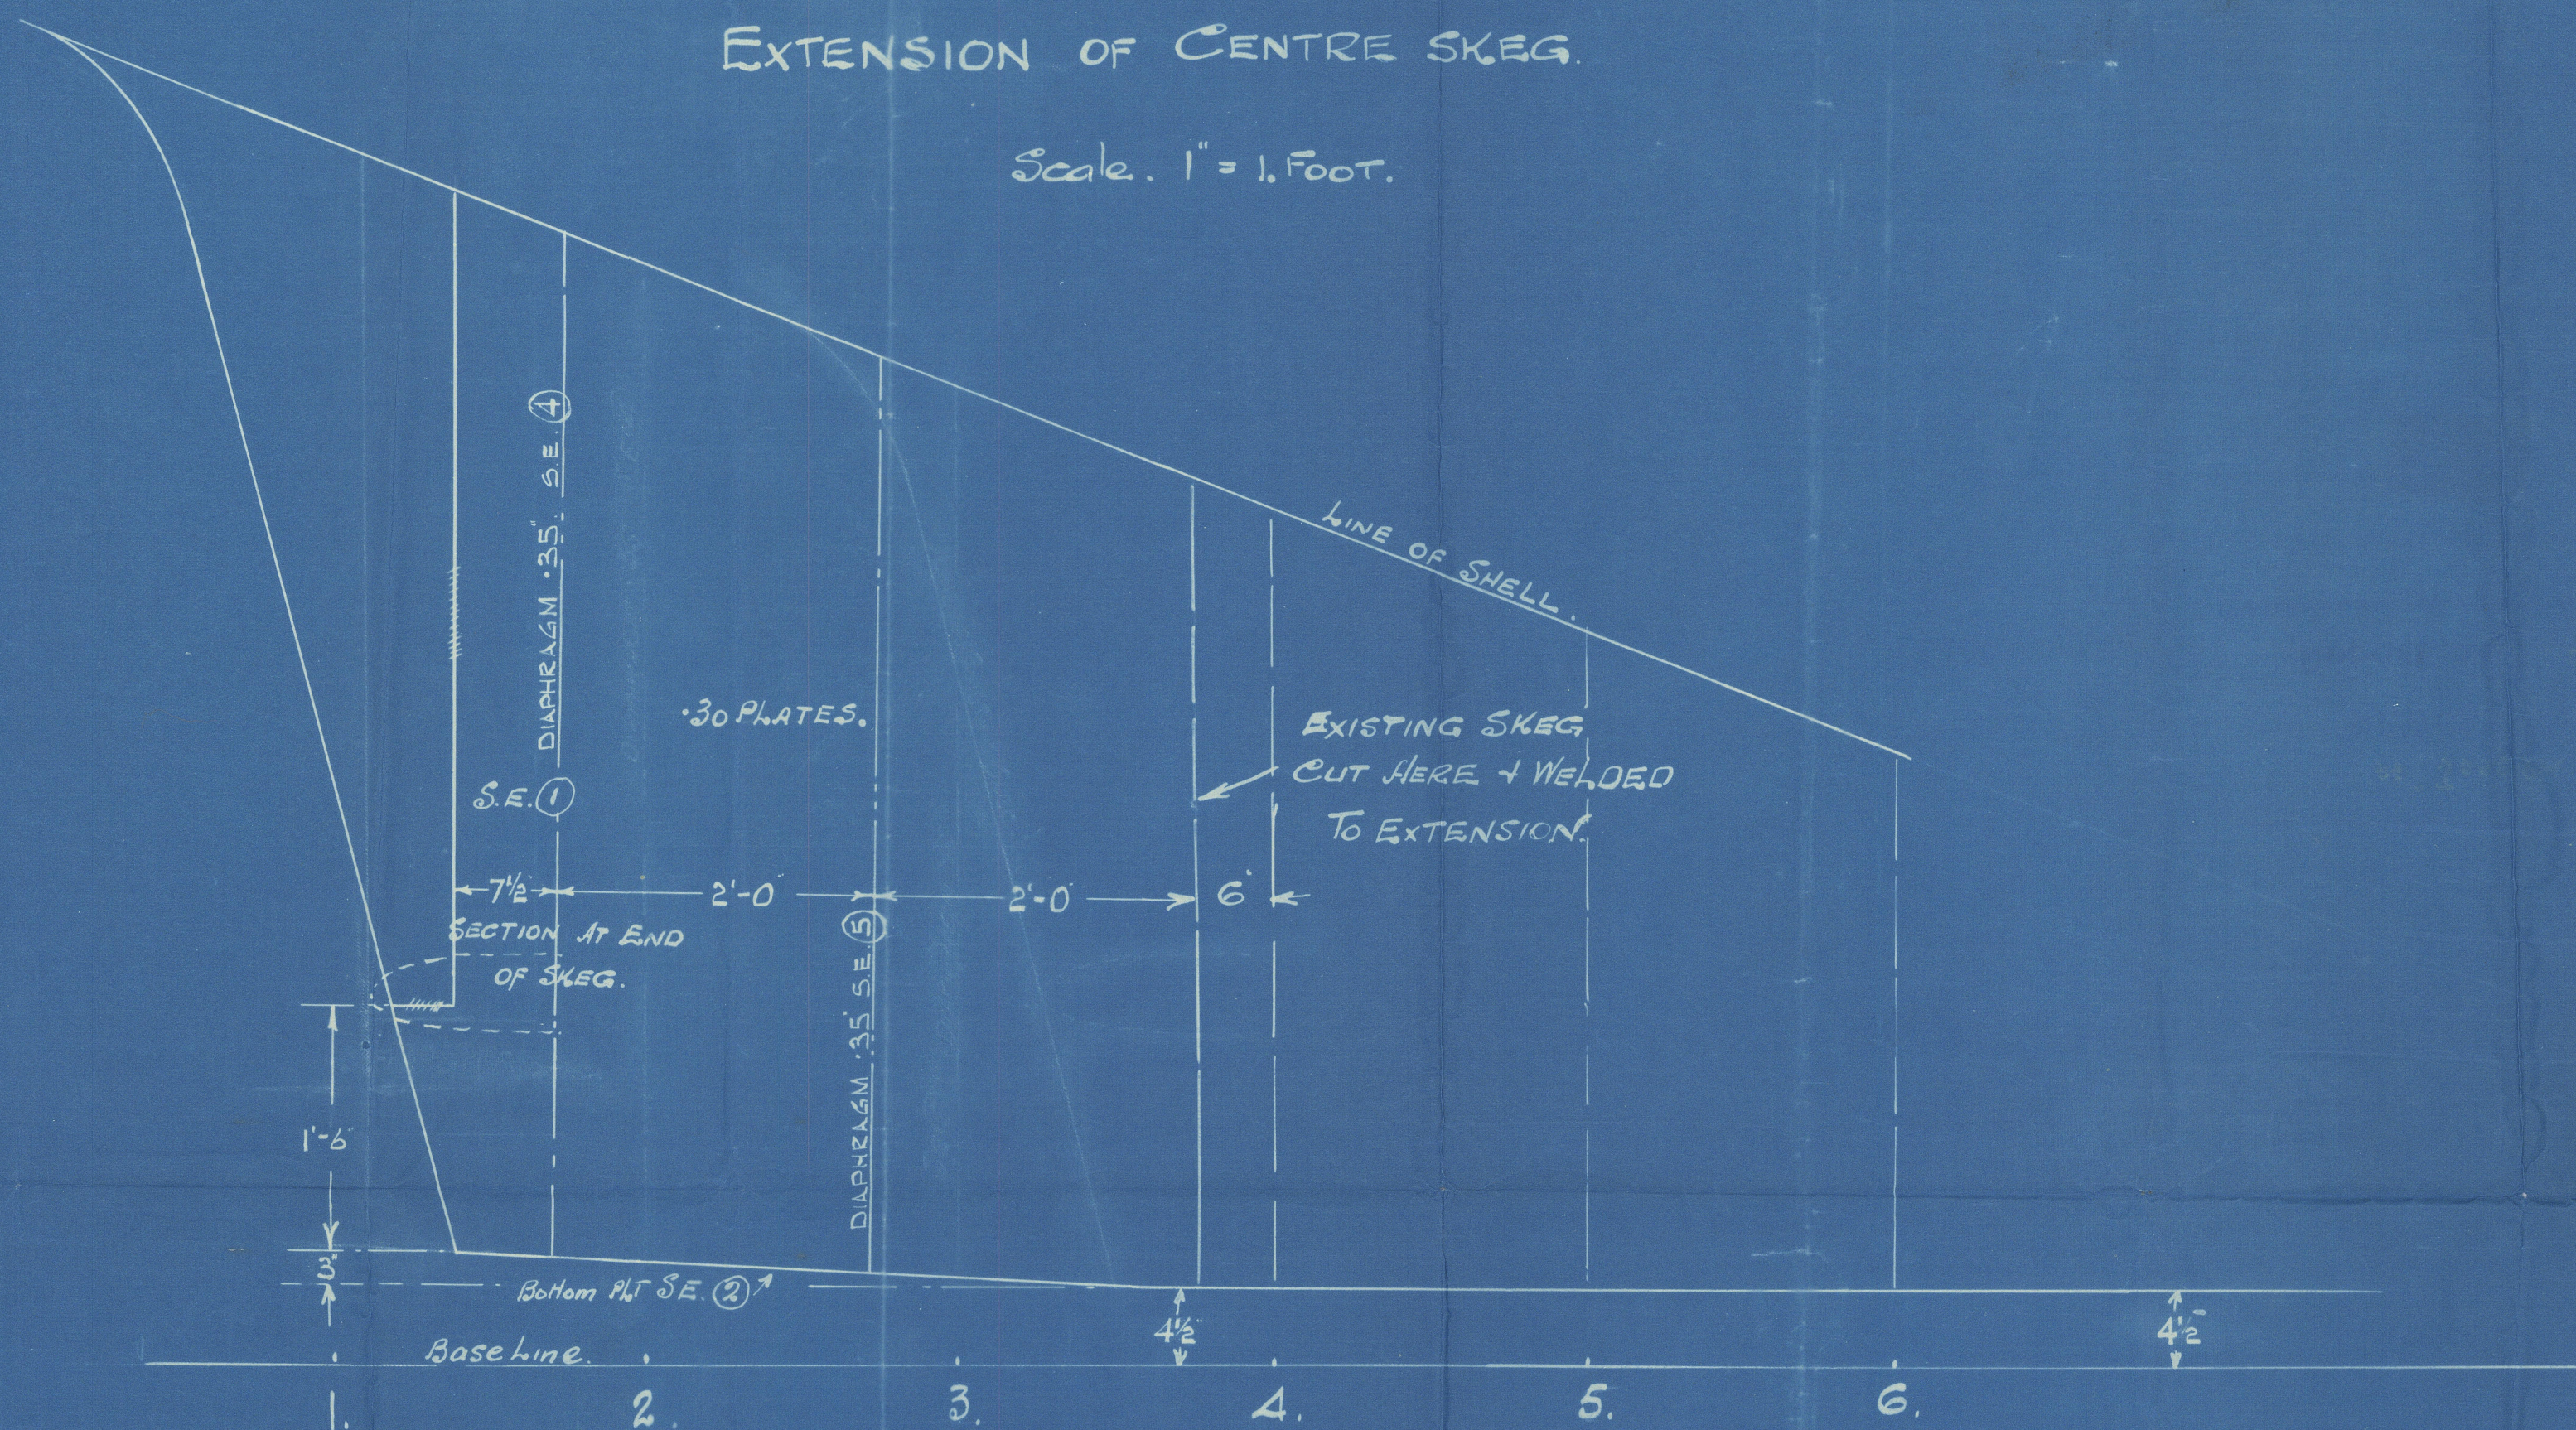

Arrangement of SKEG ON BOSSING.

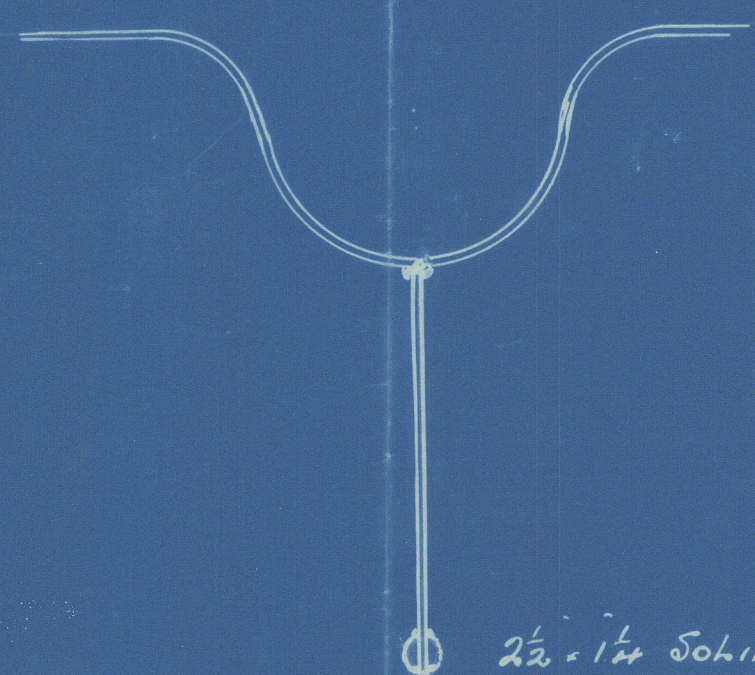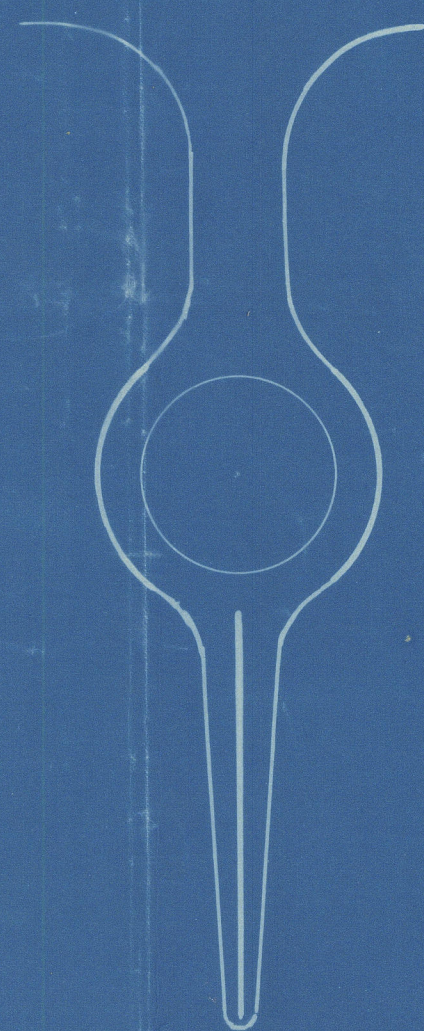

SECTION AT C.F.R.

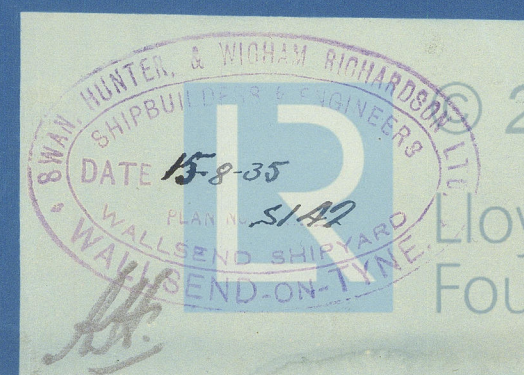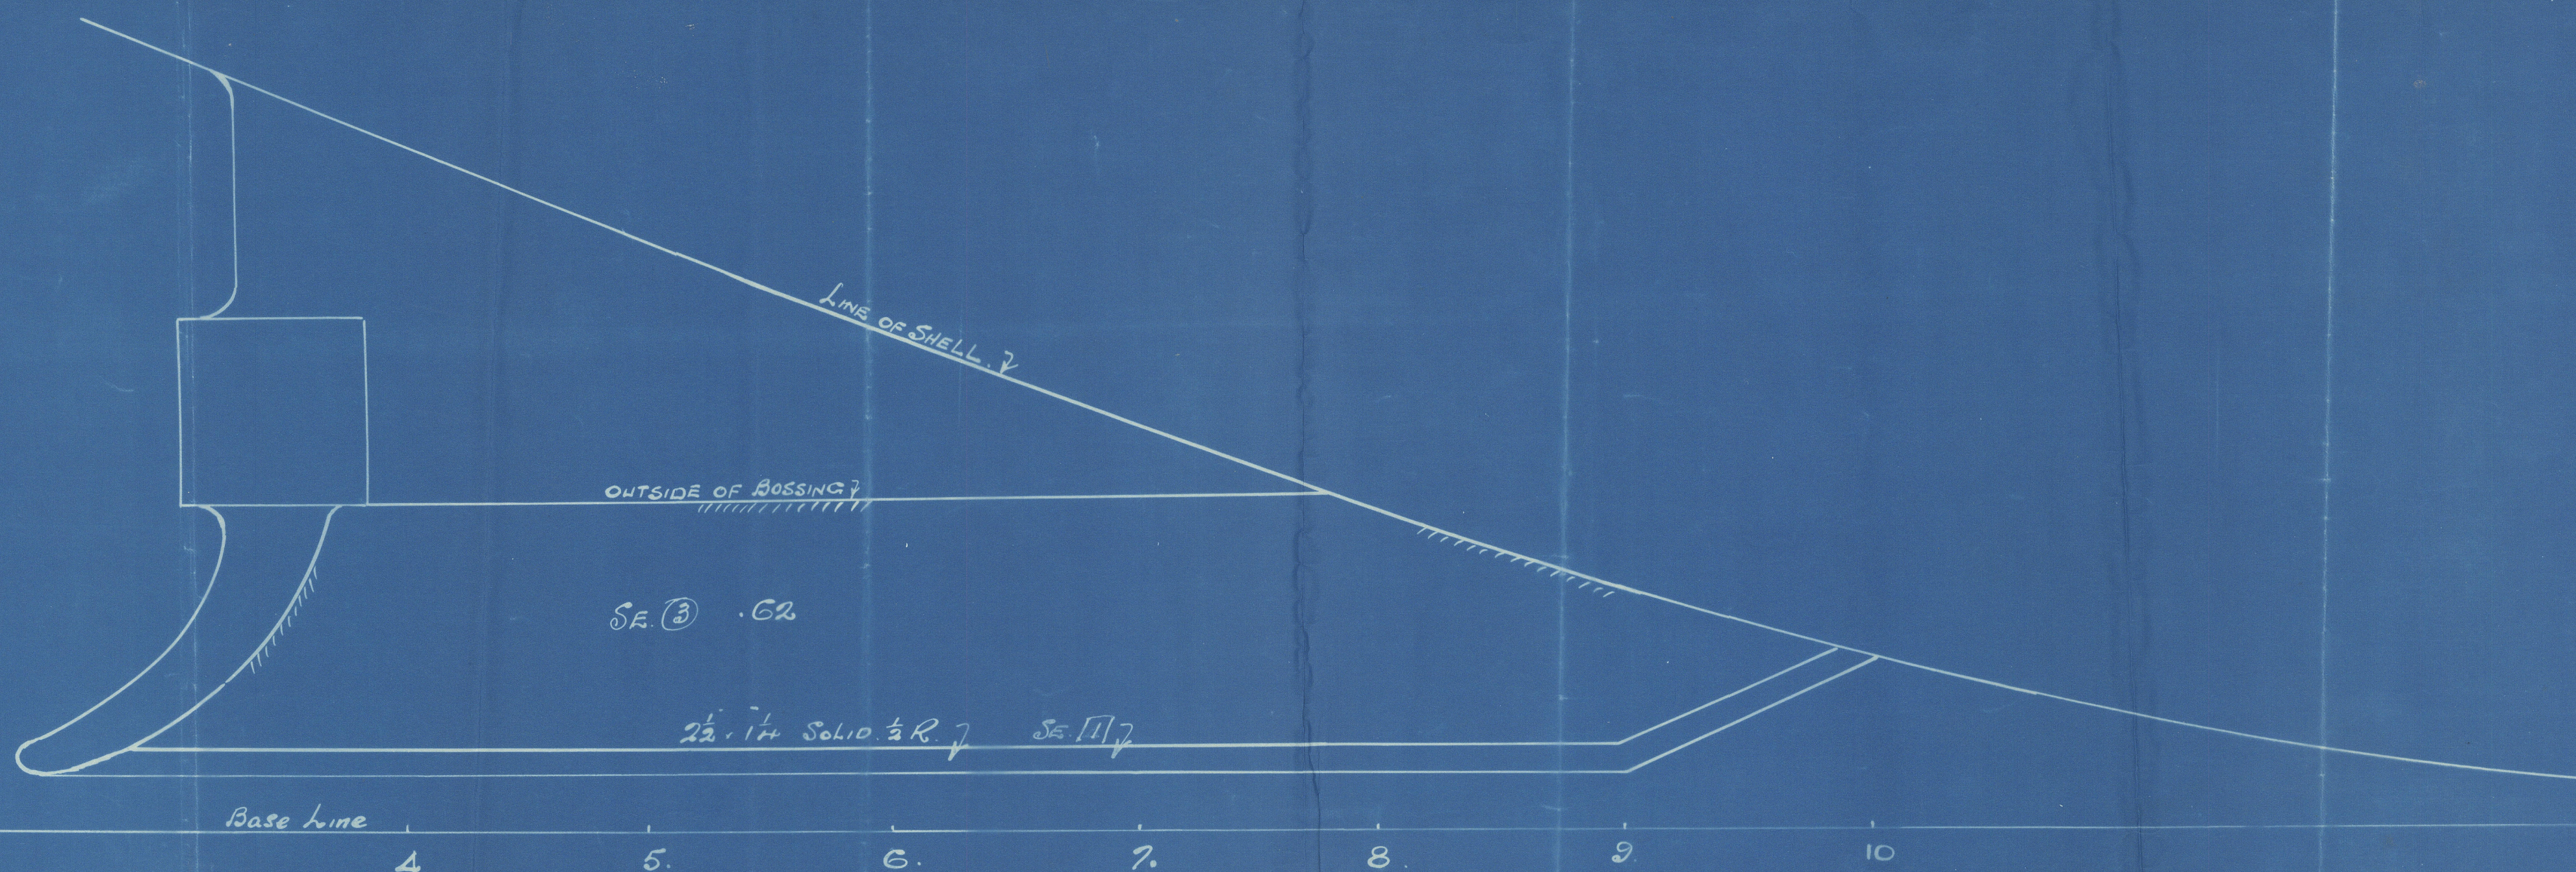

2019

Lloyd's Register Foundation

5210-5125

JOSEPH MEDILL

1871


SKEGS.

99 "JOSEPH MEDILL"
NEWCASTLE ON TYNE.

Report No. 92860



W475-0125

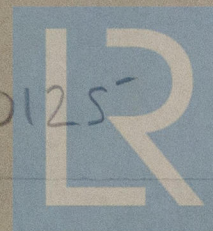

© 2019

Lloyd's Register
Foundation