
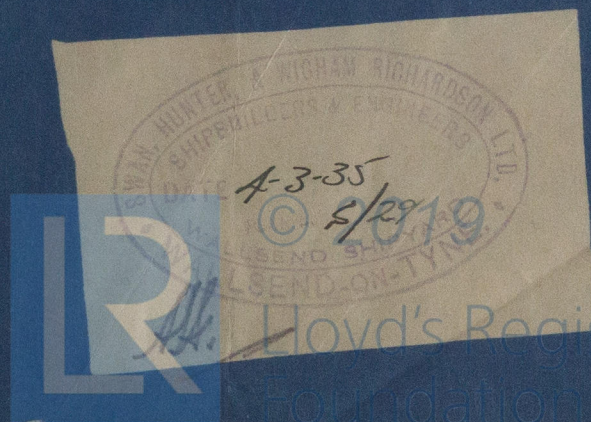


Nº 1507 SHIP

PROPOSED MODIFIED BEAM KNEES TO FACILITATE
THE STOWAGE OF ROLLS OF PAPER.

SCALE $\frac{1}{2}$ " = 1 FOOT.

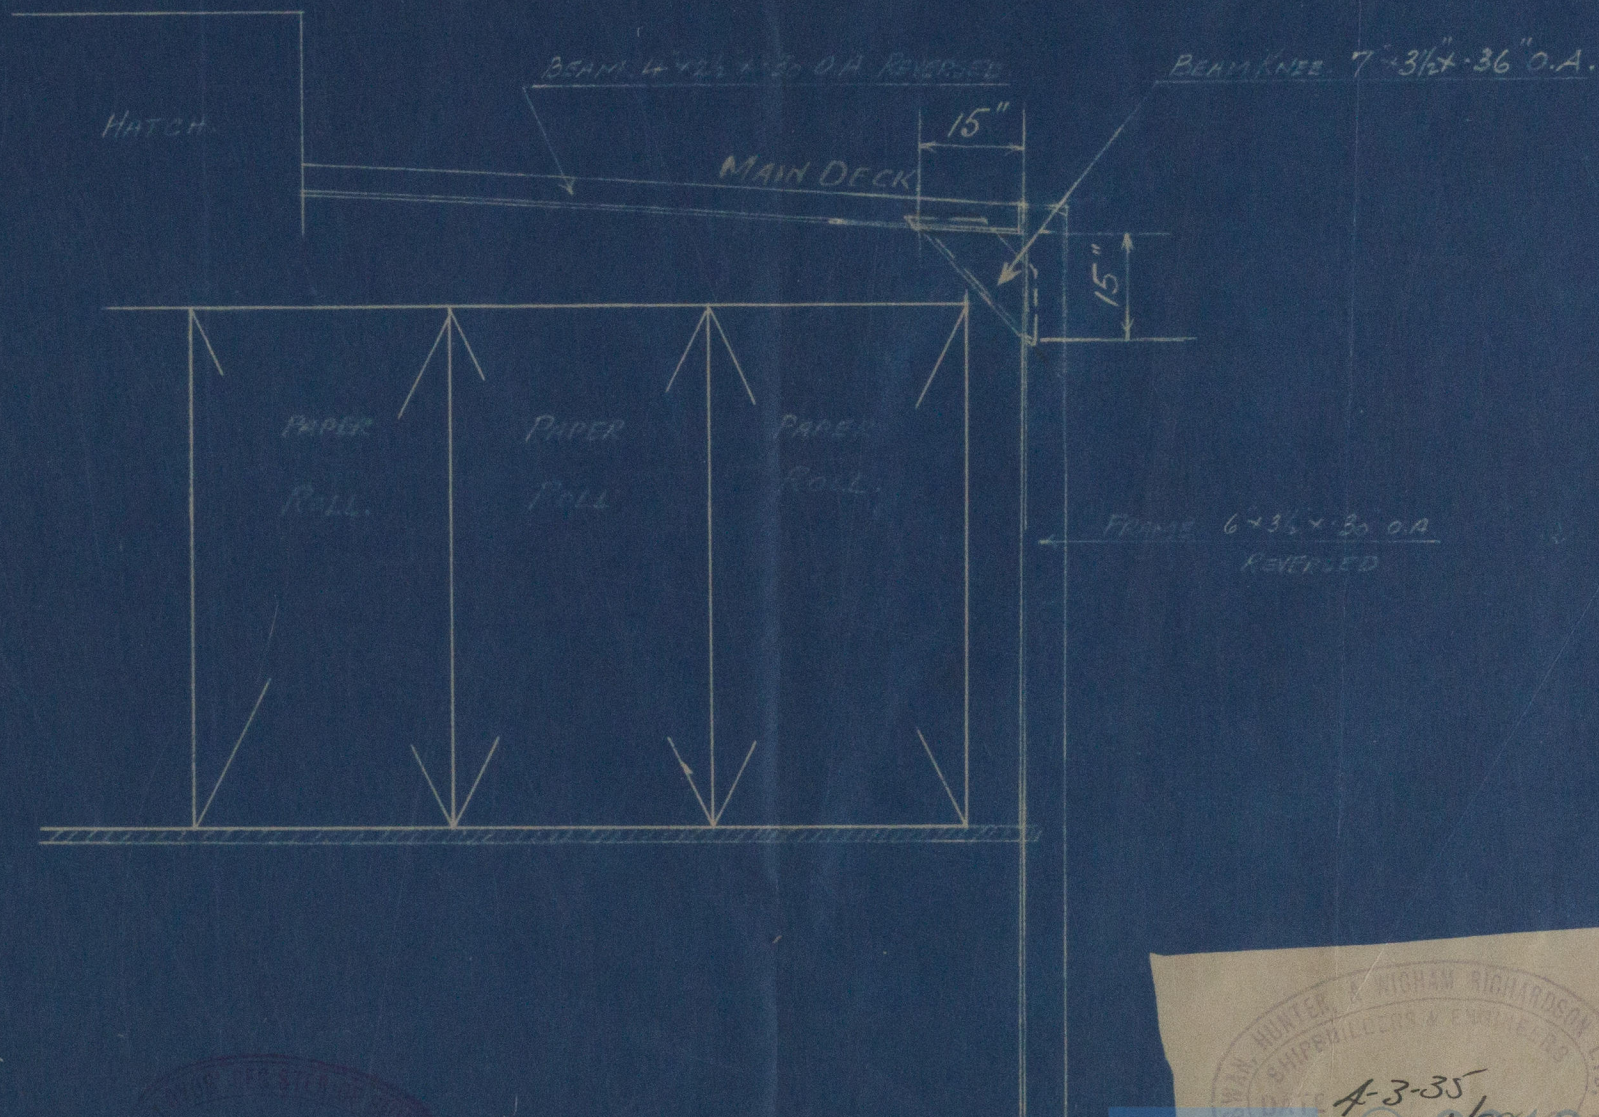

(10

Sw.

Swan Hunter's No 1507

modified Beam Knees

ms. "JOSEPH MEDILL"

NEWCASTLE ON TYNE.

Report No. 92860.



© 2019

Lloyd's Register
Foundation

W475-0148