

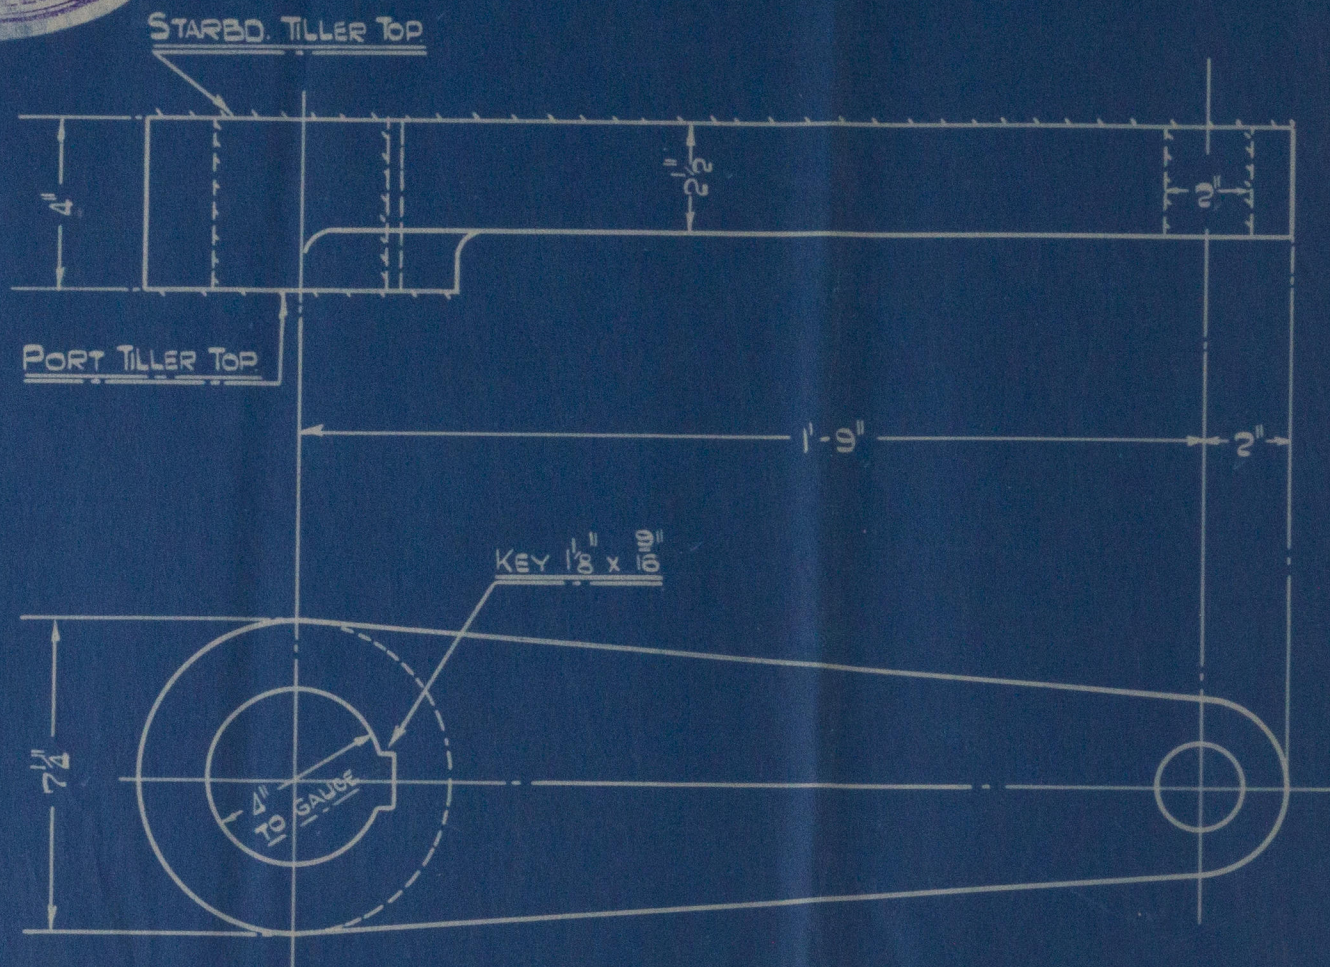


# WHEEL, LINKS ETC. HYD. GEAR NO 1087.


SCALE 3" = 1 FOOT.

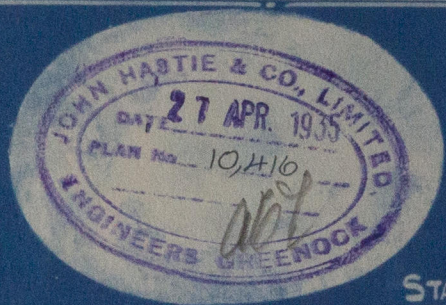


FORGED STEEL TILLER  
2, OFF

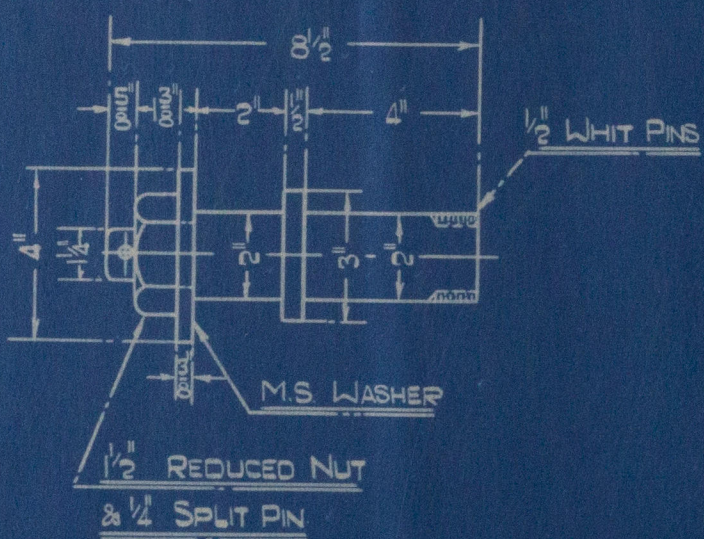


MILD STEEL PIN - 2, OFF

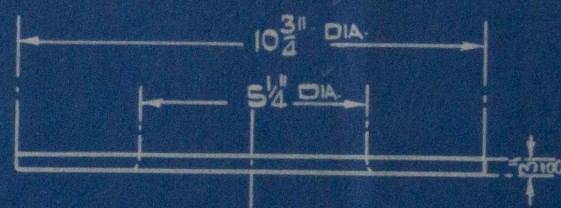


GUNMETAL RUDDERSTOCK RING  
PATT NO 5681 MOD. ONE OFF

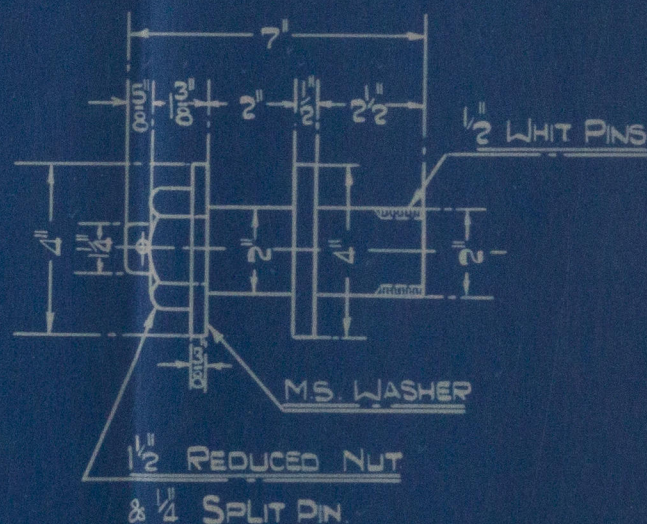


MILD STEEL PIN - 2, OFF

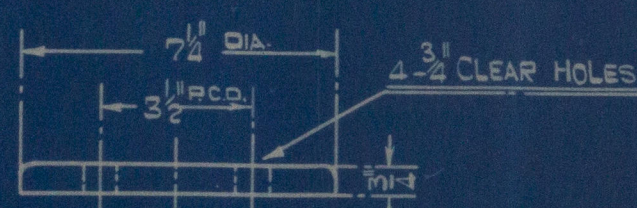


MILD STEEL RUDDERSTOCK CAP  
ONE OFF

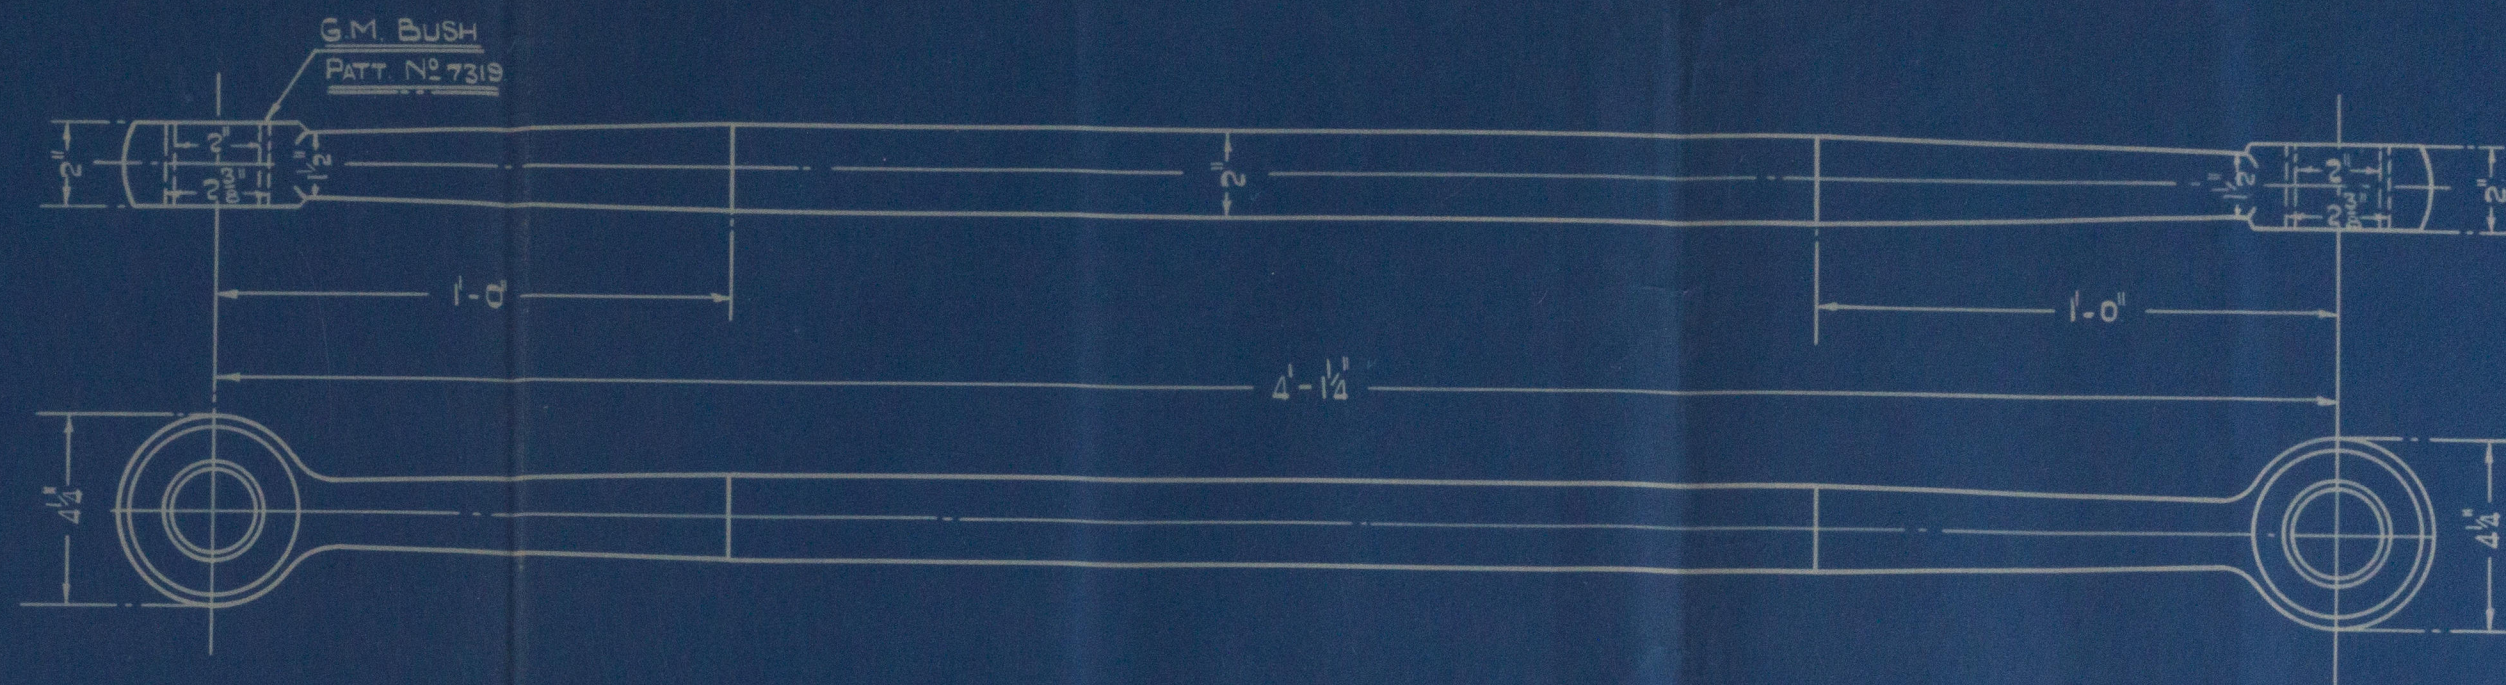


FORGED STEEL LINKS - 2, OFF

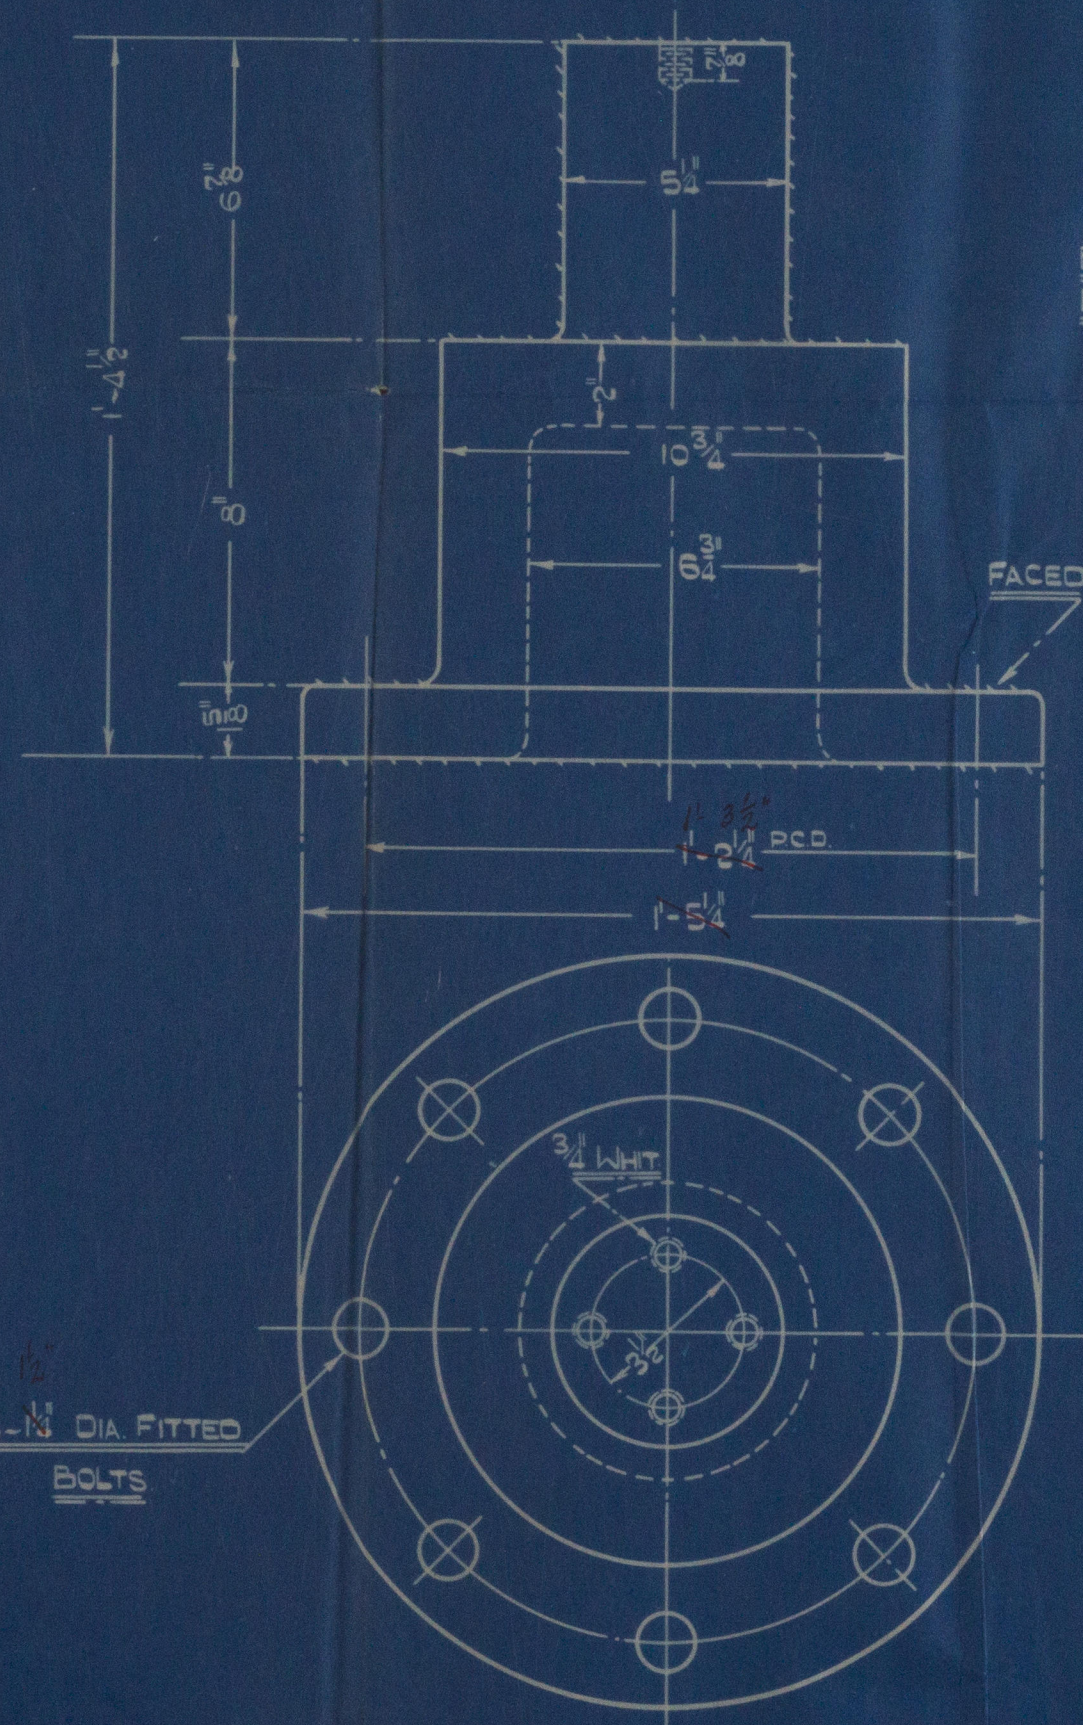

CAST STEEL DUMMY RUDDERSTOCK  
PATT NO 9266. ONE OFF

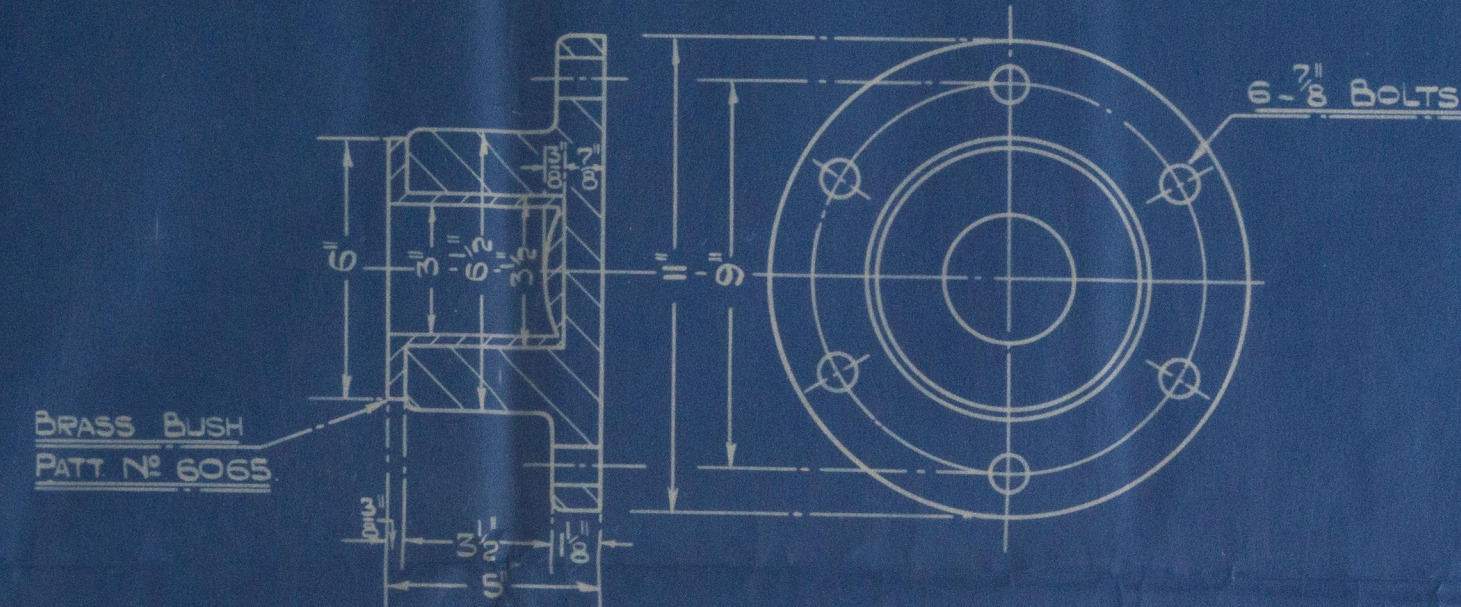

CAST IRON FOOTSTEP BEARING  
PATT NO 6324 - ONE OFF

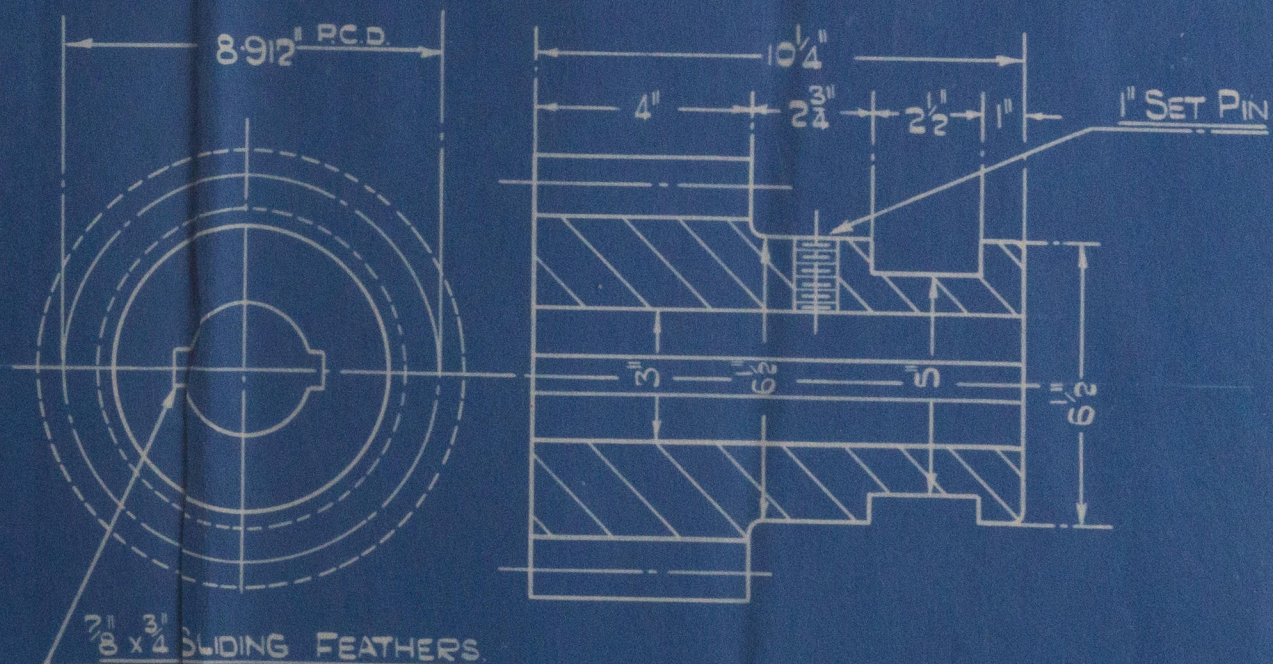

CAST STEEL PINION - PATTERN NO 6320  
14 TEETH, 2" PITCH, 8-9/12 P.C.D.

APPROVED





20

Swan Hunters No 1507

---


Tiller 62

---

MS "JOSEPH MEDILL"  
NEWCASTLE ON TYNE.

Report No. 92860.

---

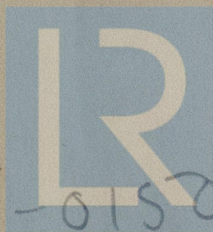

© 2019

Lloyd's Register  
Foundation

W475-0150