



PROFILE No 116.

418-0 x 54-0 x 32-2 M¹⁰

SCALE $\frac{1}{8}$ = ONE FOOT

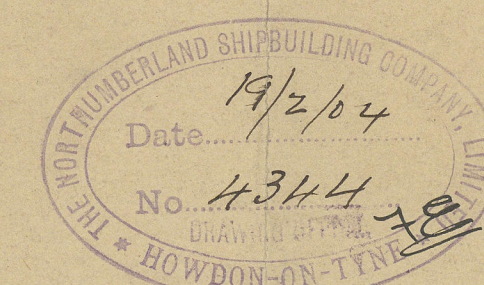

26.2.04
9.3.04
18.3.04
28.3.04
18.5.04
7.4.04
18.10.04

 





19/2/04
9/3/04

Walthamstow S. Co.
S. S. No 116.

Profile

418'0" x 54'0" x 32'2" Mth.


3 Ok. Rule.

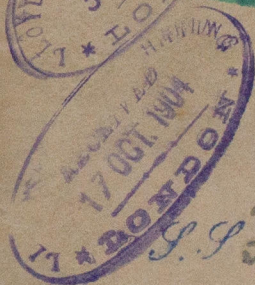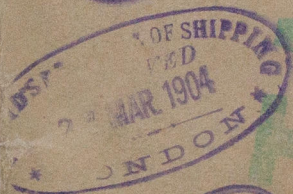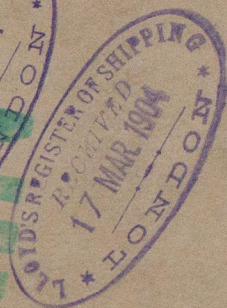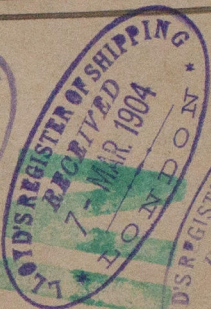

S. P. Filippa Autelli

Newcastle Report

No 48057

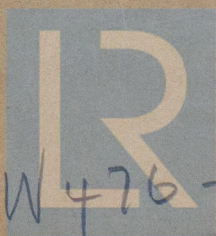

© 2019

Lloyd's Register
Foundation