

# Single Screw Motor Tanker.


Class: Lloyds Register + 100 A1 „Carrying Petroleum in Bulk“

Principal Dimensions:  
Length (Loyds) 495'  
Breadth moulded 67'  
Depth moulded 34' 3"  
Draught 37' 6 3/4"

Scale 1:200  
(Sections 1:50)

Scanling Numerals.  
First Longitudinal Number 16913  
Second " 50078  
L:D = 14.49

Deutsche Werft AG  
Hamburg.

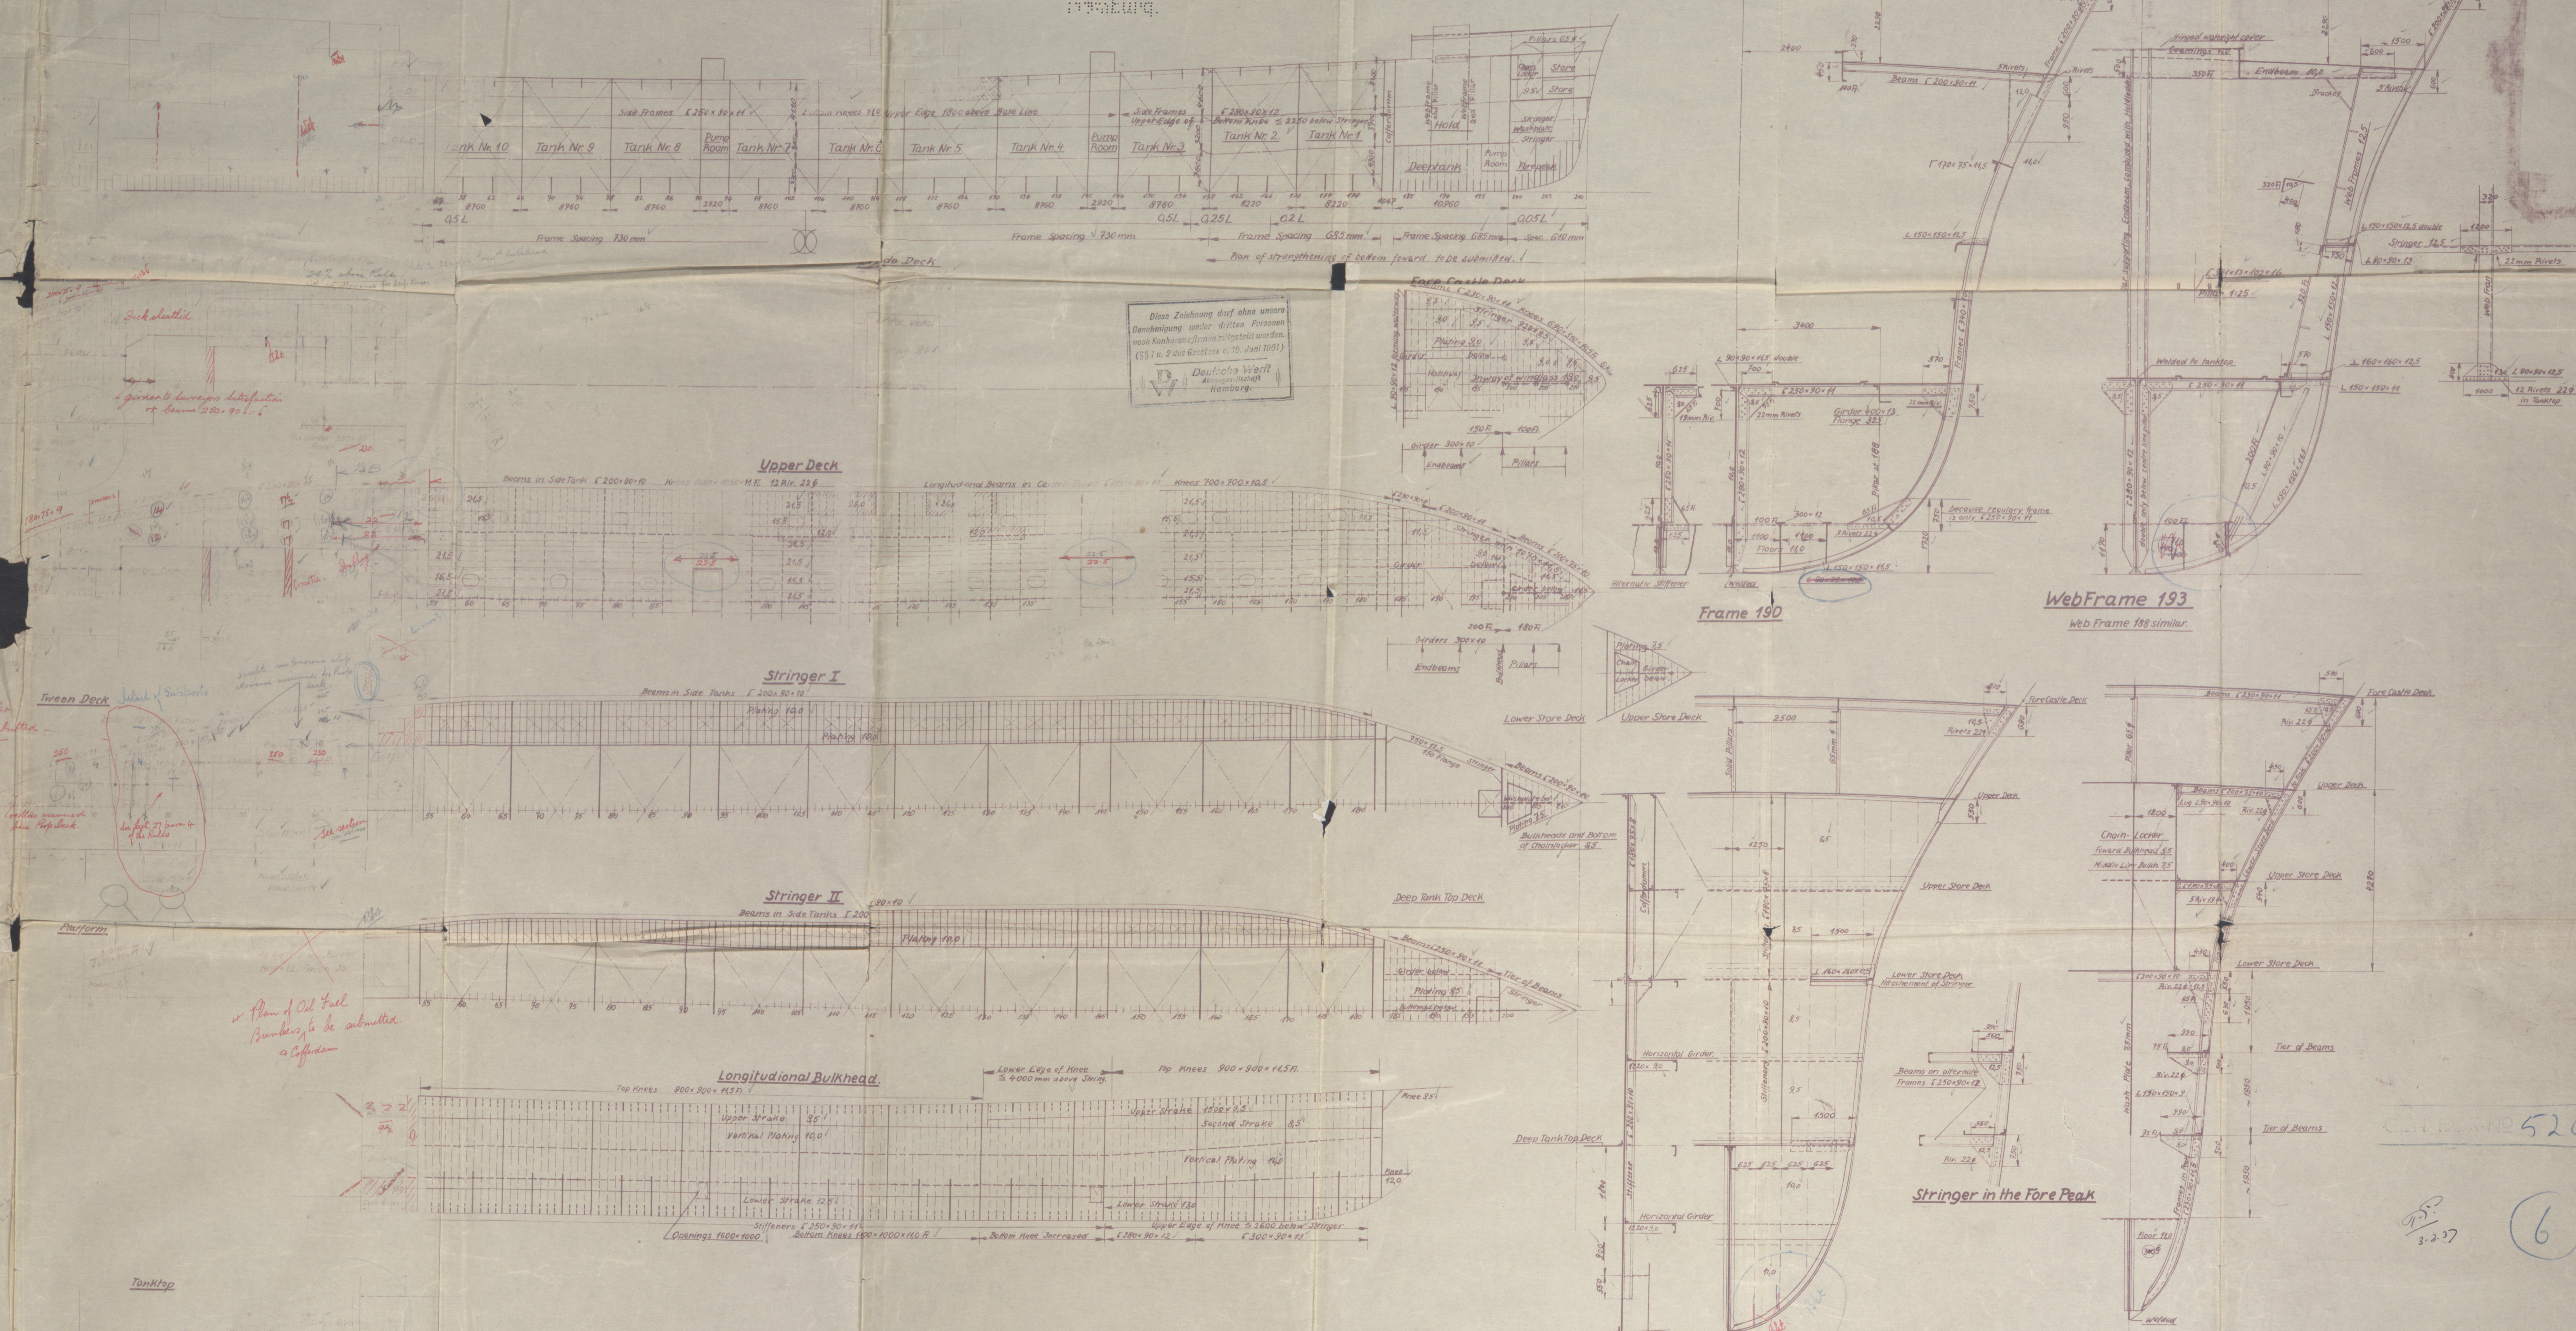






Handwritten note: "520"

Handwritten note: "6"

Profile and Decks

1:200  
S.E. 3

W477-0008

Profile & Becks.  
Deutsche Werft's Yard  
Nos 201/4.  
Hq. letter 20.2.37.

~~201 Inverliffey~~  
~~202 Inverdargh~~  
203 Inversuir  
204 Inveralen

WRECK DAY 168  
SECTION 1

Retam

W477-0008



© 2020

Lloyd's Register  
Foundation