


MATEN IN   VOLGENS GAT IN ROER

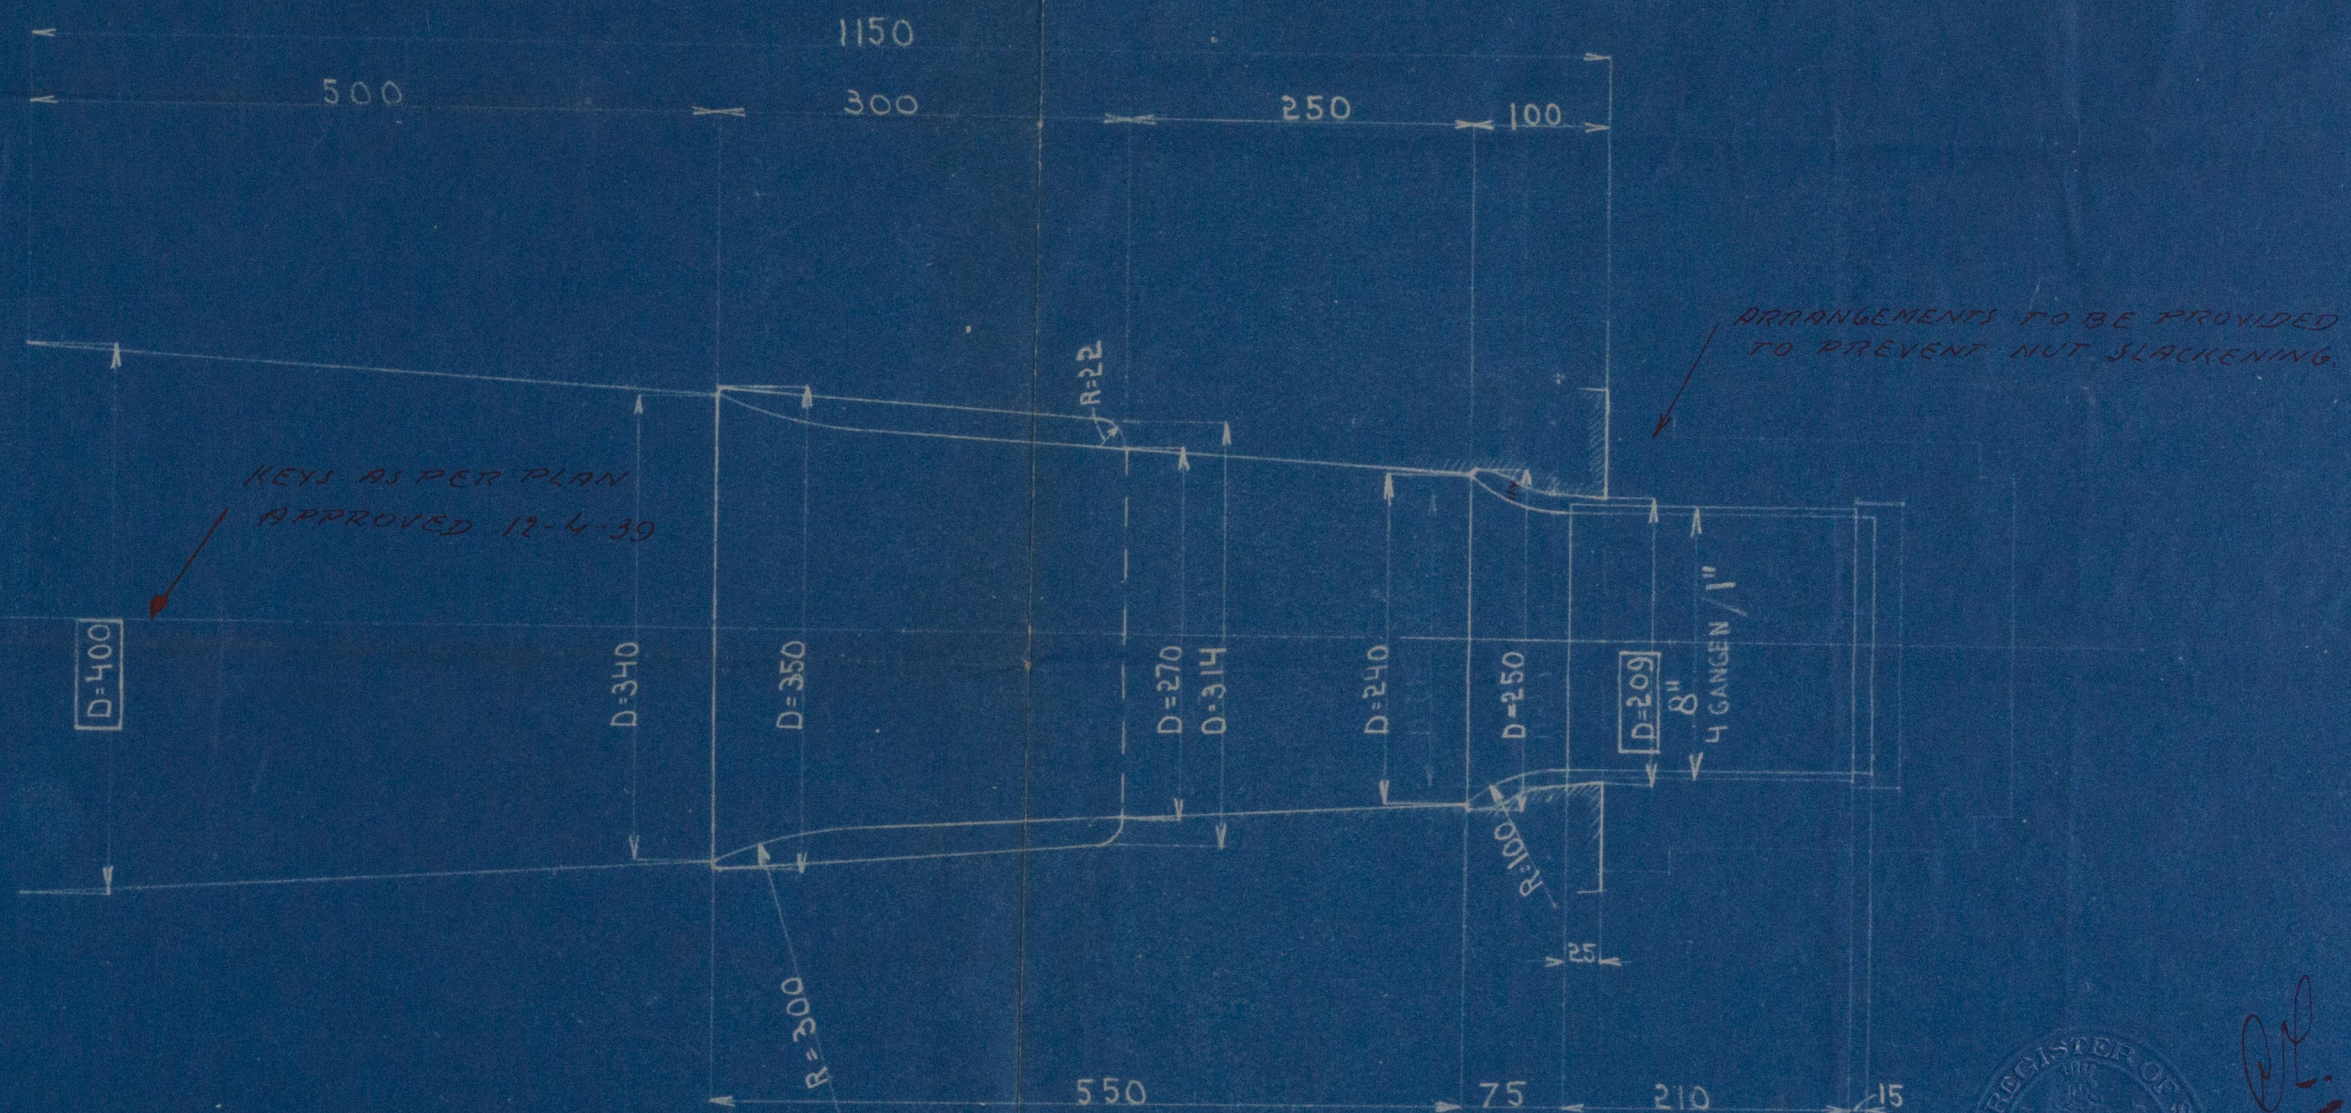

ROERKONING

WUZIGING TEEK 1840 S.

SCHAAL 1:5

NEDERLANDSCHE DOK MIJ NV AMSTERDAM

TEEK 4W40616



23-8-39

1000-814M



St. Simon Bolivar,  
Ans 75915.  
Rudder Main Piece.



© 2019

Lloyd's Register  
Foundation

W478-0007